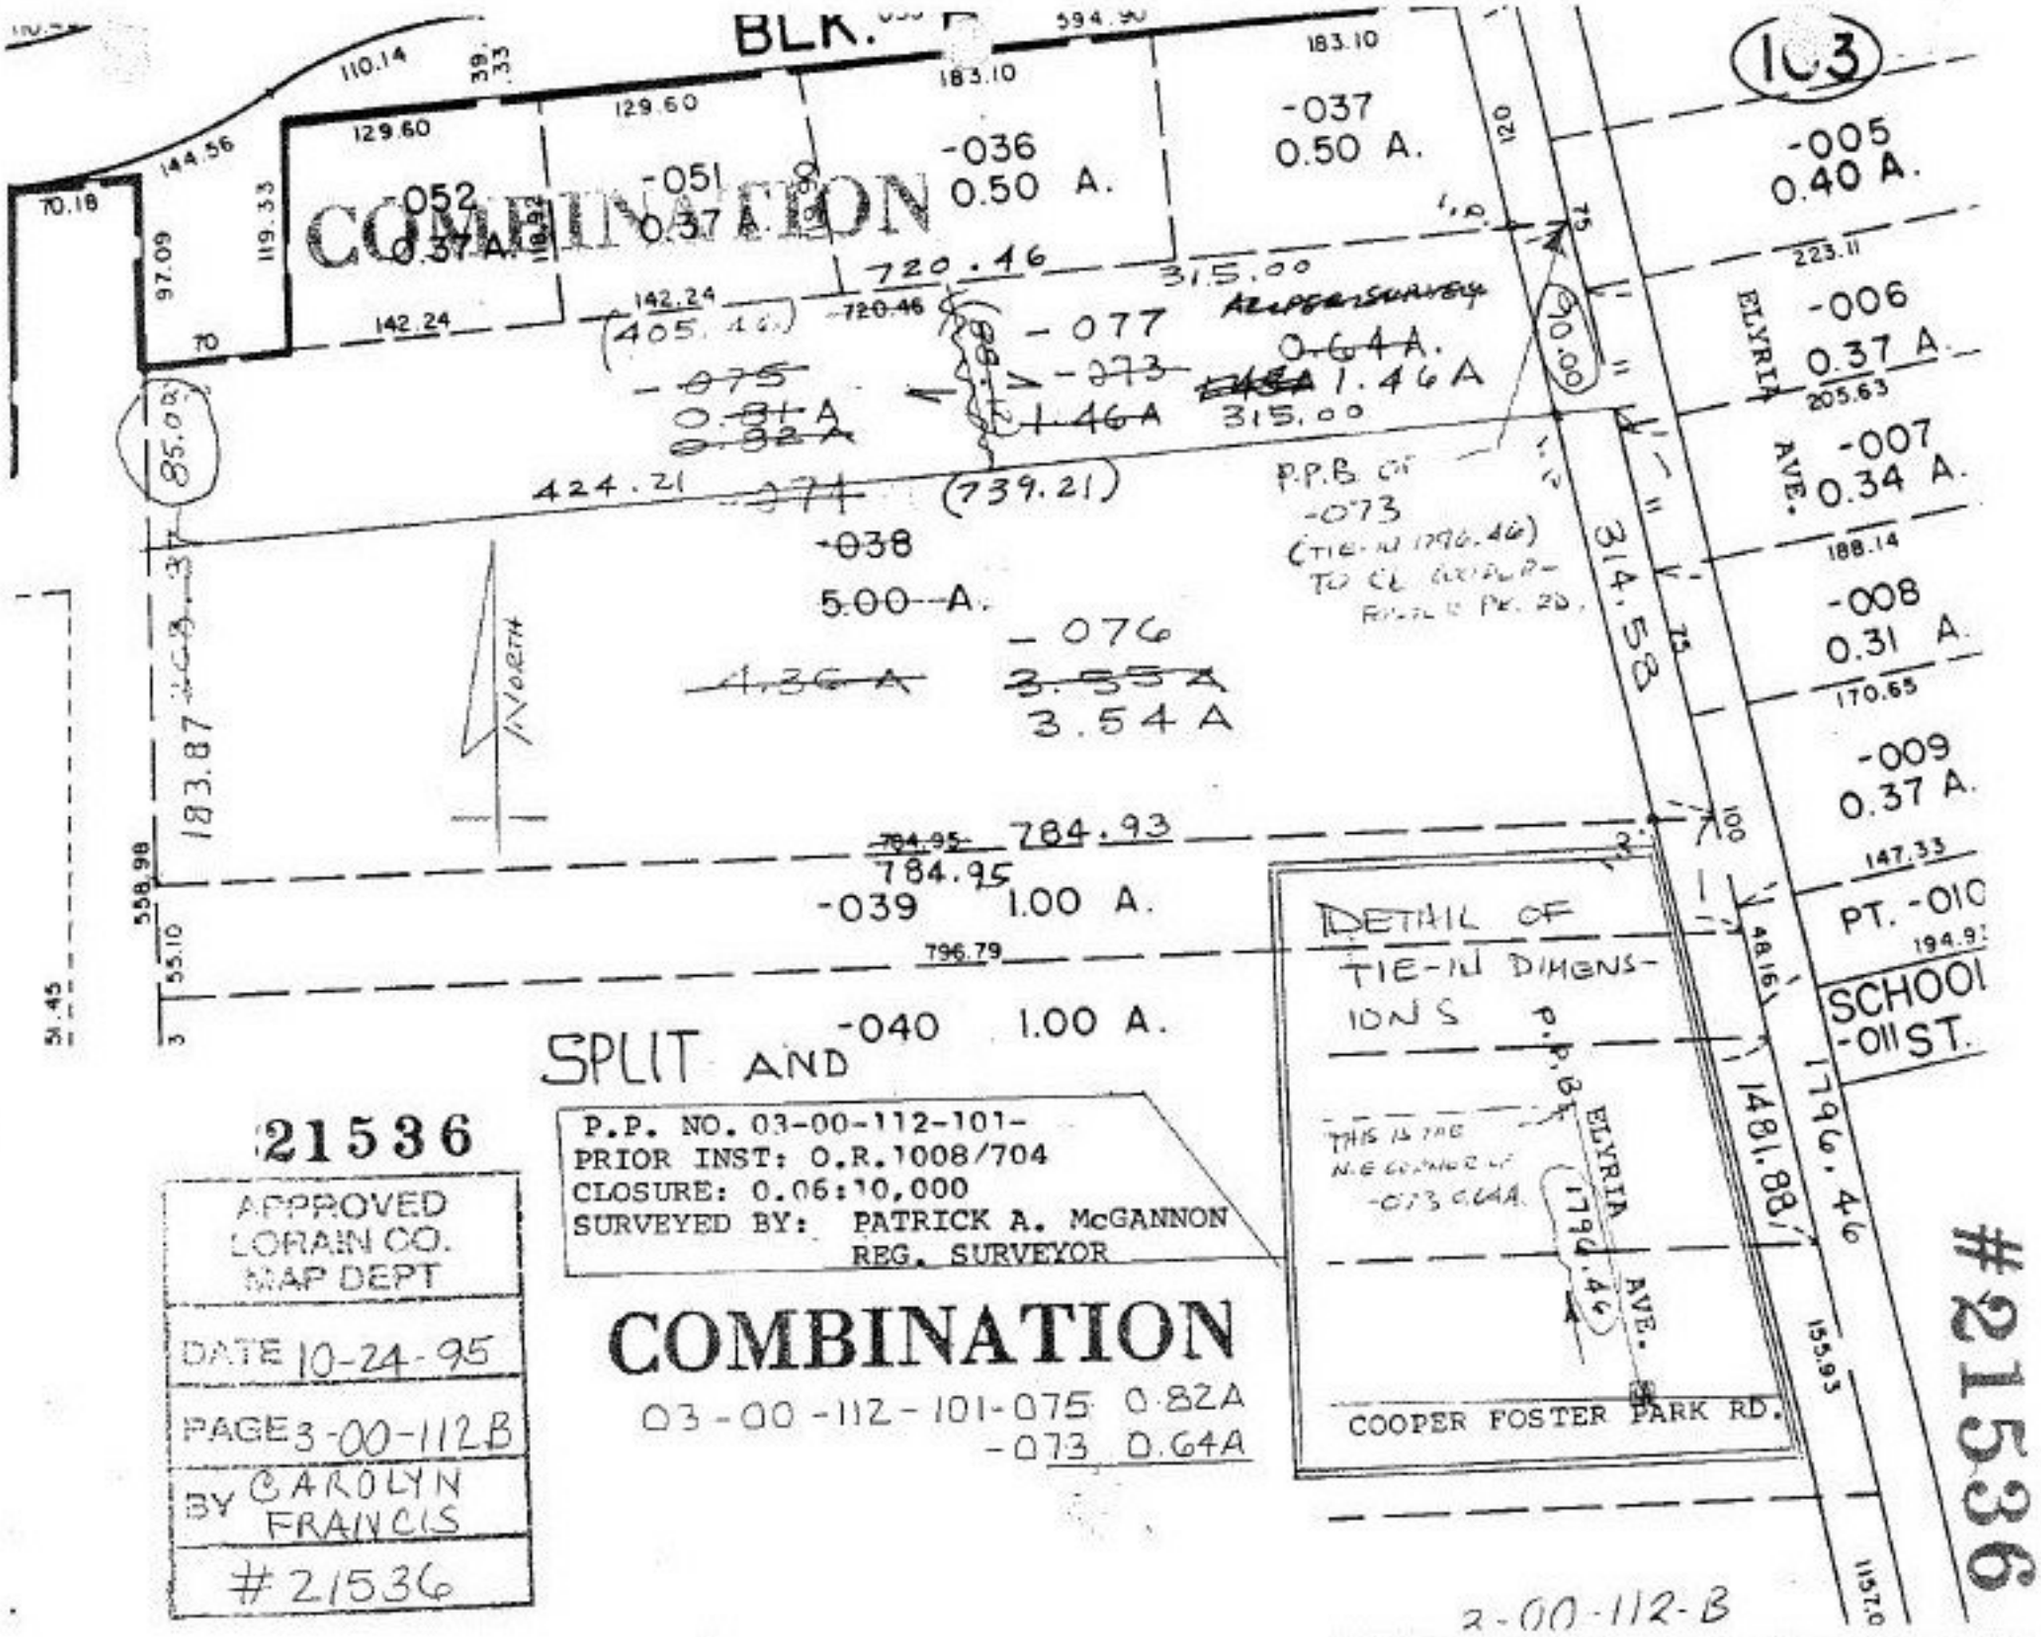


21536

APPROVED
LORAIN CO.
MAP DEPT

DATE 10-24-95

PAGE 3-00-112B

BY CAROLYN FRANCIS

#21536

P.P. NO. 03-00-112-101-
PRIOR INST: O.R.1008/704
CLOSURE: 0.06:10,000
SURVEYED BY: PATRICK A. McGANNON
REG. SURVEYOR

# COMBINATION

03-00-112-101-075 0.82A
-073 0.64A

#21536

2-00-112-B