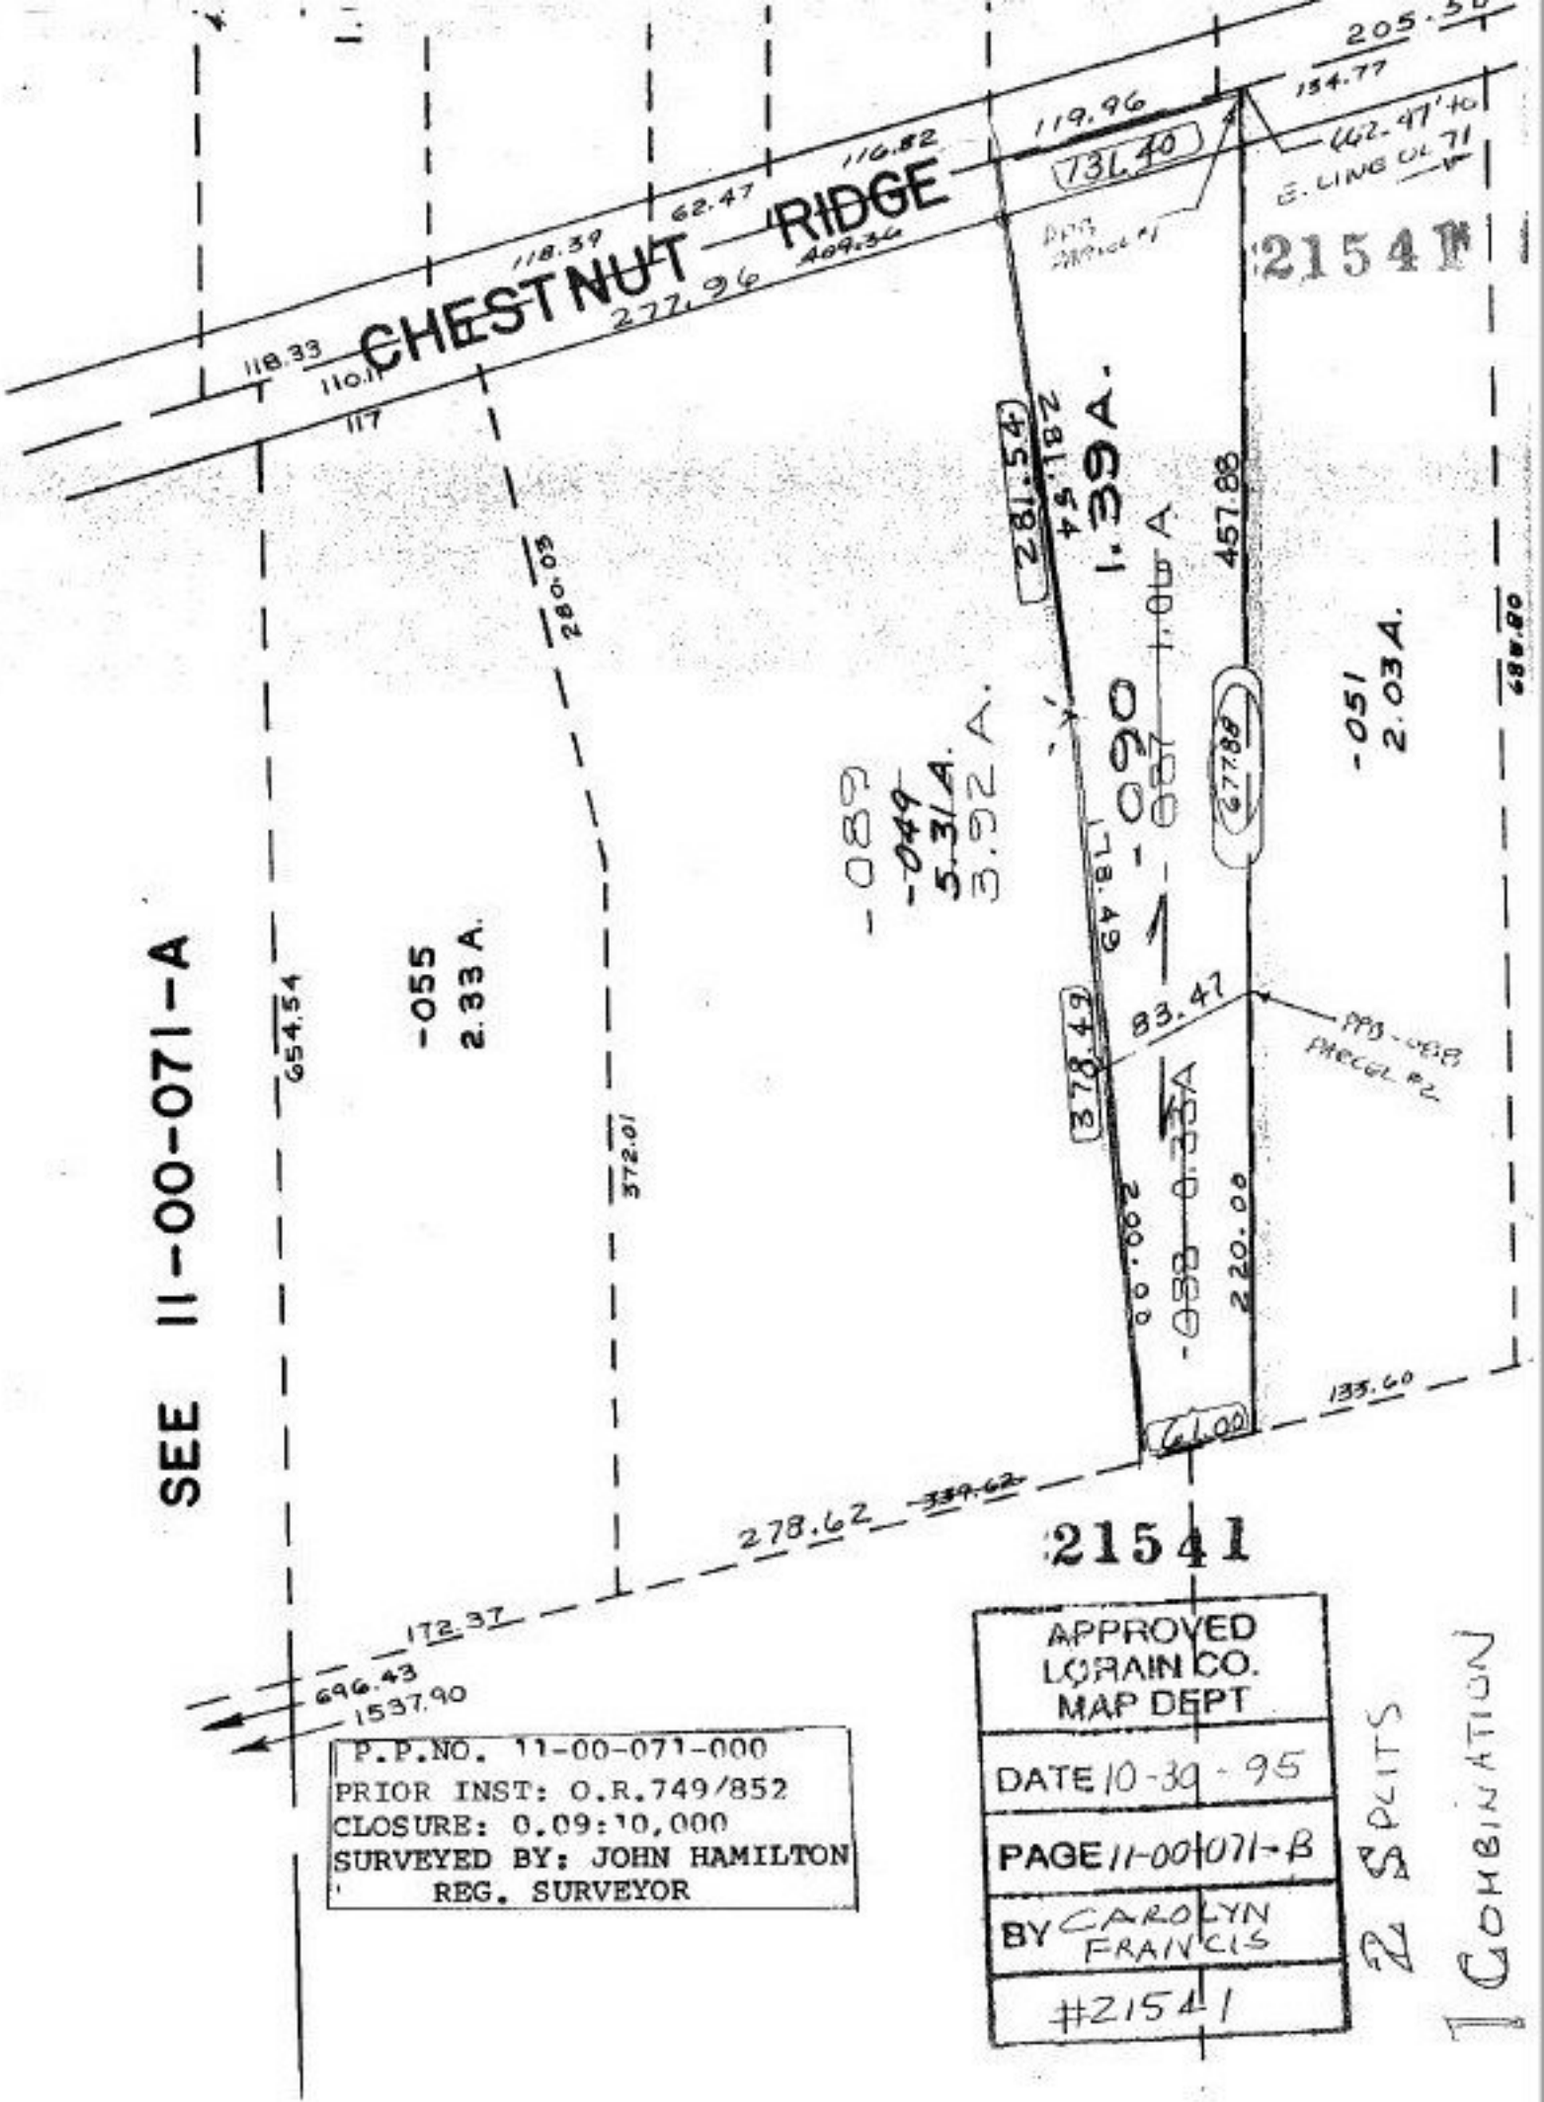
CHESTNUT RIDGE
SEE 11-00-071-A
-055
2.33 A.
-089
-049
5.31A.
3.92 A.
-090
1.39A.
-051
2.03A.
21541
APPROVED
LORAIN CO.
MAP DEPT
DATE 10-30-95
PAGE 11-00-071-B
BY CAROLYN FRANCIS
#21541
P.P.NO. 11-00-071-000
PRIOR INST: O.R.749/852
CLOSURE: 0.09:10,000
SURVEYED BY: JOHN HAMILTON
REG. SURVEYOR
2 SPLITS
1 COMBINATION