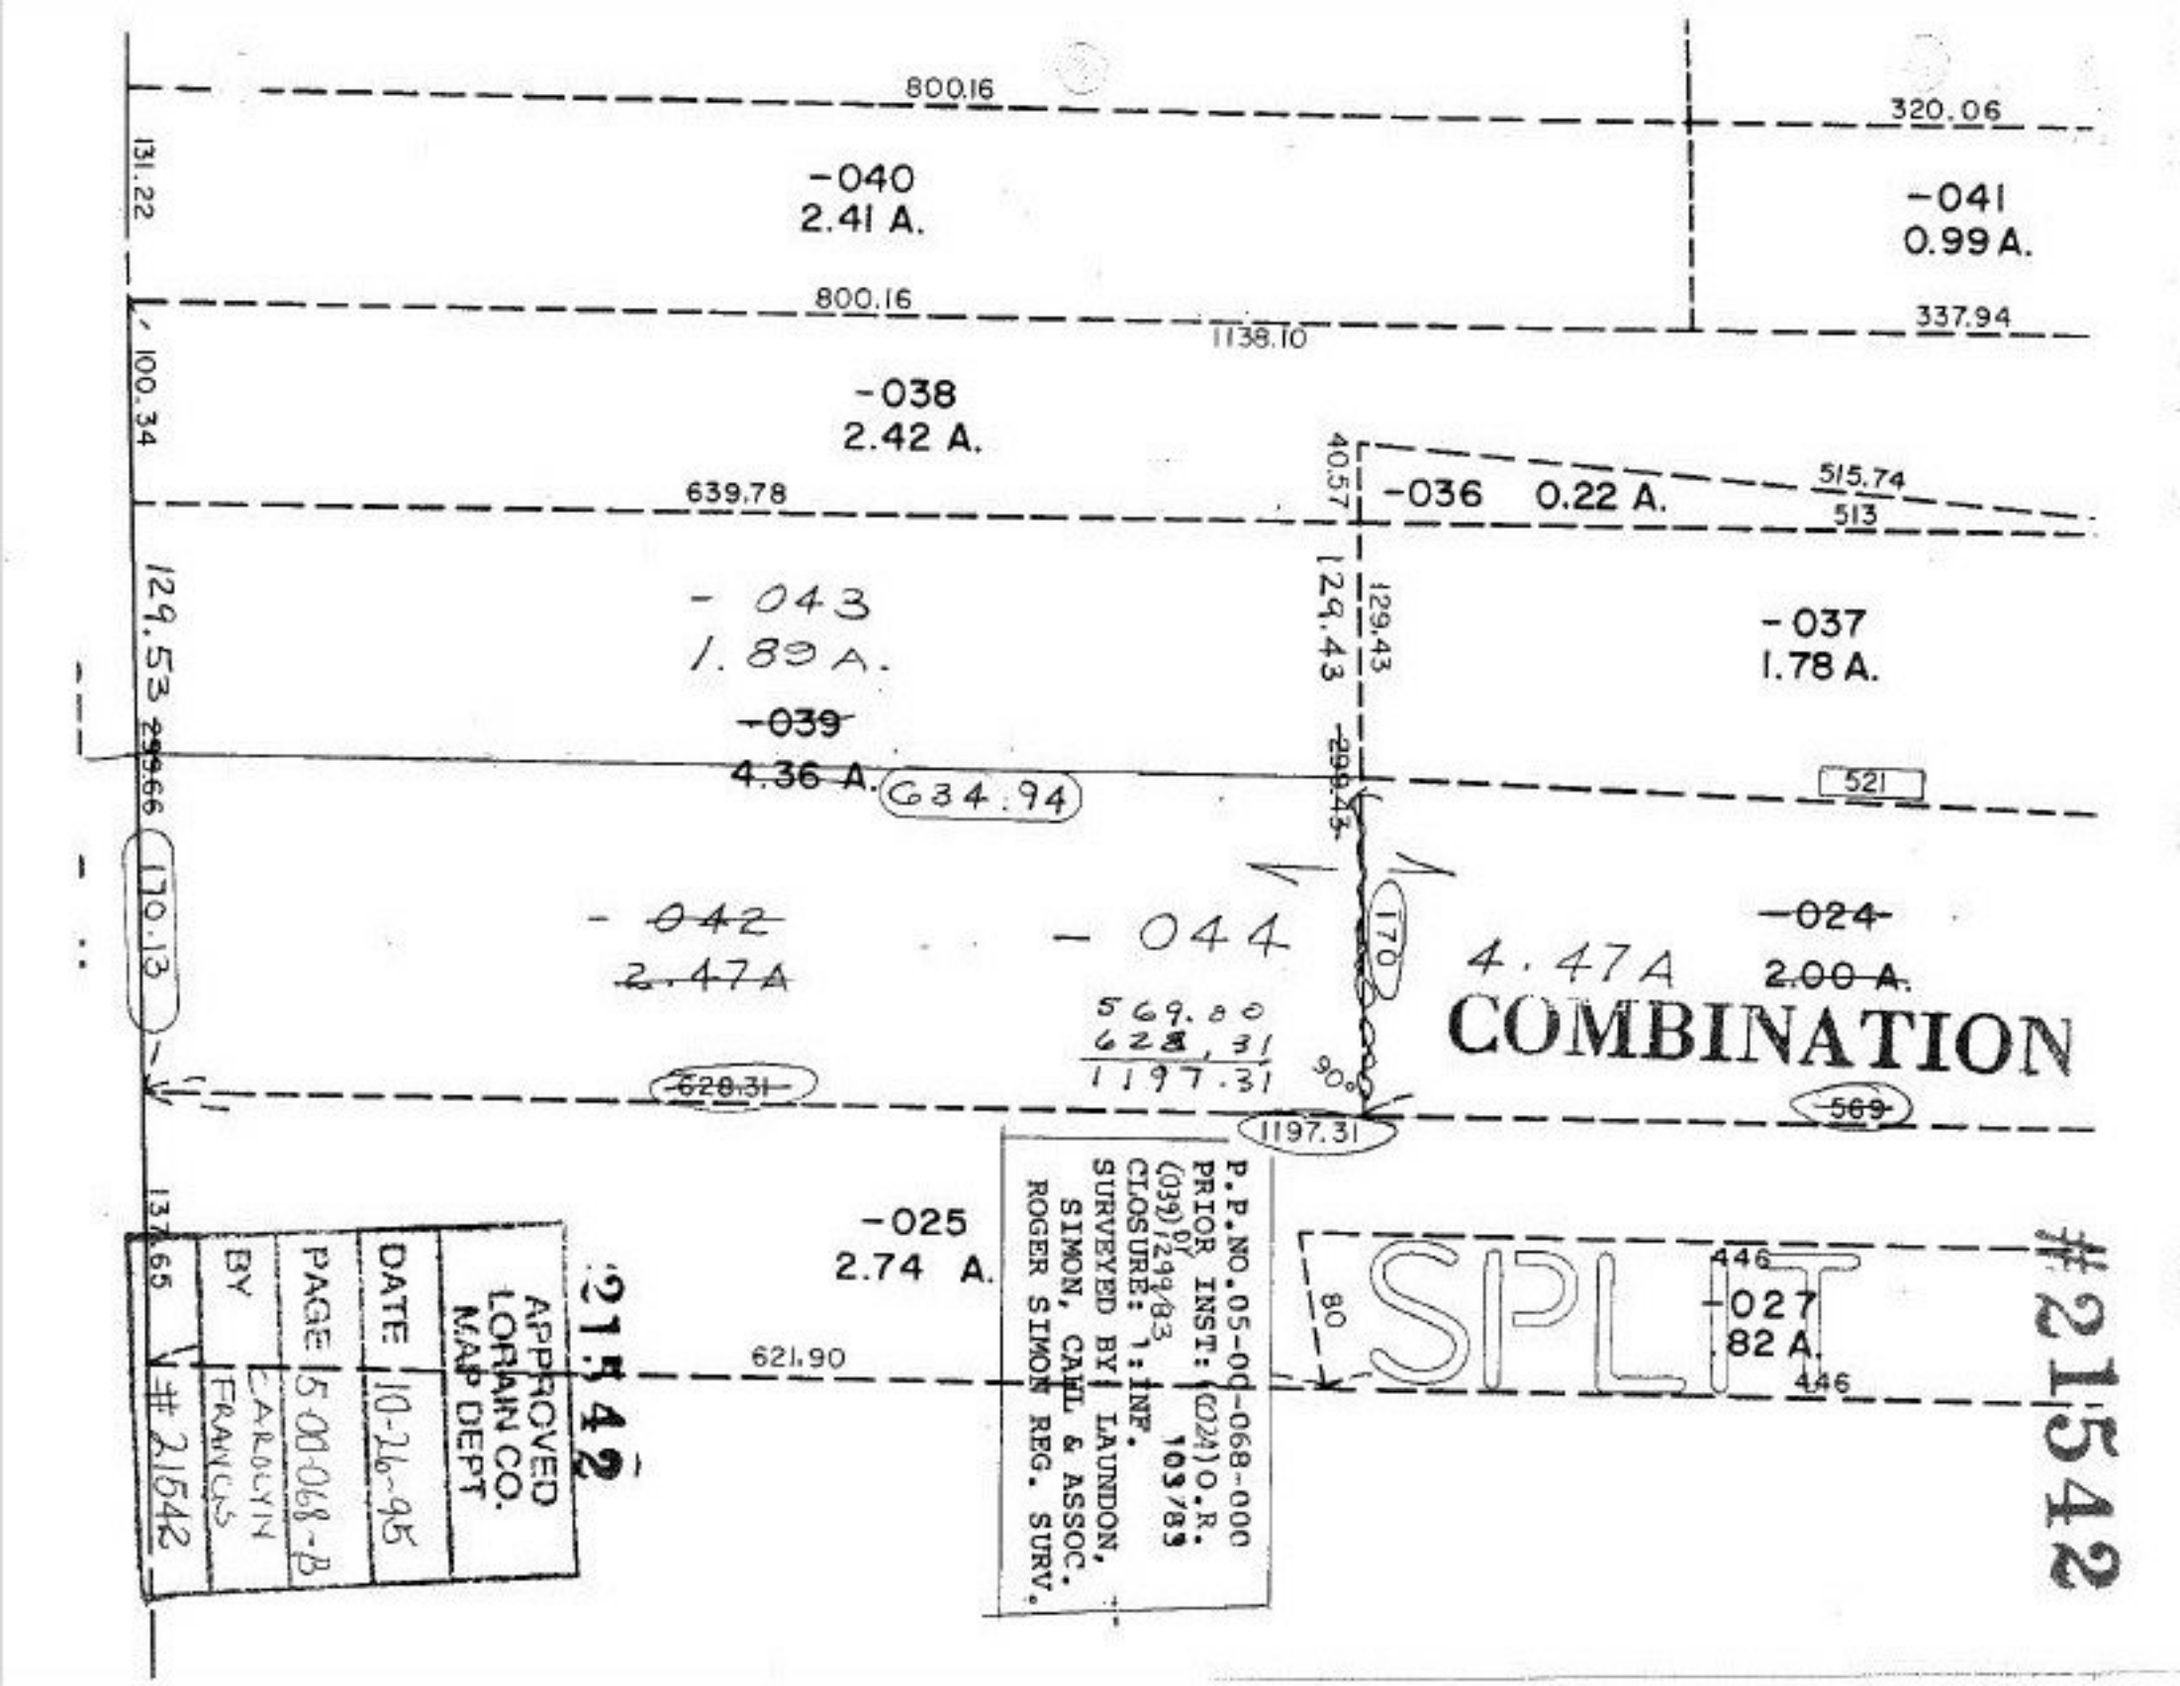
800.16
320.06
131.22
-040
2.41 A.
-041
0.99 A.
800.16
337.94
1138.10
100.34
-038
2.42 A.
40.57
639.78
-036 0.22 A.
515.74
513
129.53
-043
1.89 A.
129.43
129.43
-037
1.78 A.
-039
4.36 A.
634.94
521
-042
2.47A
-044
170
4.47A
-024
2.00 A.
569.80
628.31
1197.31
90°
COMBINATION
628.31
569
1197.31
137.65
-025
2.74 A.
621.90
80
SPLIT
446
-027
82 A.
446
#21542
P.P.NO.05-00-068-000
PRIOR INST: (024) O.R. 103/89
(039) 01/29/93
CLOSURE: 1:INF.
SURVEYED BY LAUNDON, SIMON, CAHL & ASSOC.
ROGER SIMON REG. SURV.
APPROVED
LORAIN CO.
MAP DEPT.
DATE 10-26-95
PAGE 5-00-068-B
BY CAROLYN FRANCIS
#21542
#21542