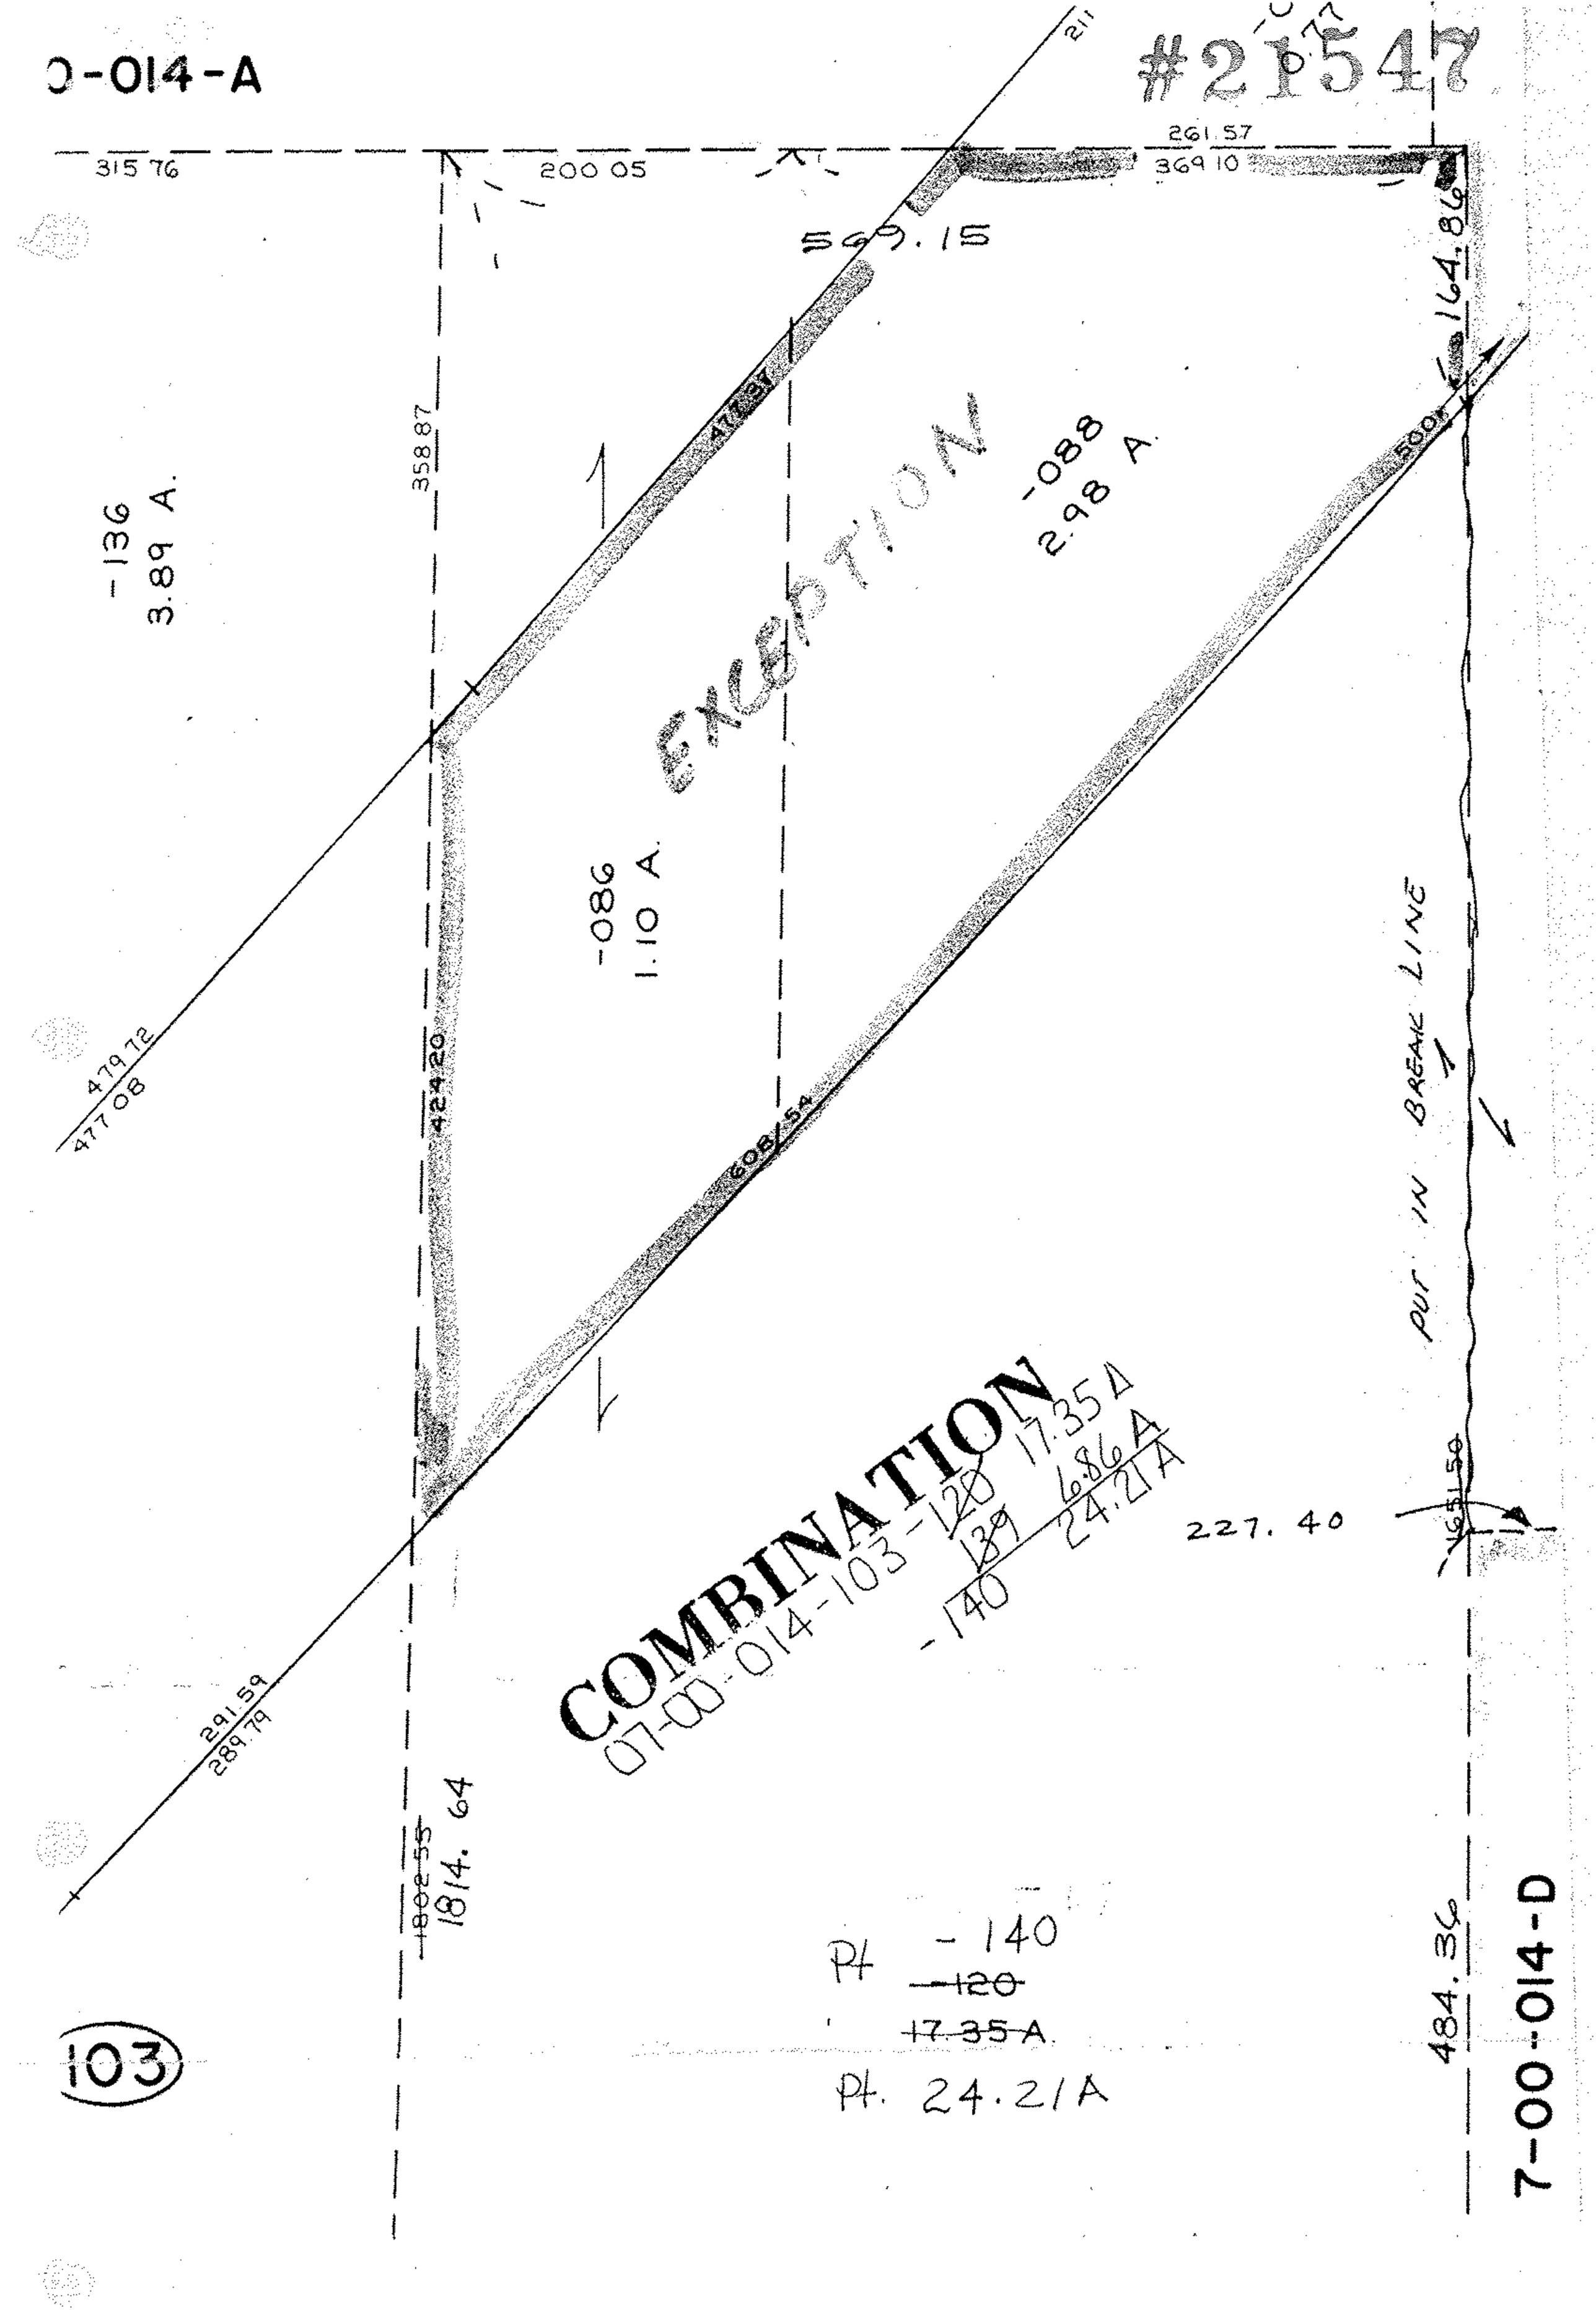

0-014-A
#21547
315 76
200 05
261.57
369 10
569.15
164.86
358 87
477 37
-136
3.89 A.
EXCEPTION
-088
2.98 A.
500
-086
1.10 A.
479 72
477 08
424 20
608 54
PUT IN BREAK LINE
COMBINATION
07-00-014-103-120 17.35 A
139 6.86 A
-140 24.21 A
227.40
1651 50
291.59
289.79
1802 55
1814.64
Pt -140
~~-120~~
~~17.35 A~~
Pt. 24.21 A
484.36
103
7-00-014-D