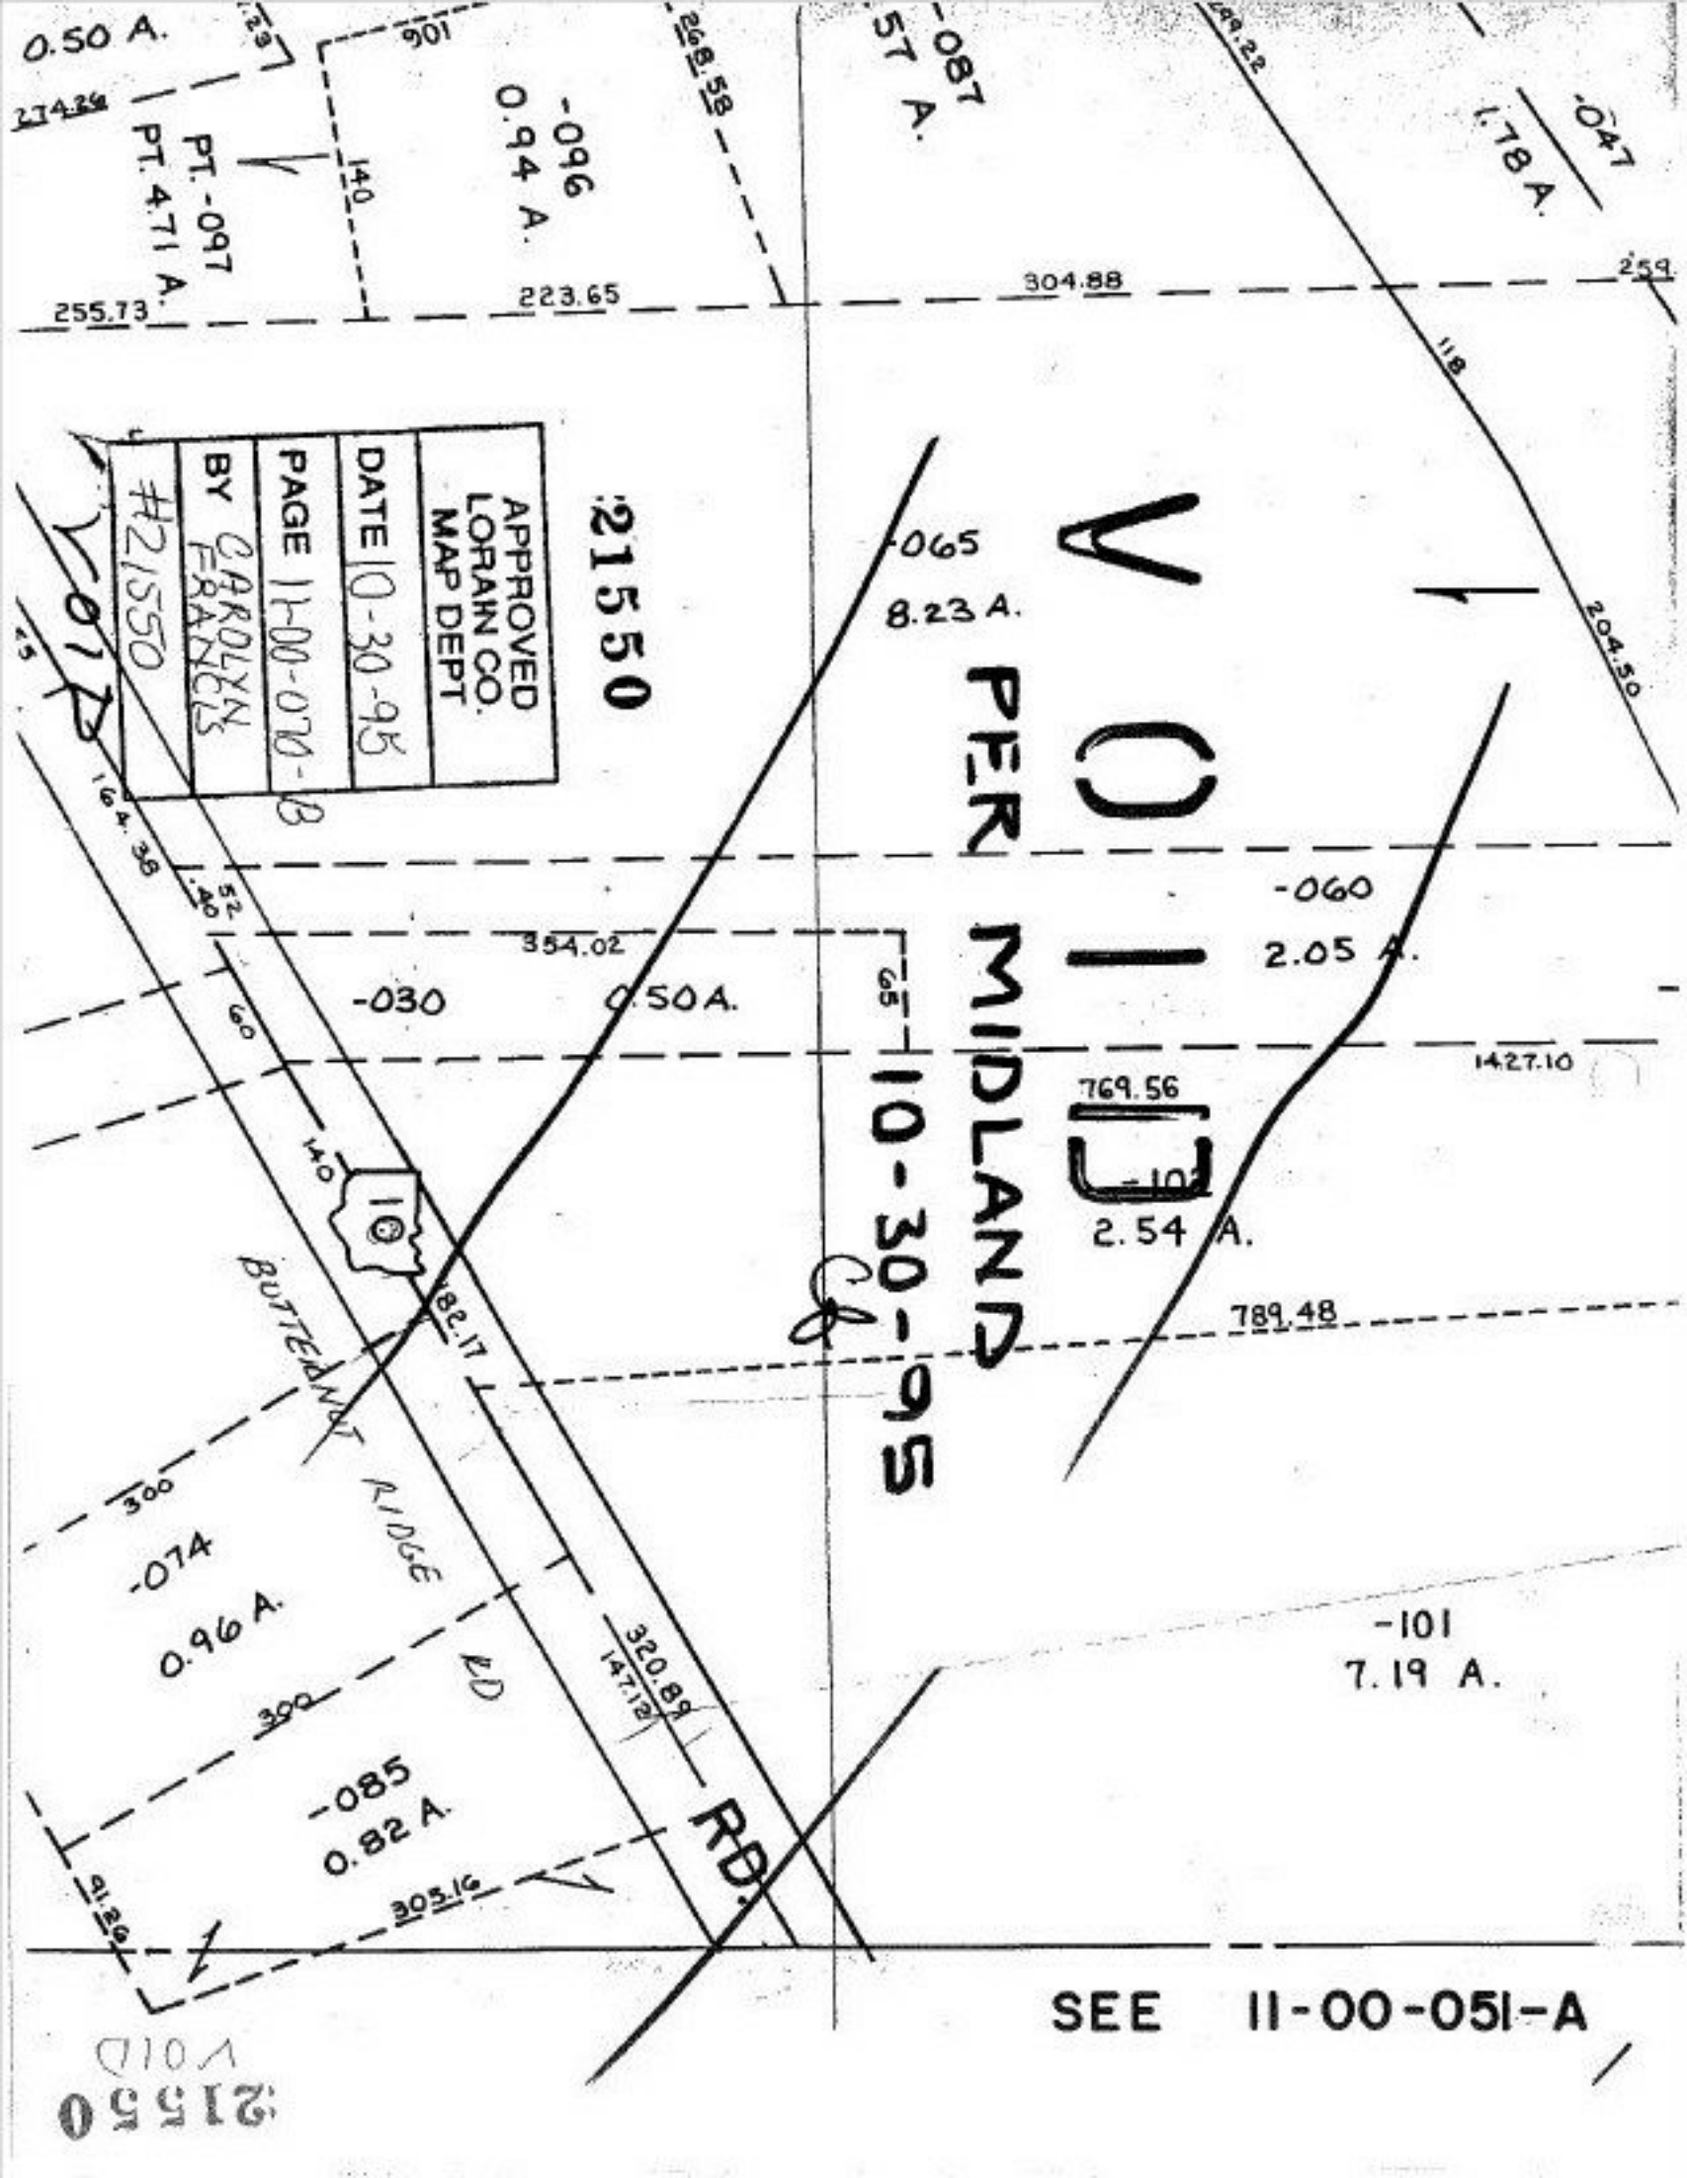
0.50 A.
274.29
PT. -097
PT. 4.71 A.
255.73
140
-096
0.94 A.
223.65
268.58
-087
57 A.
304.88
249.22
1.78 A.
-047
259
118
204.50
APPROVED
LORAIN CO.
MAP DEPT.
DATE 10-30-95
PAGE 11-00-070-B
BY CAROLYN FRANCIS
#21550
21550
VOL
-065
8.23 A.
VOL
PER MIDLAND
10-30-95
C&
-060
2.05 A.
164.38
52.40
354.02
-030
0.50 A.
60
65
1427.10
769.56
-105
2.54 A.
140
10
BUTTERNUT RIDGE
82.17
789.48
300
-074
0.96 A.
300
320.89
147.12
RD.
-101
7.19 A.
-085
0.82 A.
91.29
305.16
SEE 11-00-051-A
21550
VOL