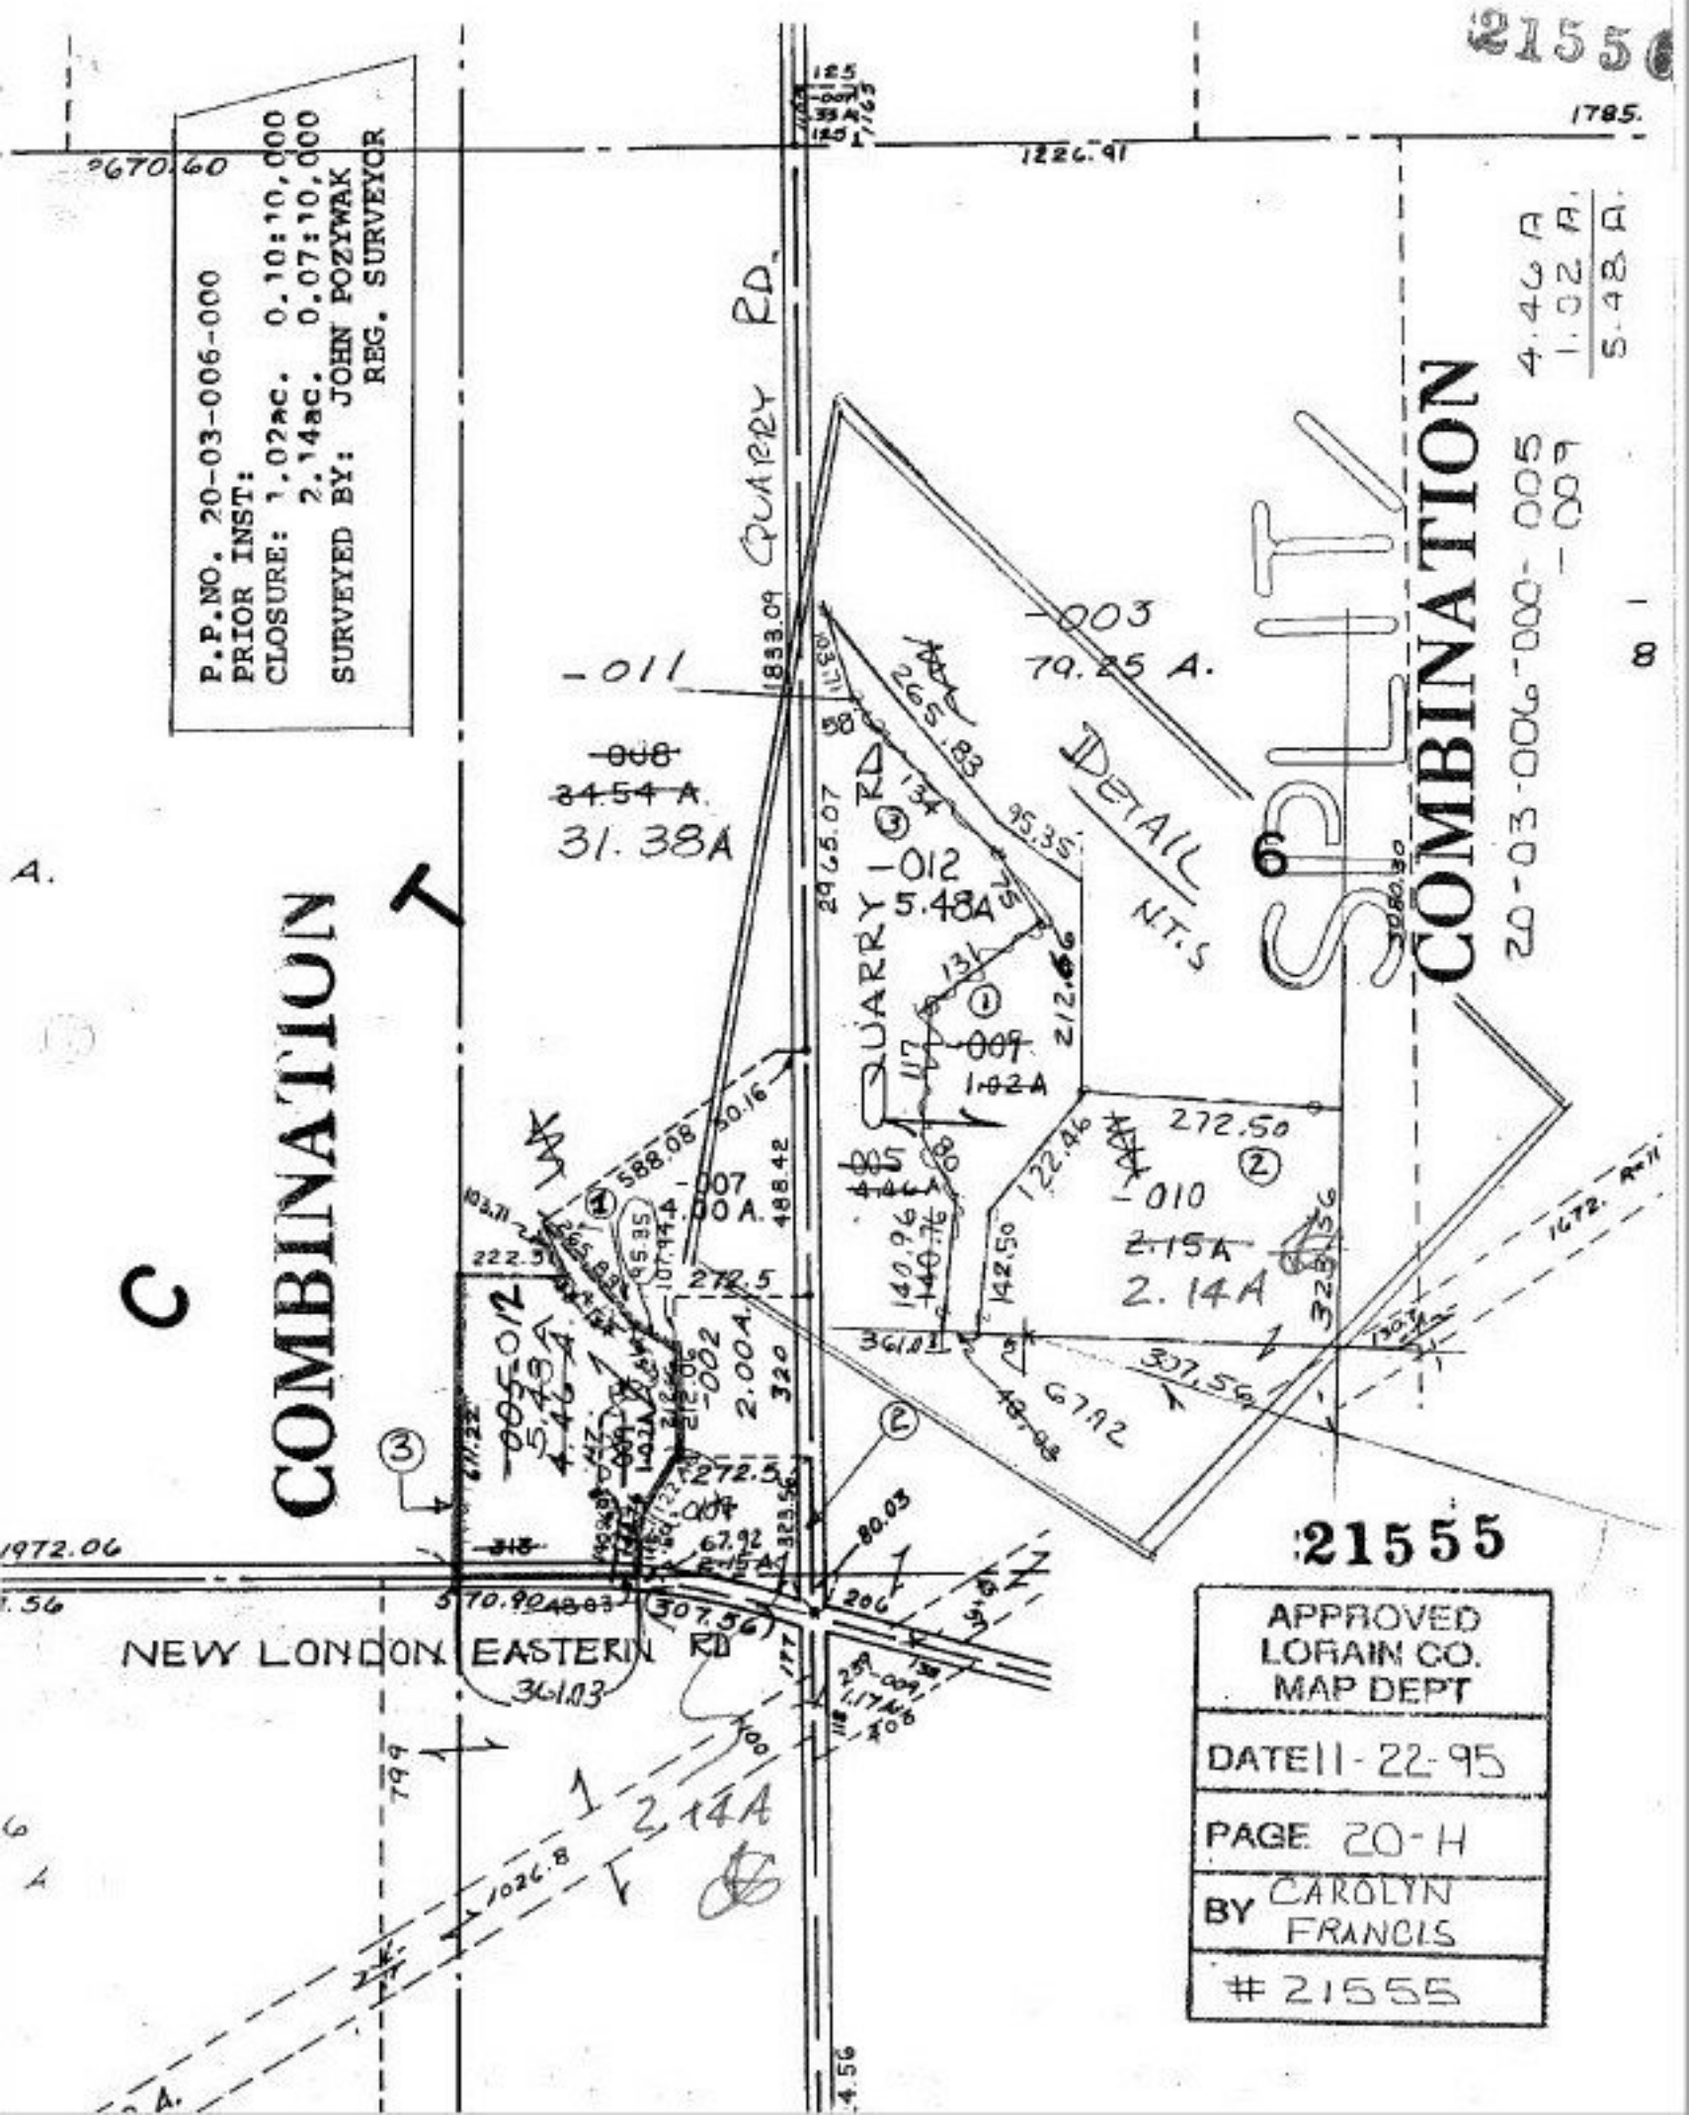
21556
P.P.NO. 20-03-006-000
PRIOR INST:
CLOSURE: 1.02ac. 0.10:10,000
2.14ac. 0.07:10,000
SURVEYED BY: JOHN POZYWAK
REG. SURVEYOR
COMBINATION
COMBINATION
SPLIT
20-03-006-000-005 4.46 A
-009 1.02 A
5.48 A
QUARRY RD.
QUARRY RD
DETAIL
N.T.S
-003
79.25 A.
-011
31.38A
-012
5.48A
-009
1.02A
-010
2.15A
2.14A
-007
4.00 A.
-002
2.00A
NEW LONDON EASTERN RD
361.03
2.14A
21555
APPROVED
LORAIN CO.
MAP DEPT
DATE 11-22-95
PAGE 20-H
BY CAROLYN FRANCIS
21555