#21557-A

SEE 10-00-012-D

P.P.NO. 10-00-0
10-00-013-000-244

Ac. Core per surveyed by

Laundon Simon Cahl & Assoc.
Roger Simon Reg Surveyor
Closure 0.06:10,000

21557 A

APPROVED LORAIN CO. MAP DEPT
DATE 10-31-95
PAGE 10-00-013A
BY CAROLYN FRANCIS
#21557

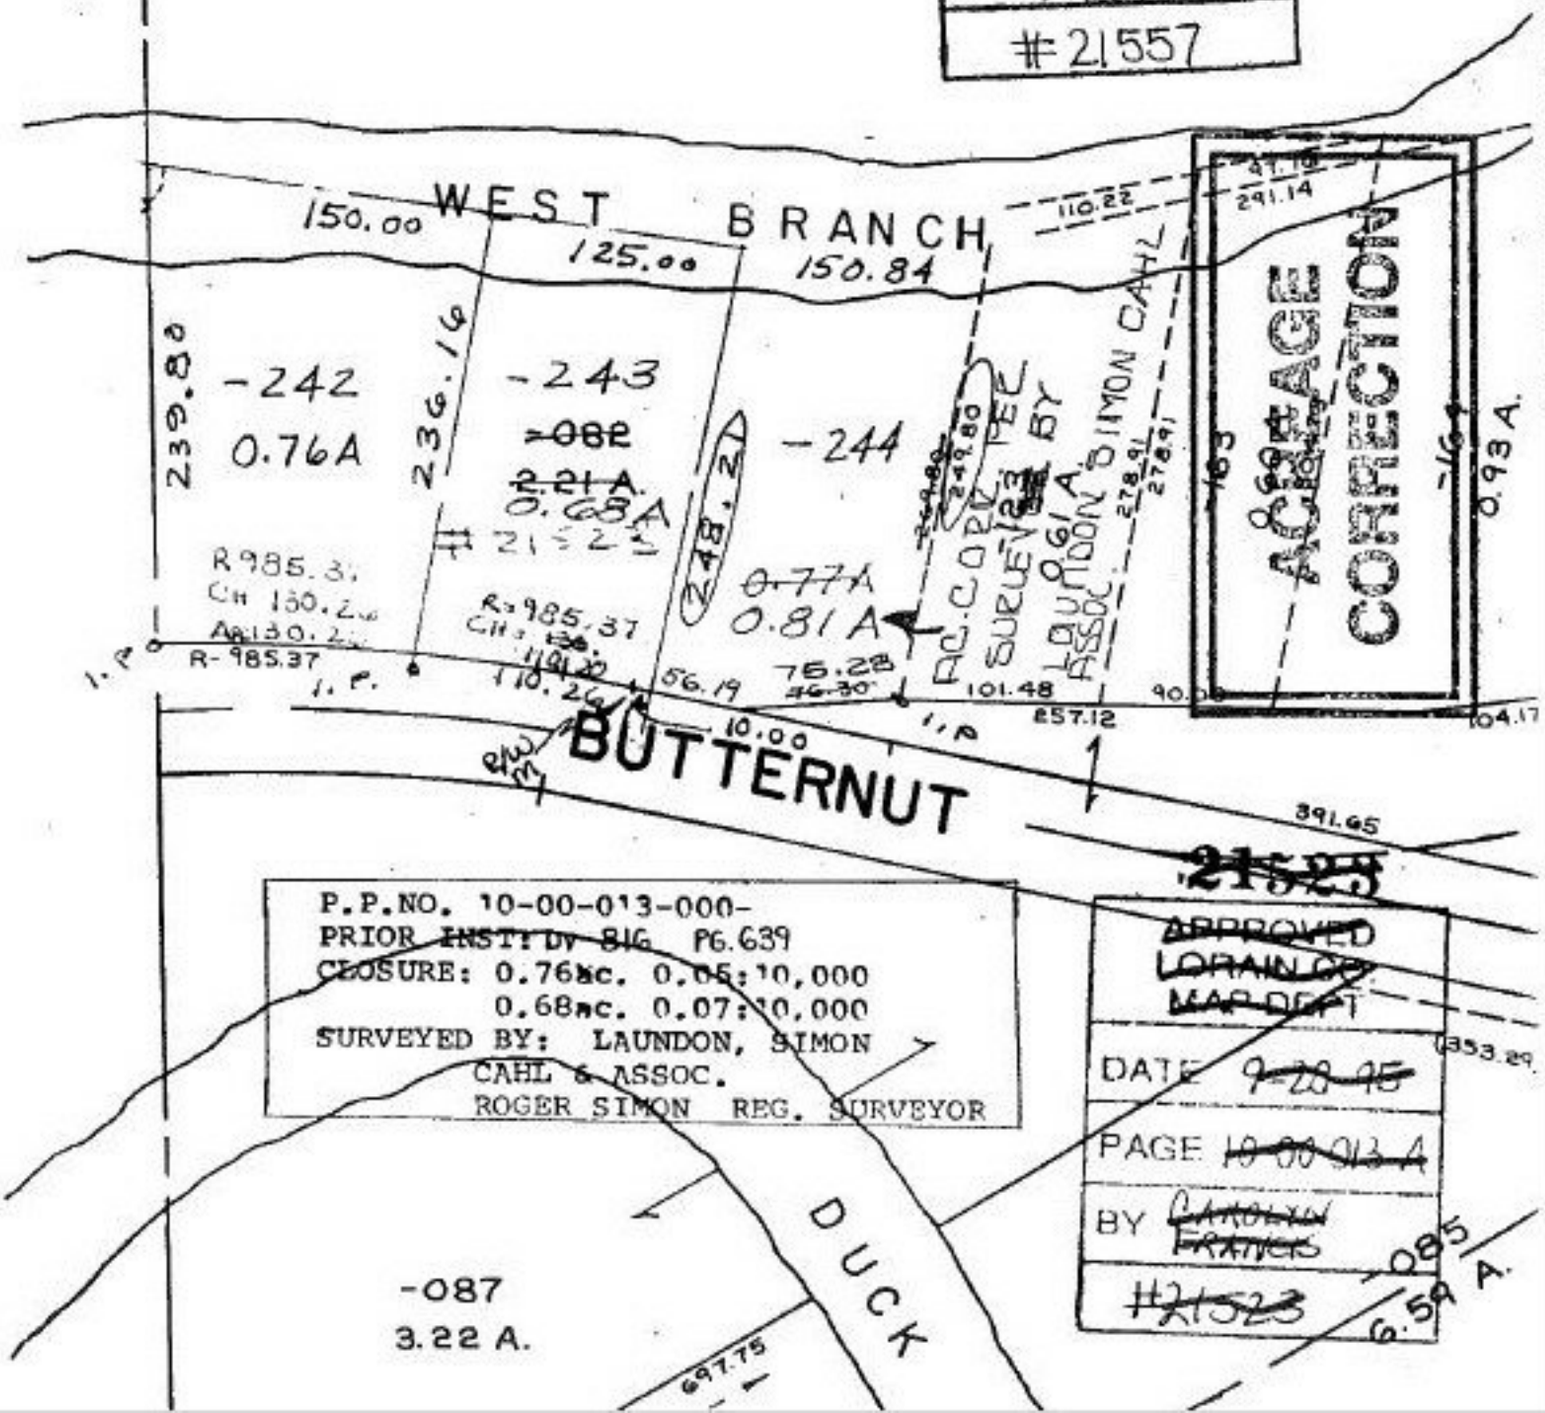

P.P.NO. 10-00-013-000-
PRIOR INST: DV 816 PG.639
CLOSURE: 0.76ac. 0.05:10,000
0.68ac. 0.07:10,000
SURVEYED BY: LAUNDON, SIMON CAHL & ASSOC.
ROGER SIMON REG. SURVEYOR

~~21523~~

~~APPROVED LORAIN CO MAP DEPT~~
DATE ~~9-28-95~~
PAGE ~~10-00-013-A~~
BY ~~CAROLYN FRANCIS~~
~~#21523~~