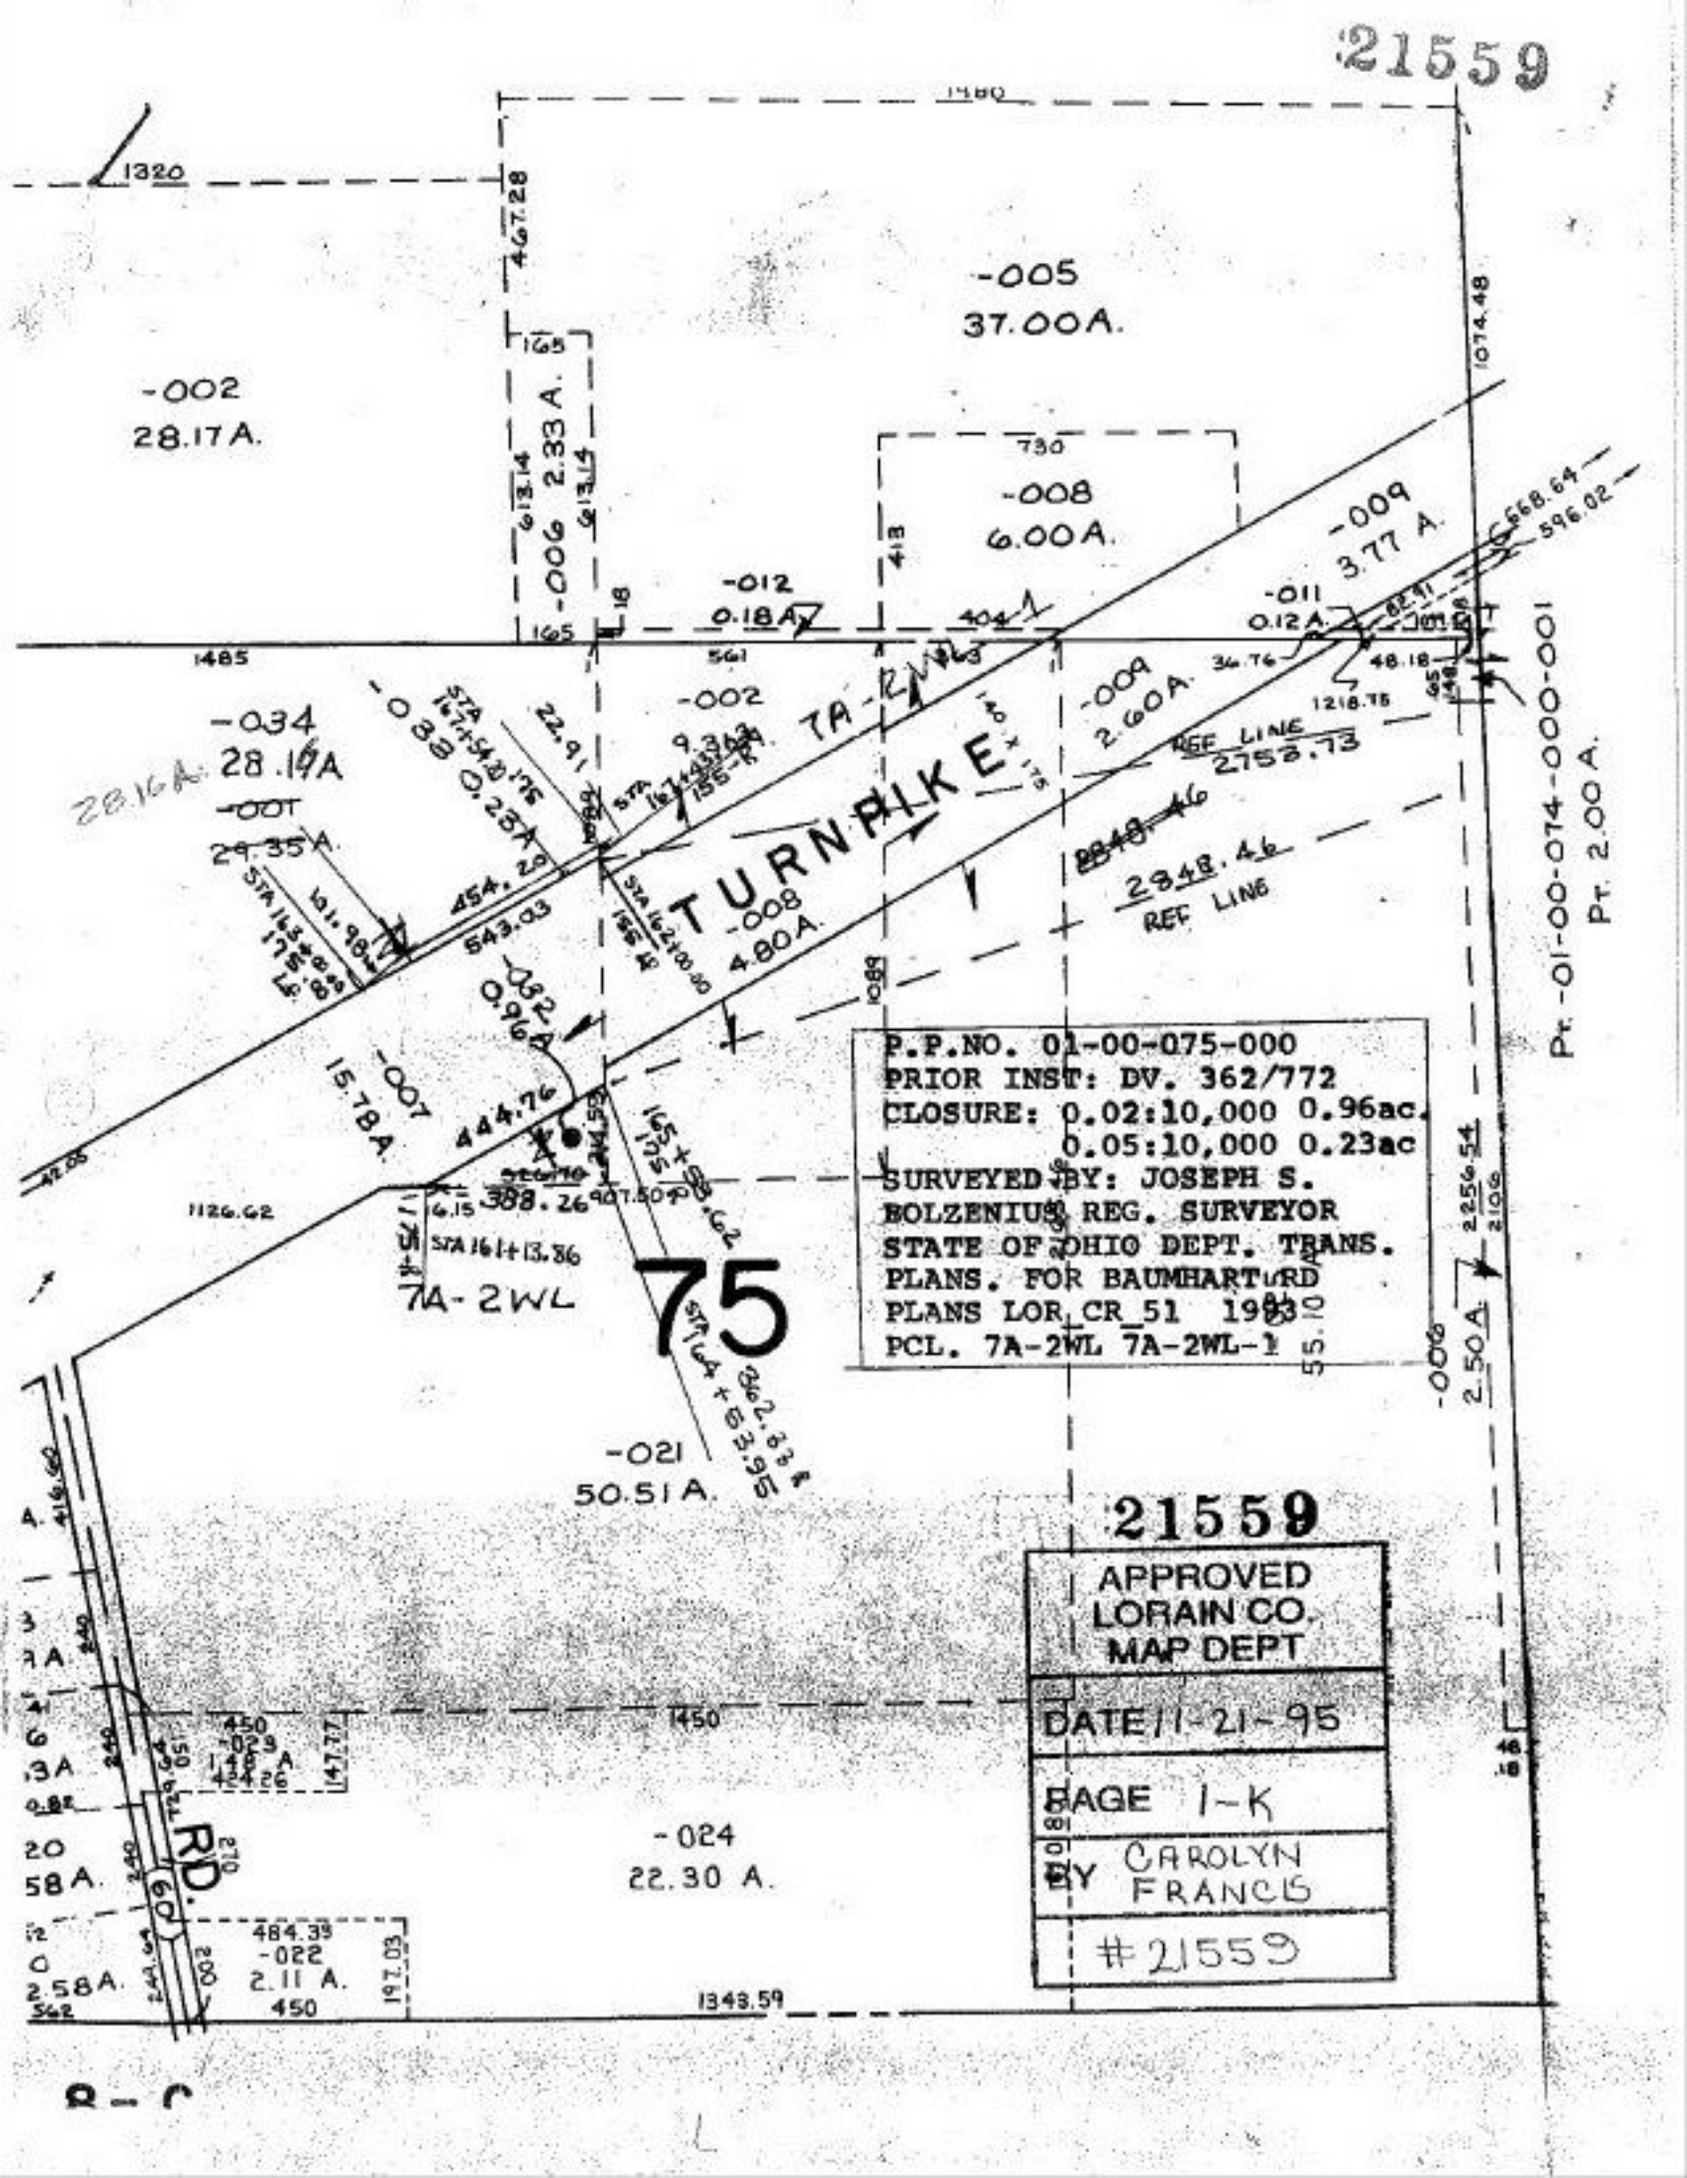


P.P.NO. 01-00-075-000
PRIOR INST: DV. 362/772
CLOSURE: 0.02:10,000 0.96ac.
0.05:10,000 0.23ac
SURVEYED BY: JOSEPH S. BOLZENIUS REG. SURVEYOR STATE OF OHIO DEPT. TRANS. PLANS. FOR BAUMHART RD PLANS LOR CR 51 1983 PCL. 7A-2WL 7A-2WL-1

21559

APPROVED
LORAIN CO.
MAP DEPT

DATE 1-21-95

PAGE 1-K

BY CAROLYN FRANCIS

#21559