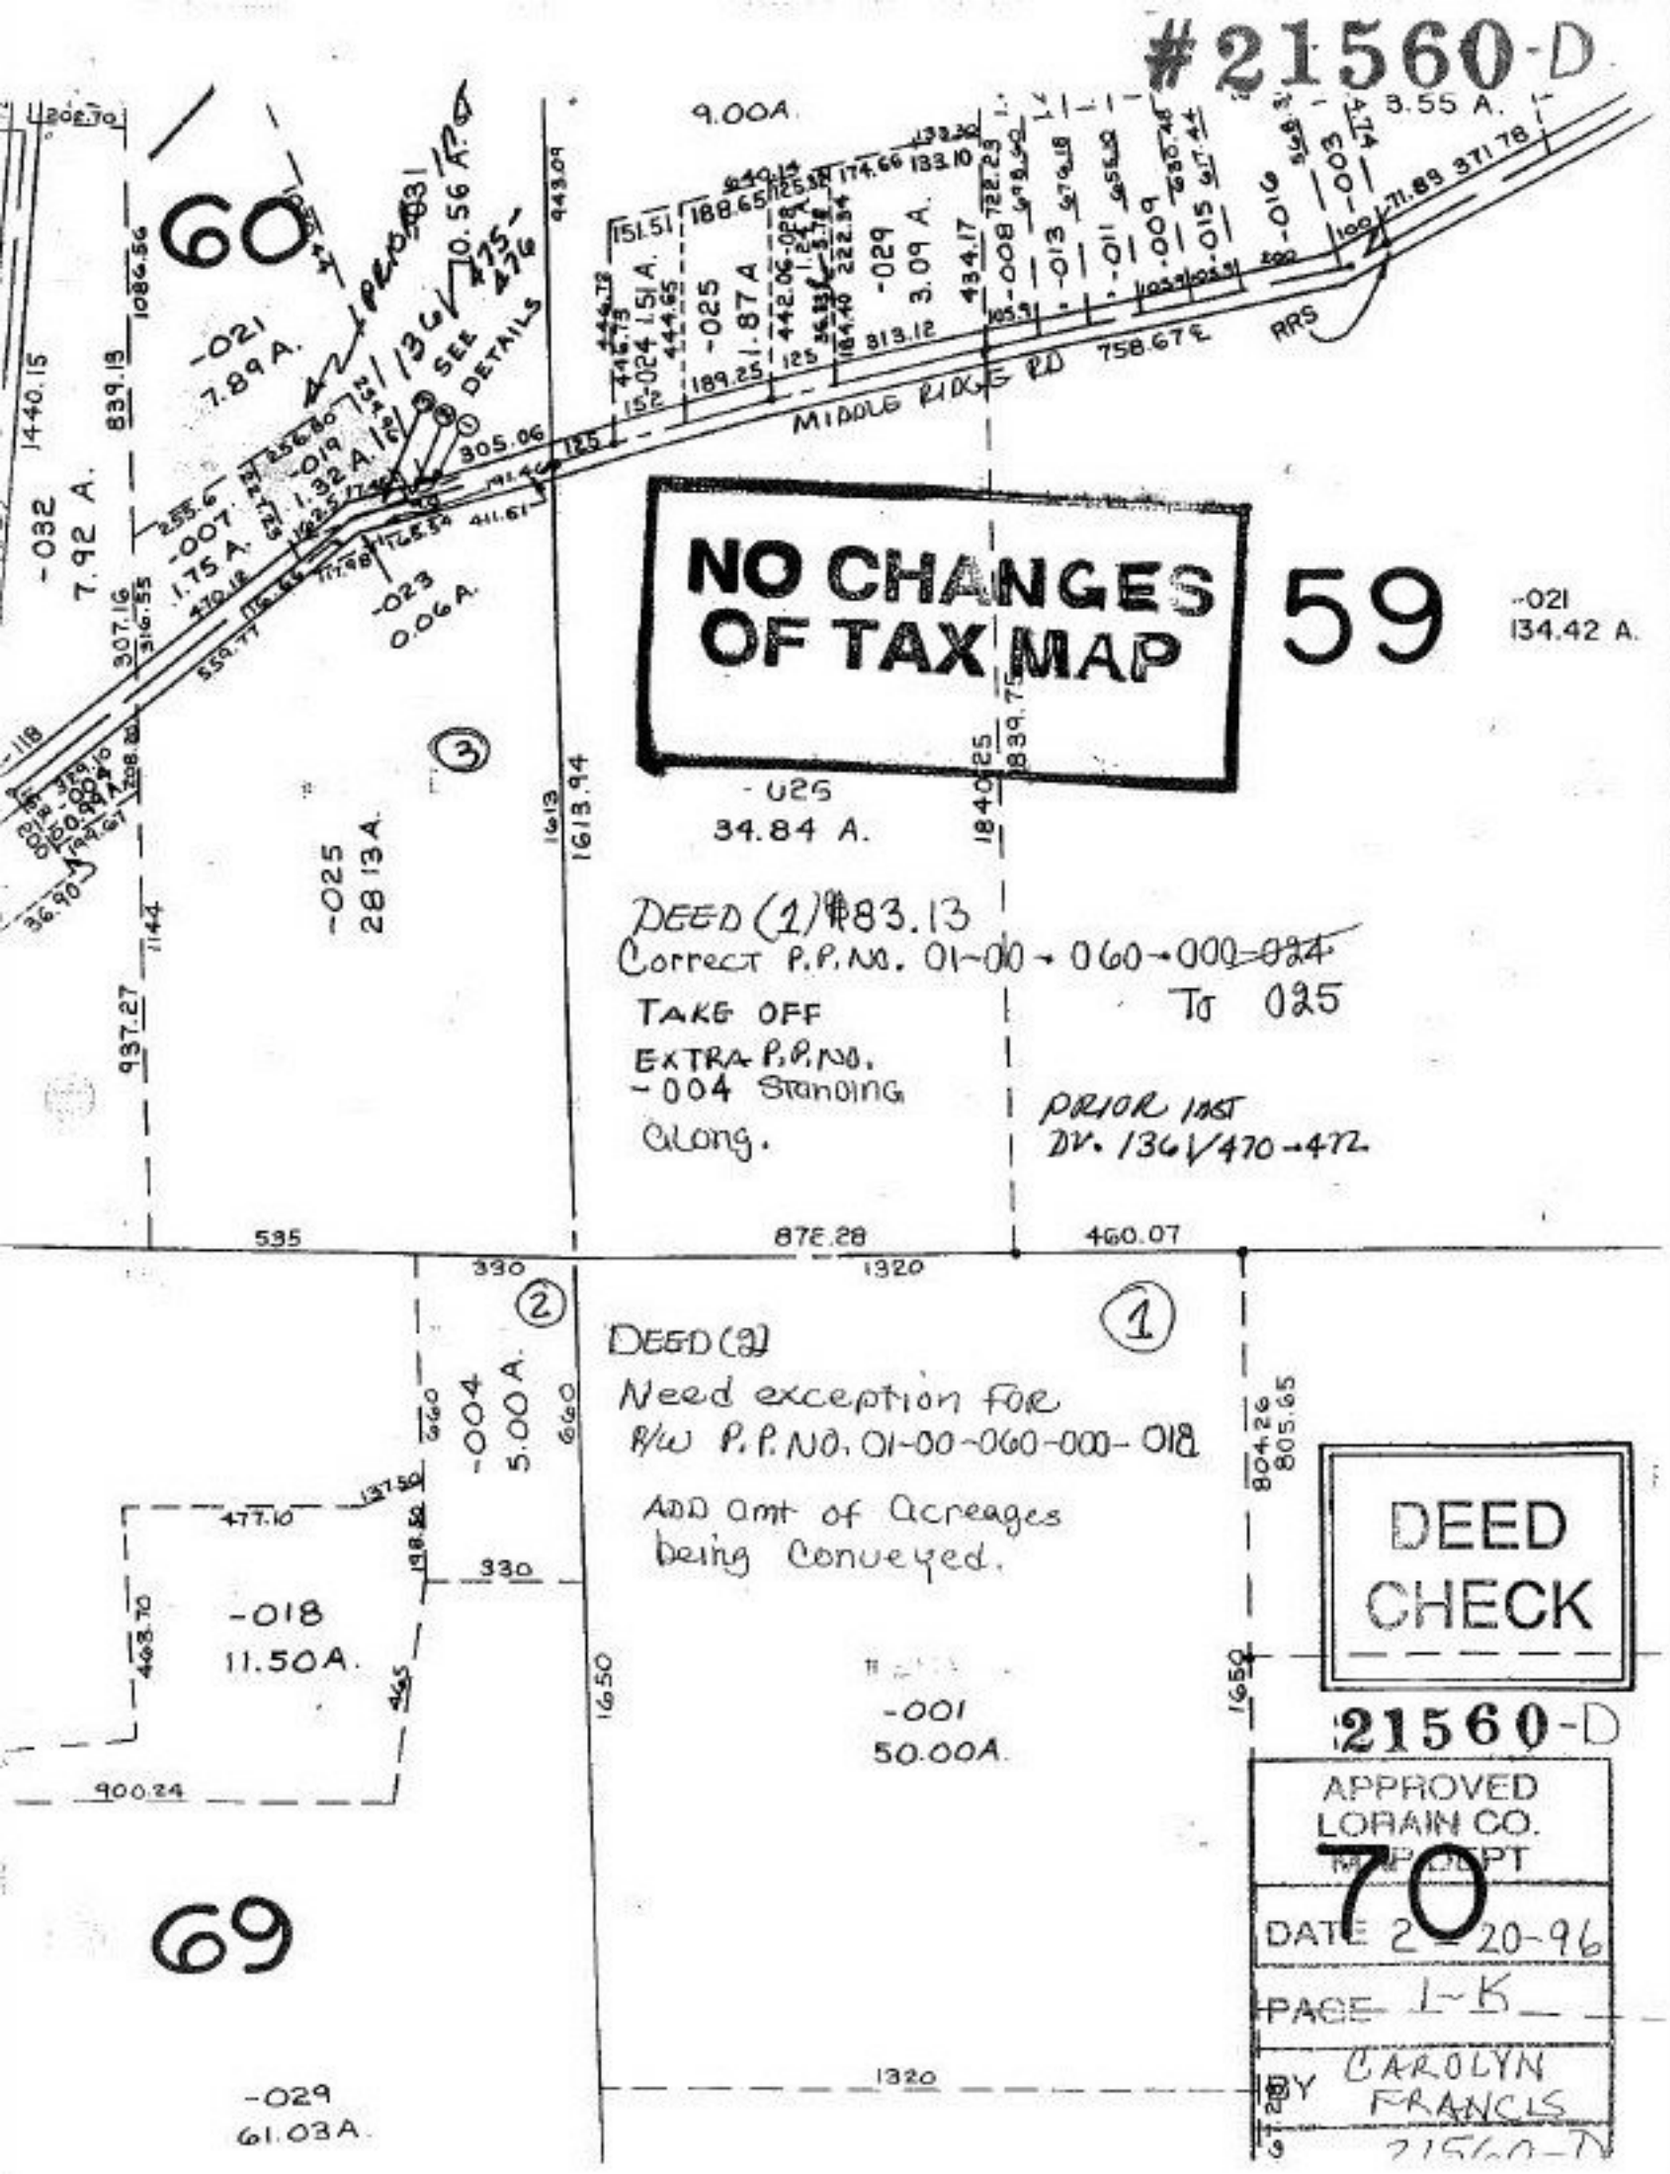
#21560-D
60
59
69
70
NO CHANGES OF TAX MAP
MIDDLE RIDGE RD
RRS
-021 7.89 A.
-032 7.92 A.
-007 1.75 A.
-019 1.32 A.
-023 0.06 A.
-025 28.13 A.
-025 34.84 A.
-021 134.42 A.
-029 3.09 A.
-025 1.87 A.
-024 1.51 A.
-004 5.00 A.
-018 11.50 A.
-001 50.00 A.
-029 61.03 A.
DEED (1) $83.13
Correct P.P. No. 01-00-060-000-024 To 025
TAKE OFF EXTRA P.P. No. -004 Standing along.
PRIOR INST DV. 136 V 470-472
DEED (2)
Need exception for R/W P.P. No. 01-00-060-000-018
ADD amt of acreages being conveyed.
DEED CHECK
21560-D
APPROVED LORAIN CO. MAP DEPT
DATE 2-20-96
PAGE 1-K
BY CAROLYN FRANCIS
21560-D