21562

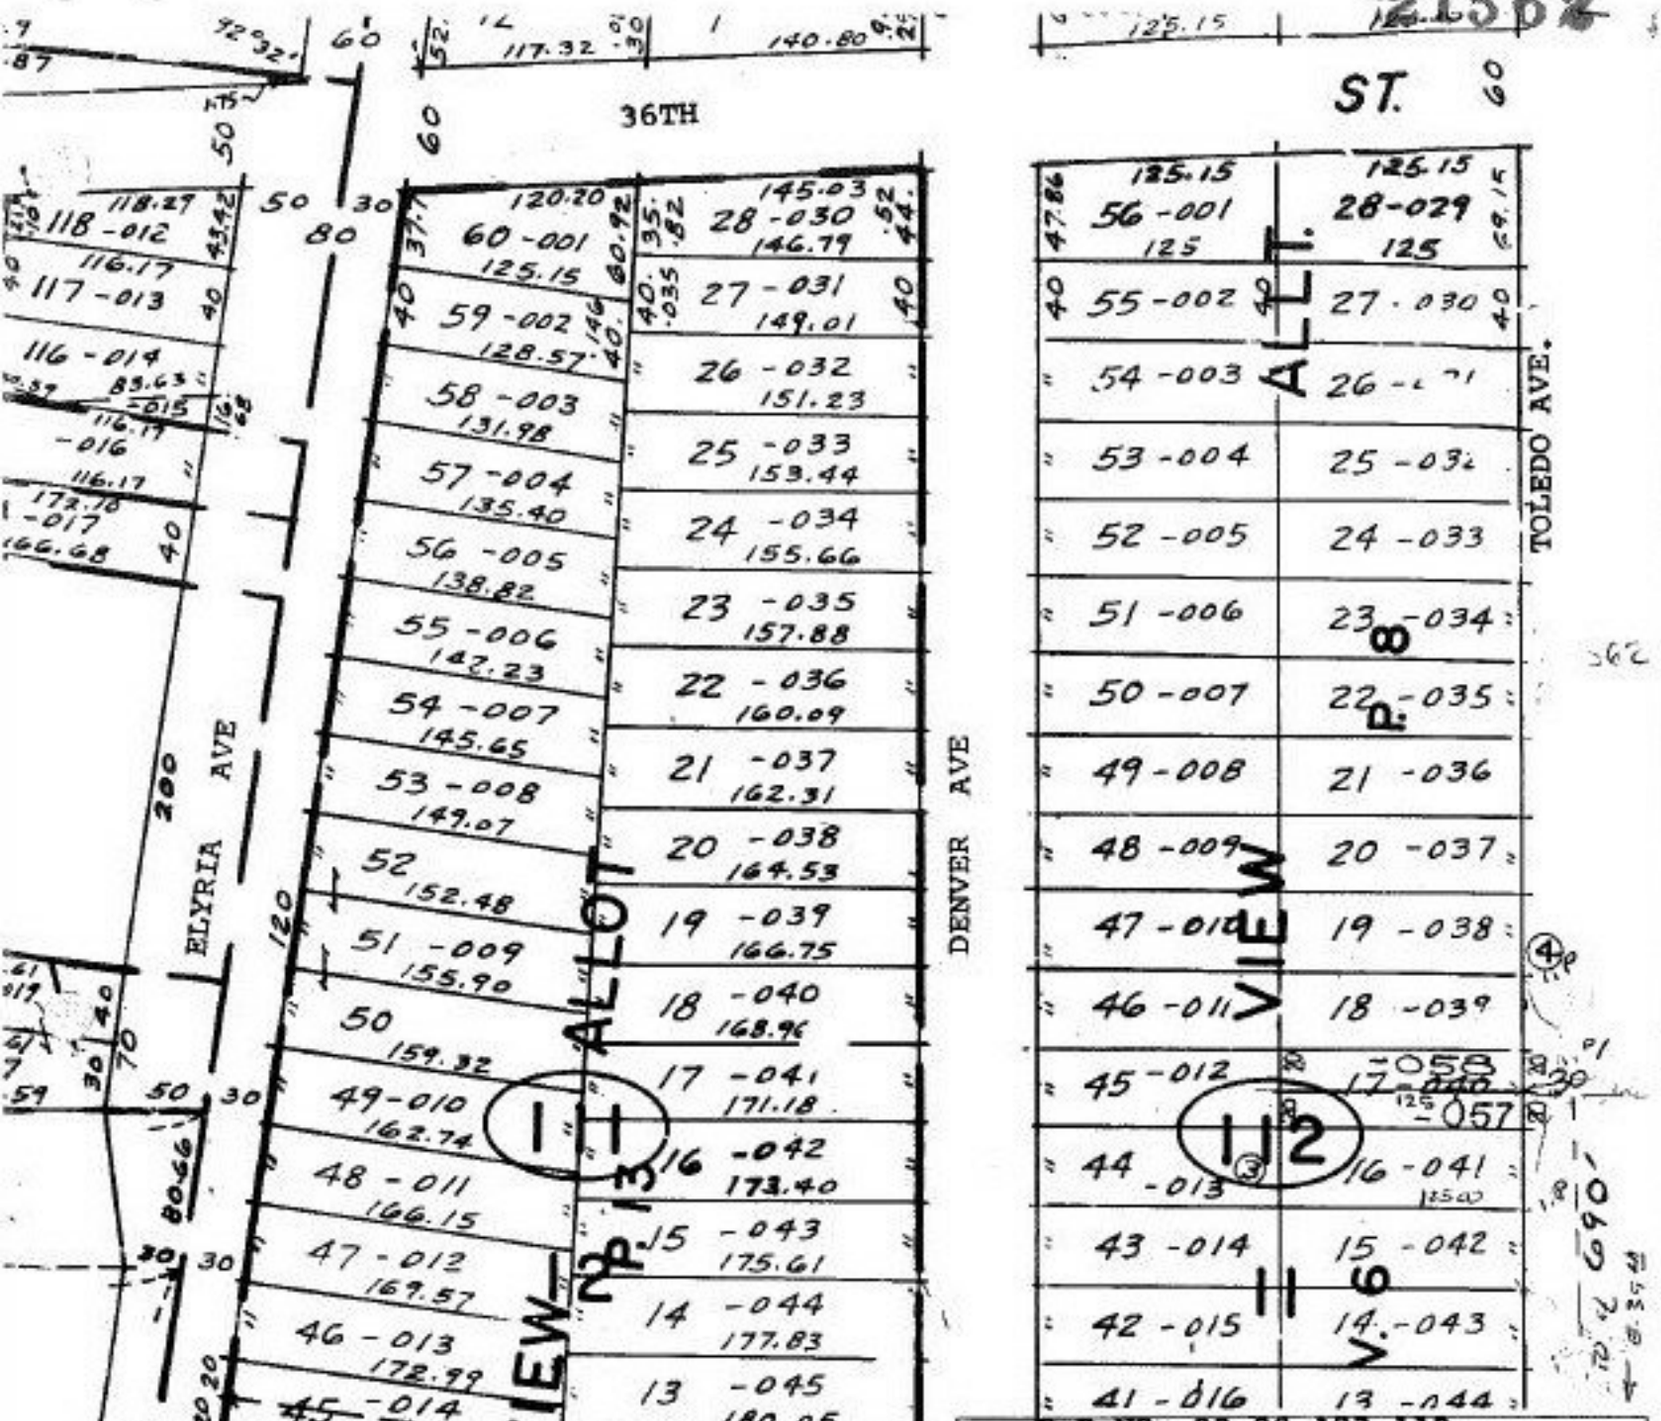

P.P.NO. 03-00-103-112-
PRIOR INST: OR 1002, P. 466
CLOSURE: 1:INF.
SURVEYED BY: BEMBA K. JONES
P.S. & ASSOC. INS. R.S. 7343

21562

APPROVED
LORAIN CO.
MAP DEPT

DATE 11-27-95

PAGE 3-00-103-A

BY CAROLYN FRANCIS

#21562