21563

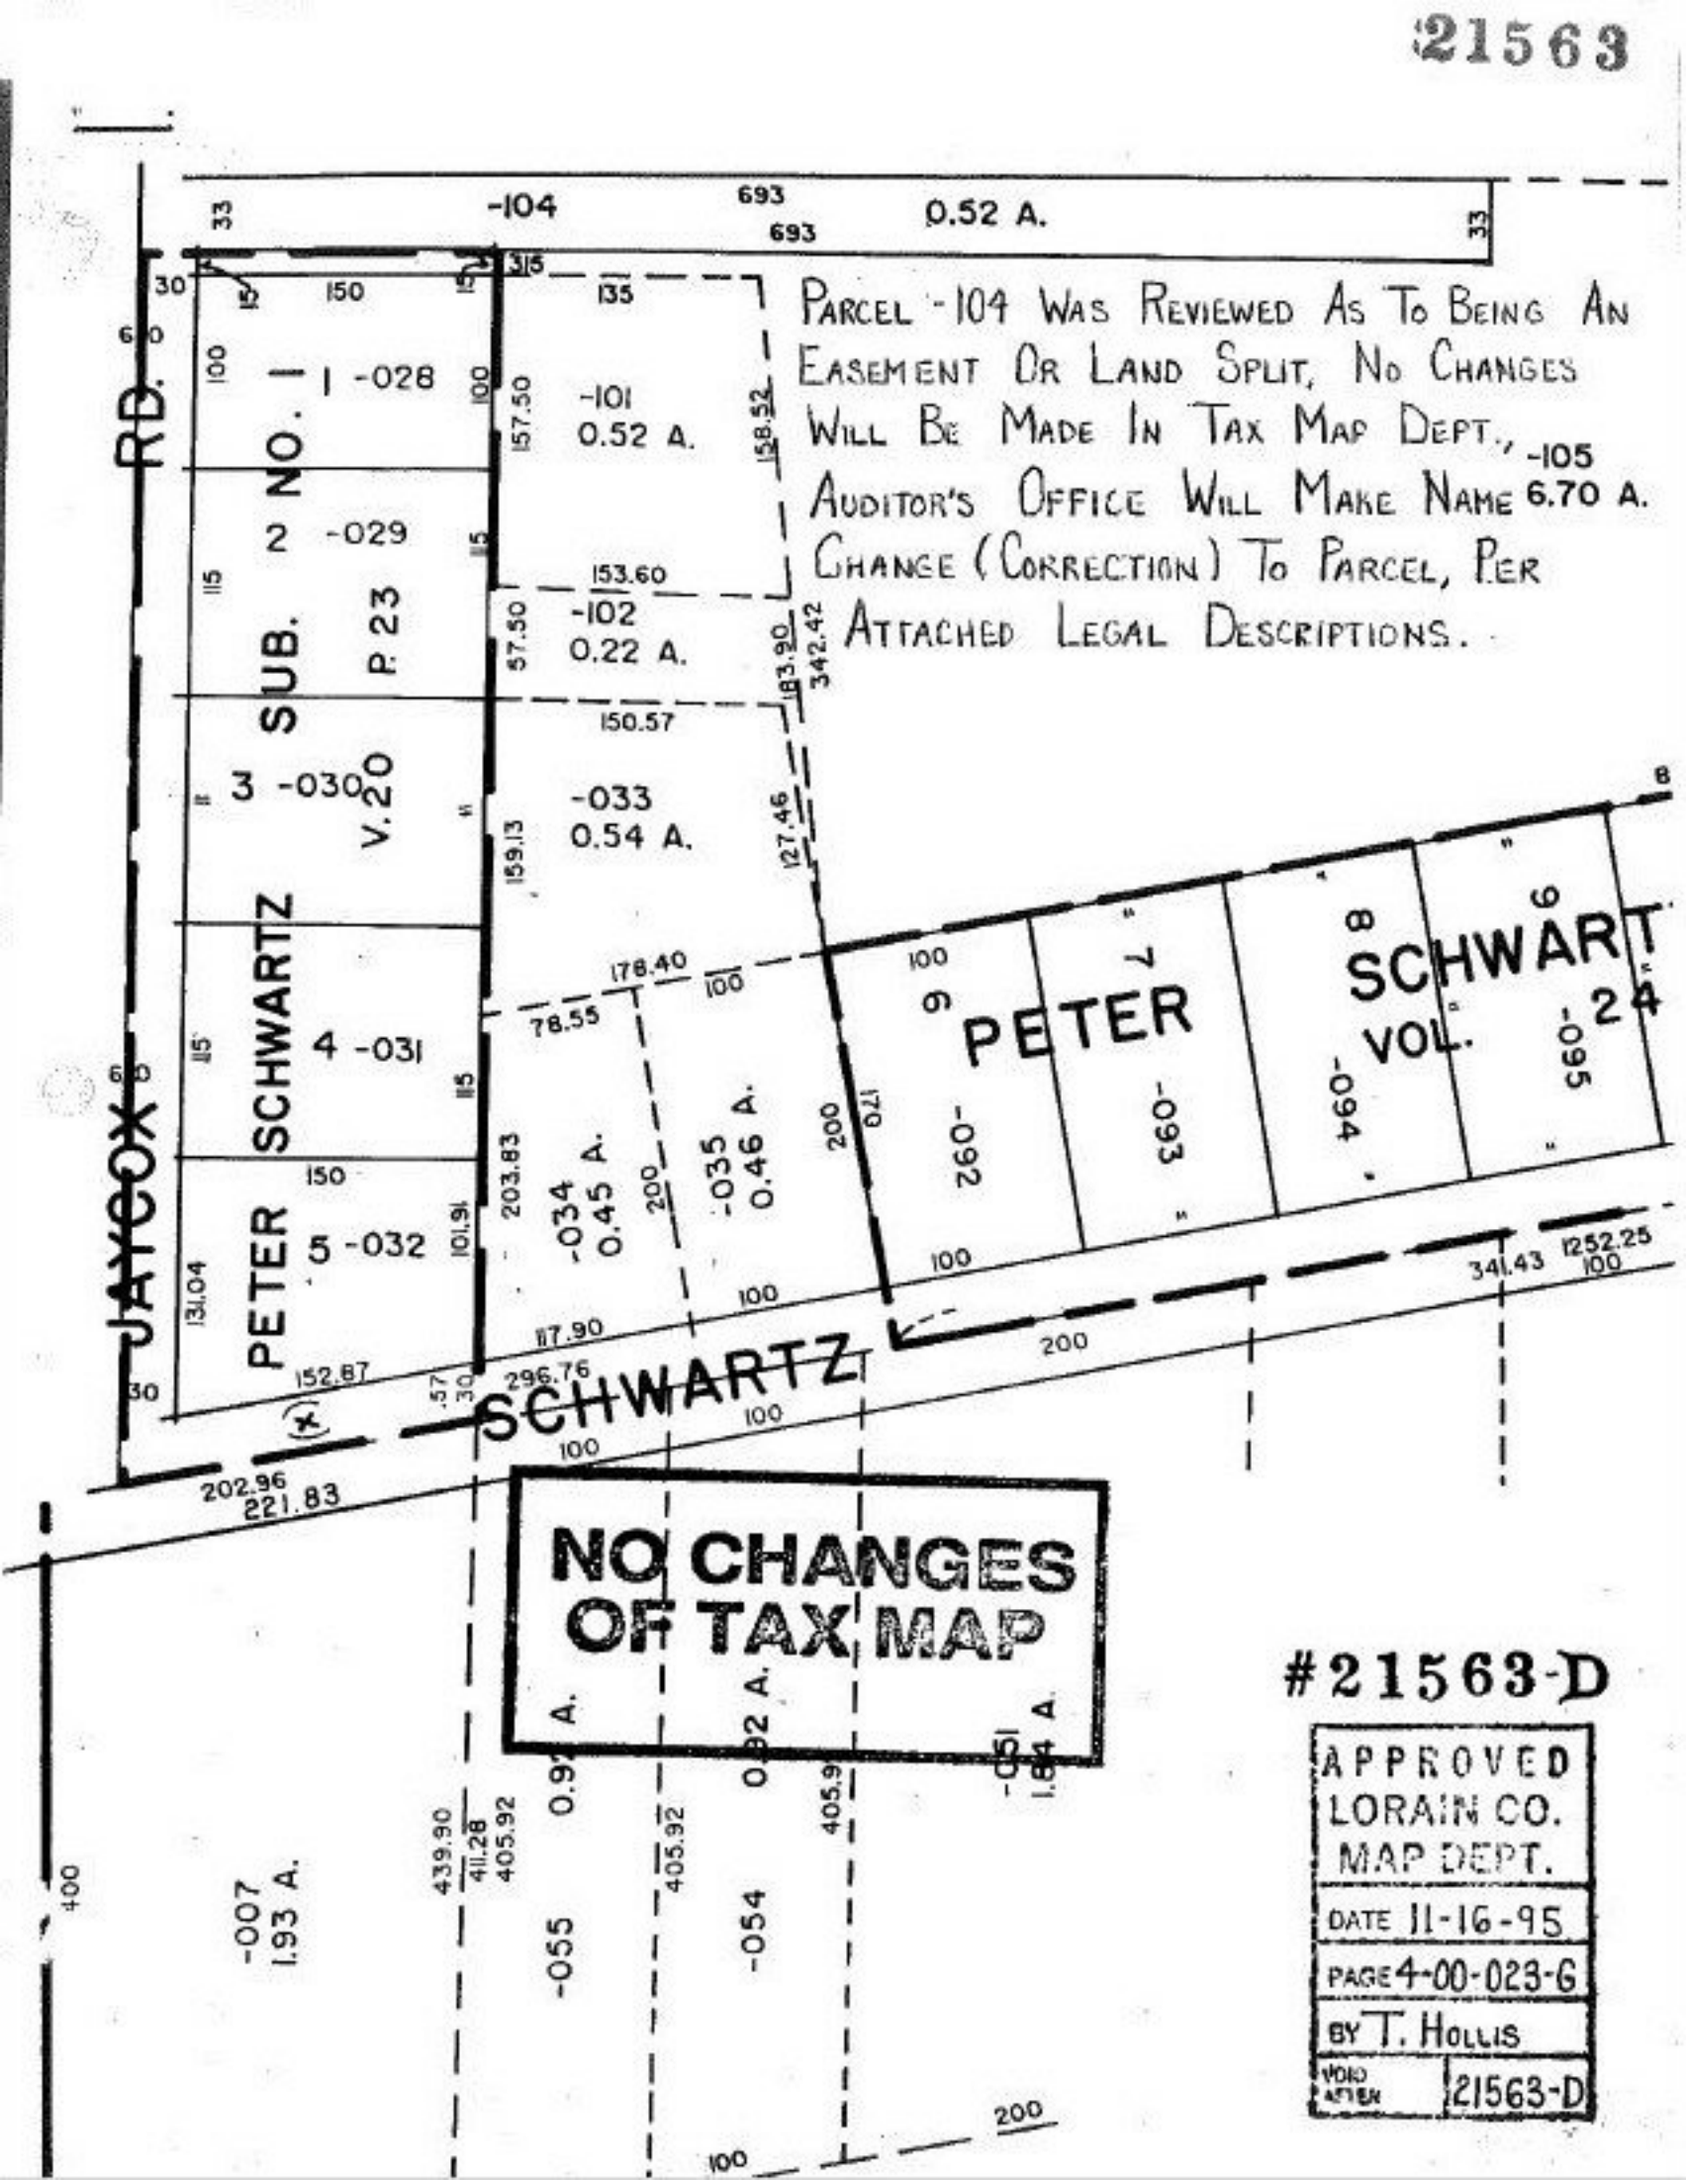

PARCEL -104 WAS REVIEWED AS TO BEING AN EASEMENT OR LAND SPLIT, NO CHANGES WILL BE MADE IN TAX MAP DEPT., AUDITOR'S OFFICE WILL MAKE NAME CHANGE (CORRECTION) TO PARCEL, PER ATTACHED LEGAL DESCRIPTIONS.

-105
6.70 A.

#21563-D

APPROVED LORAIN CO. MAP DEPT.	
DATE 11-16-95	
PAGE 4-00-023-G	
BY T. HOLLIS	
VOID AFTER	21563-D