21564

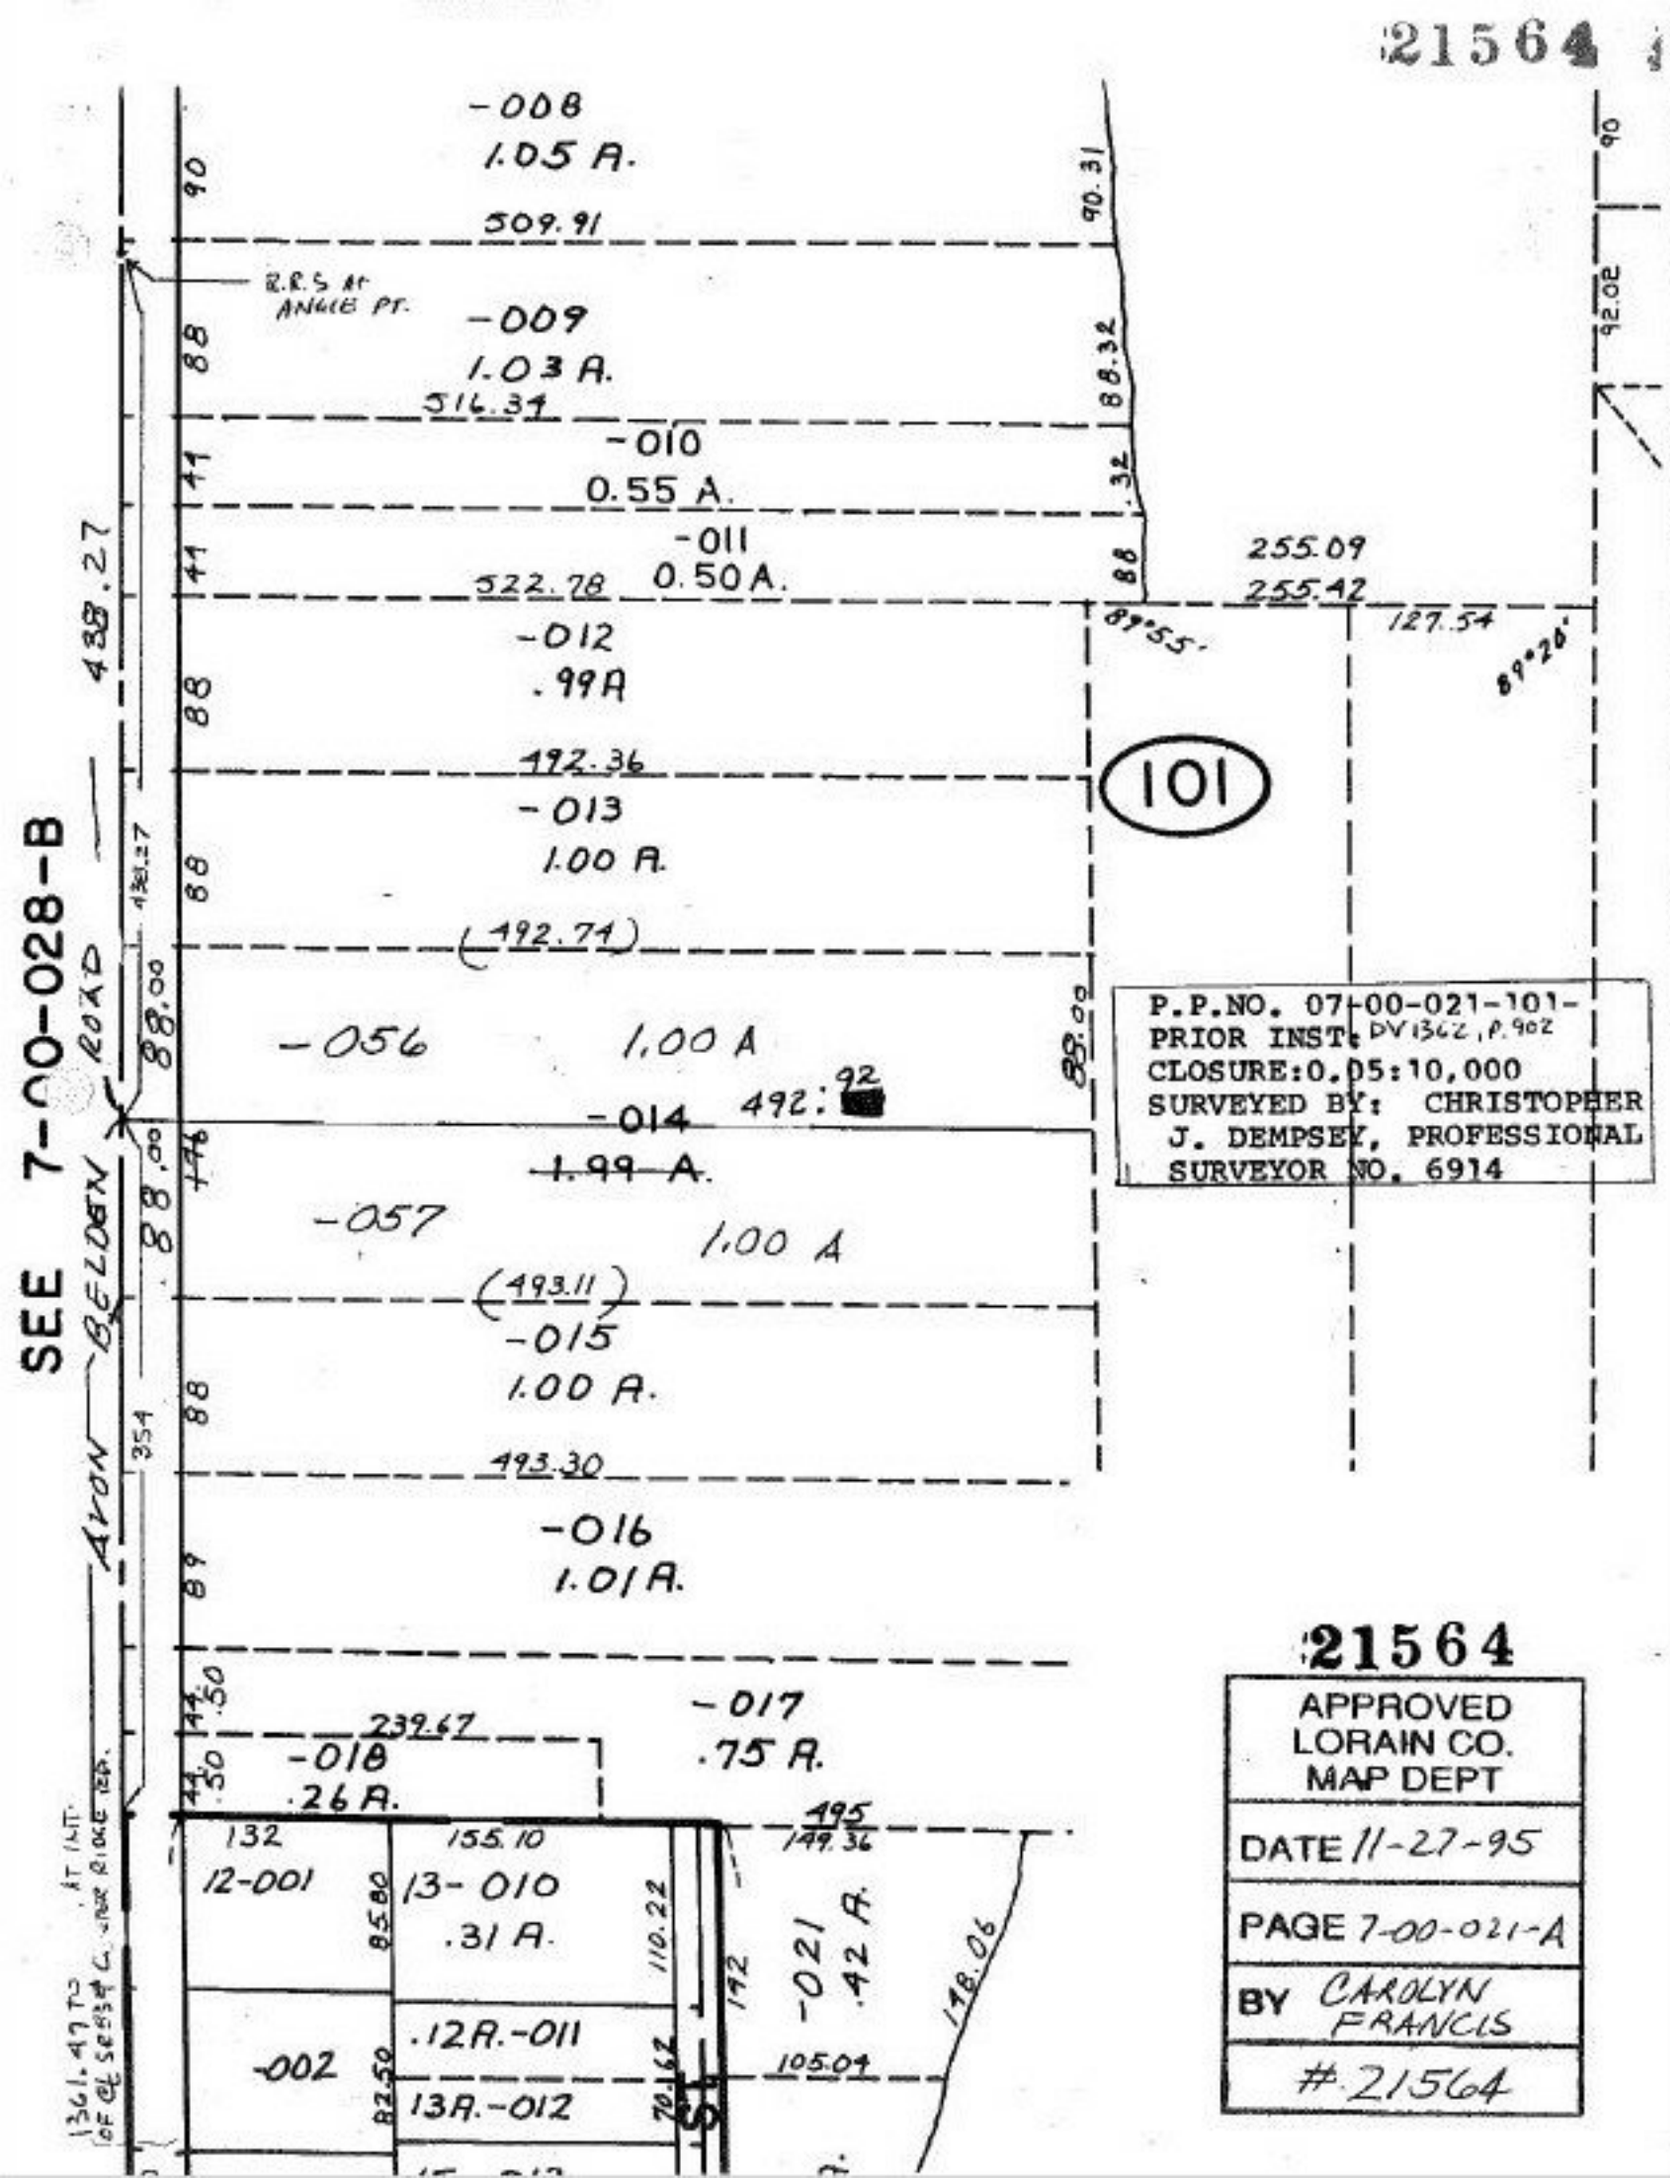

P.P.NO. 07-00-021-101-
PRIOR INST: DV1362, P.902
CLOSURE:0.05:10,000
SURVEYED BY: CHRISTOPHER J. DEMPSEY, PROFESSIONAL SURVEYOR NO. 6914

21564

APPROVED
LORAIN CO.
MAP DEPT

DATE 11-27-95

PAGE 7-00-021-A

BY CAROLYN FRANCIS

#21564