21565

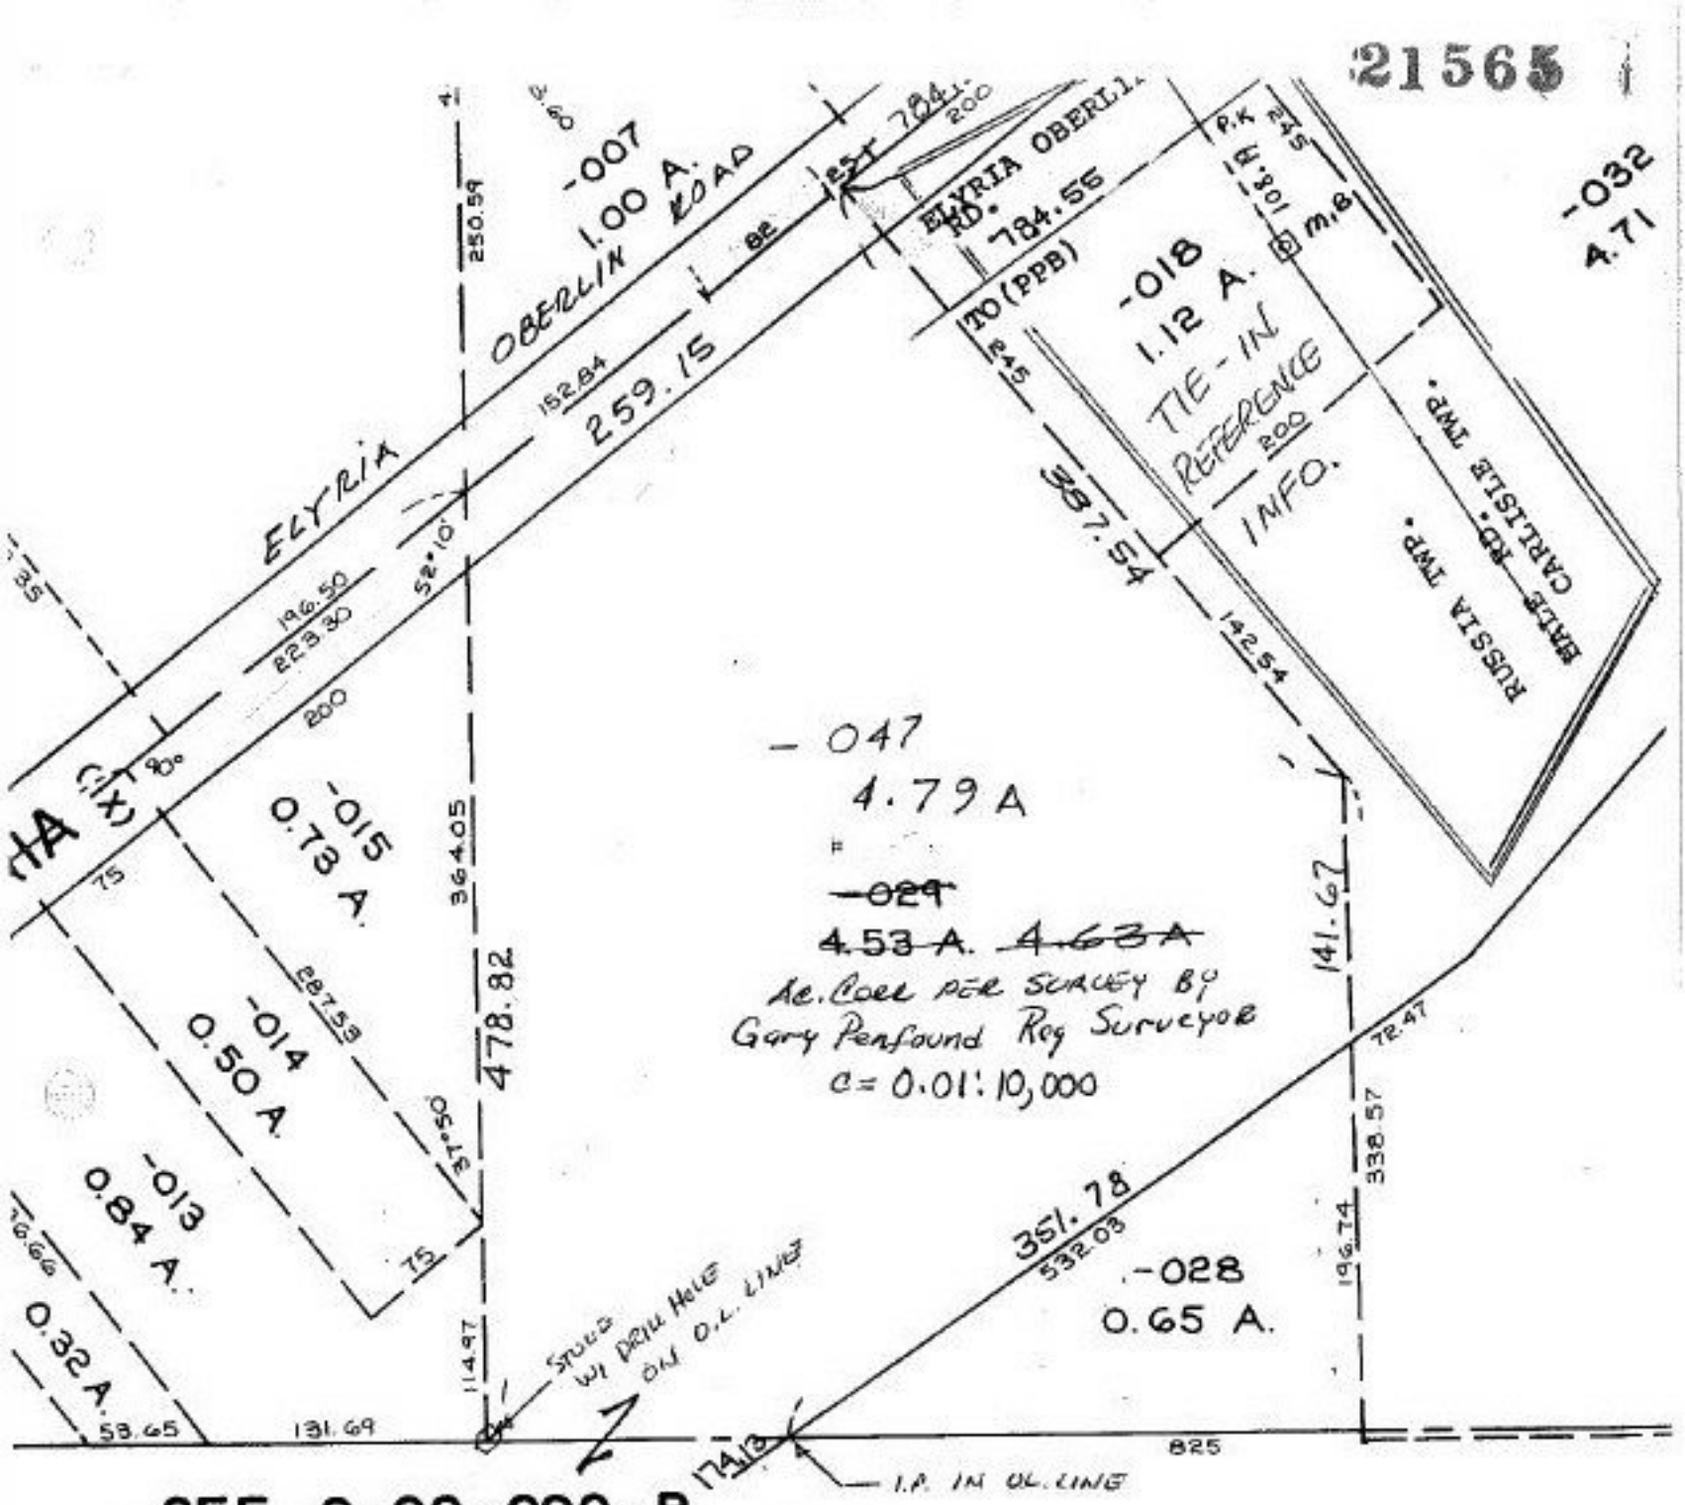

SEE 9-00-090-B

P.P.NO. 09-00-080-000 09-00-090-000
PRIOR INST: DV.930/600
SURVEYED BY: GARY PENFOUND
REG. SURVEYOR NO. 4457

21565

APPROVED
LORAIN CO.
MAP DEPT
DATE 11-28-95
PAGE 9-00-080-B
BY CAROLYN FRANCIS
#21565

I.P.

E. 1/2 L