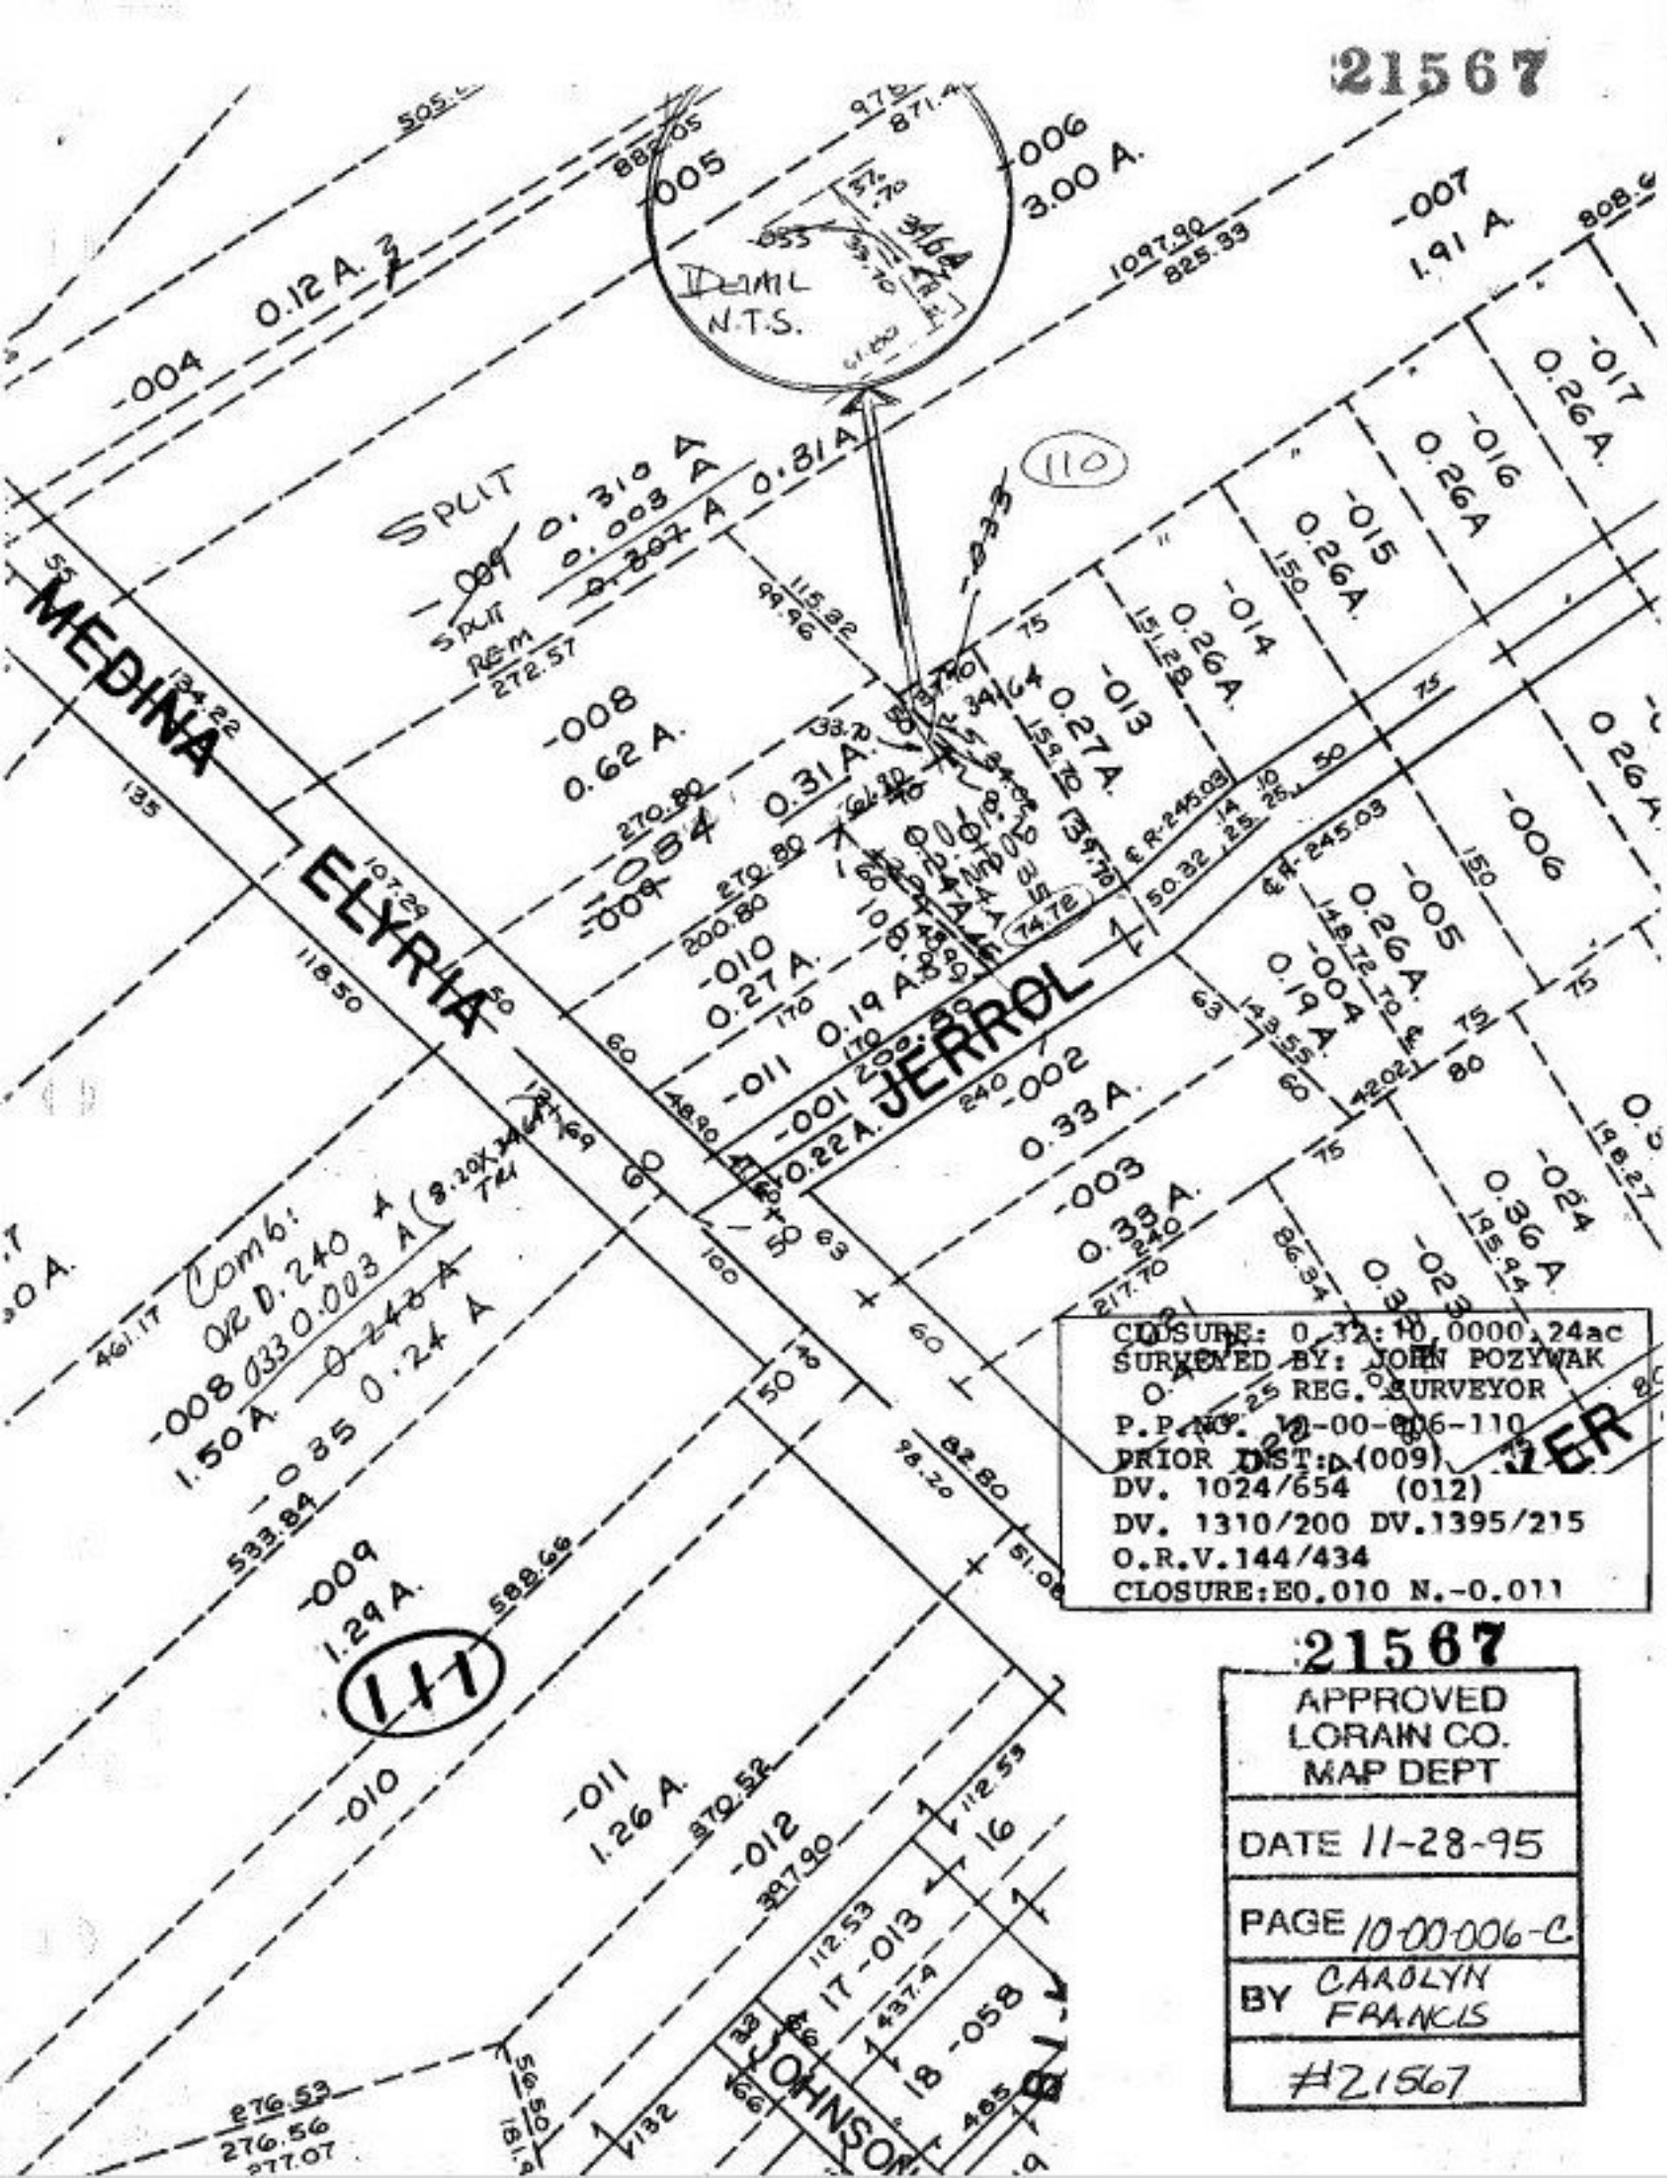

21567

APPROVED
LORAIN CO.
MAP DEPT

DATE 11-28-95

PAGE 10-00-006-C

BY CAROLYN FRANCIS

#21567