#21568

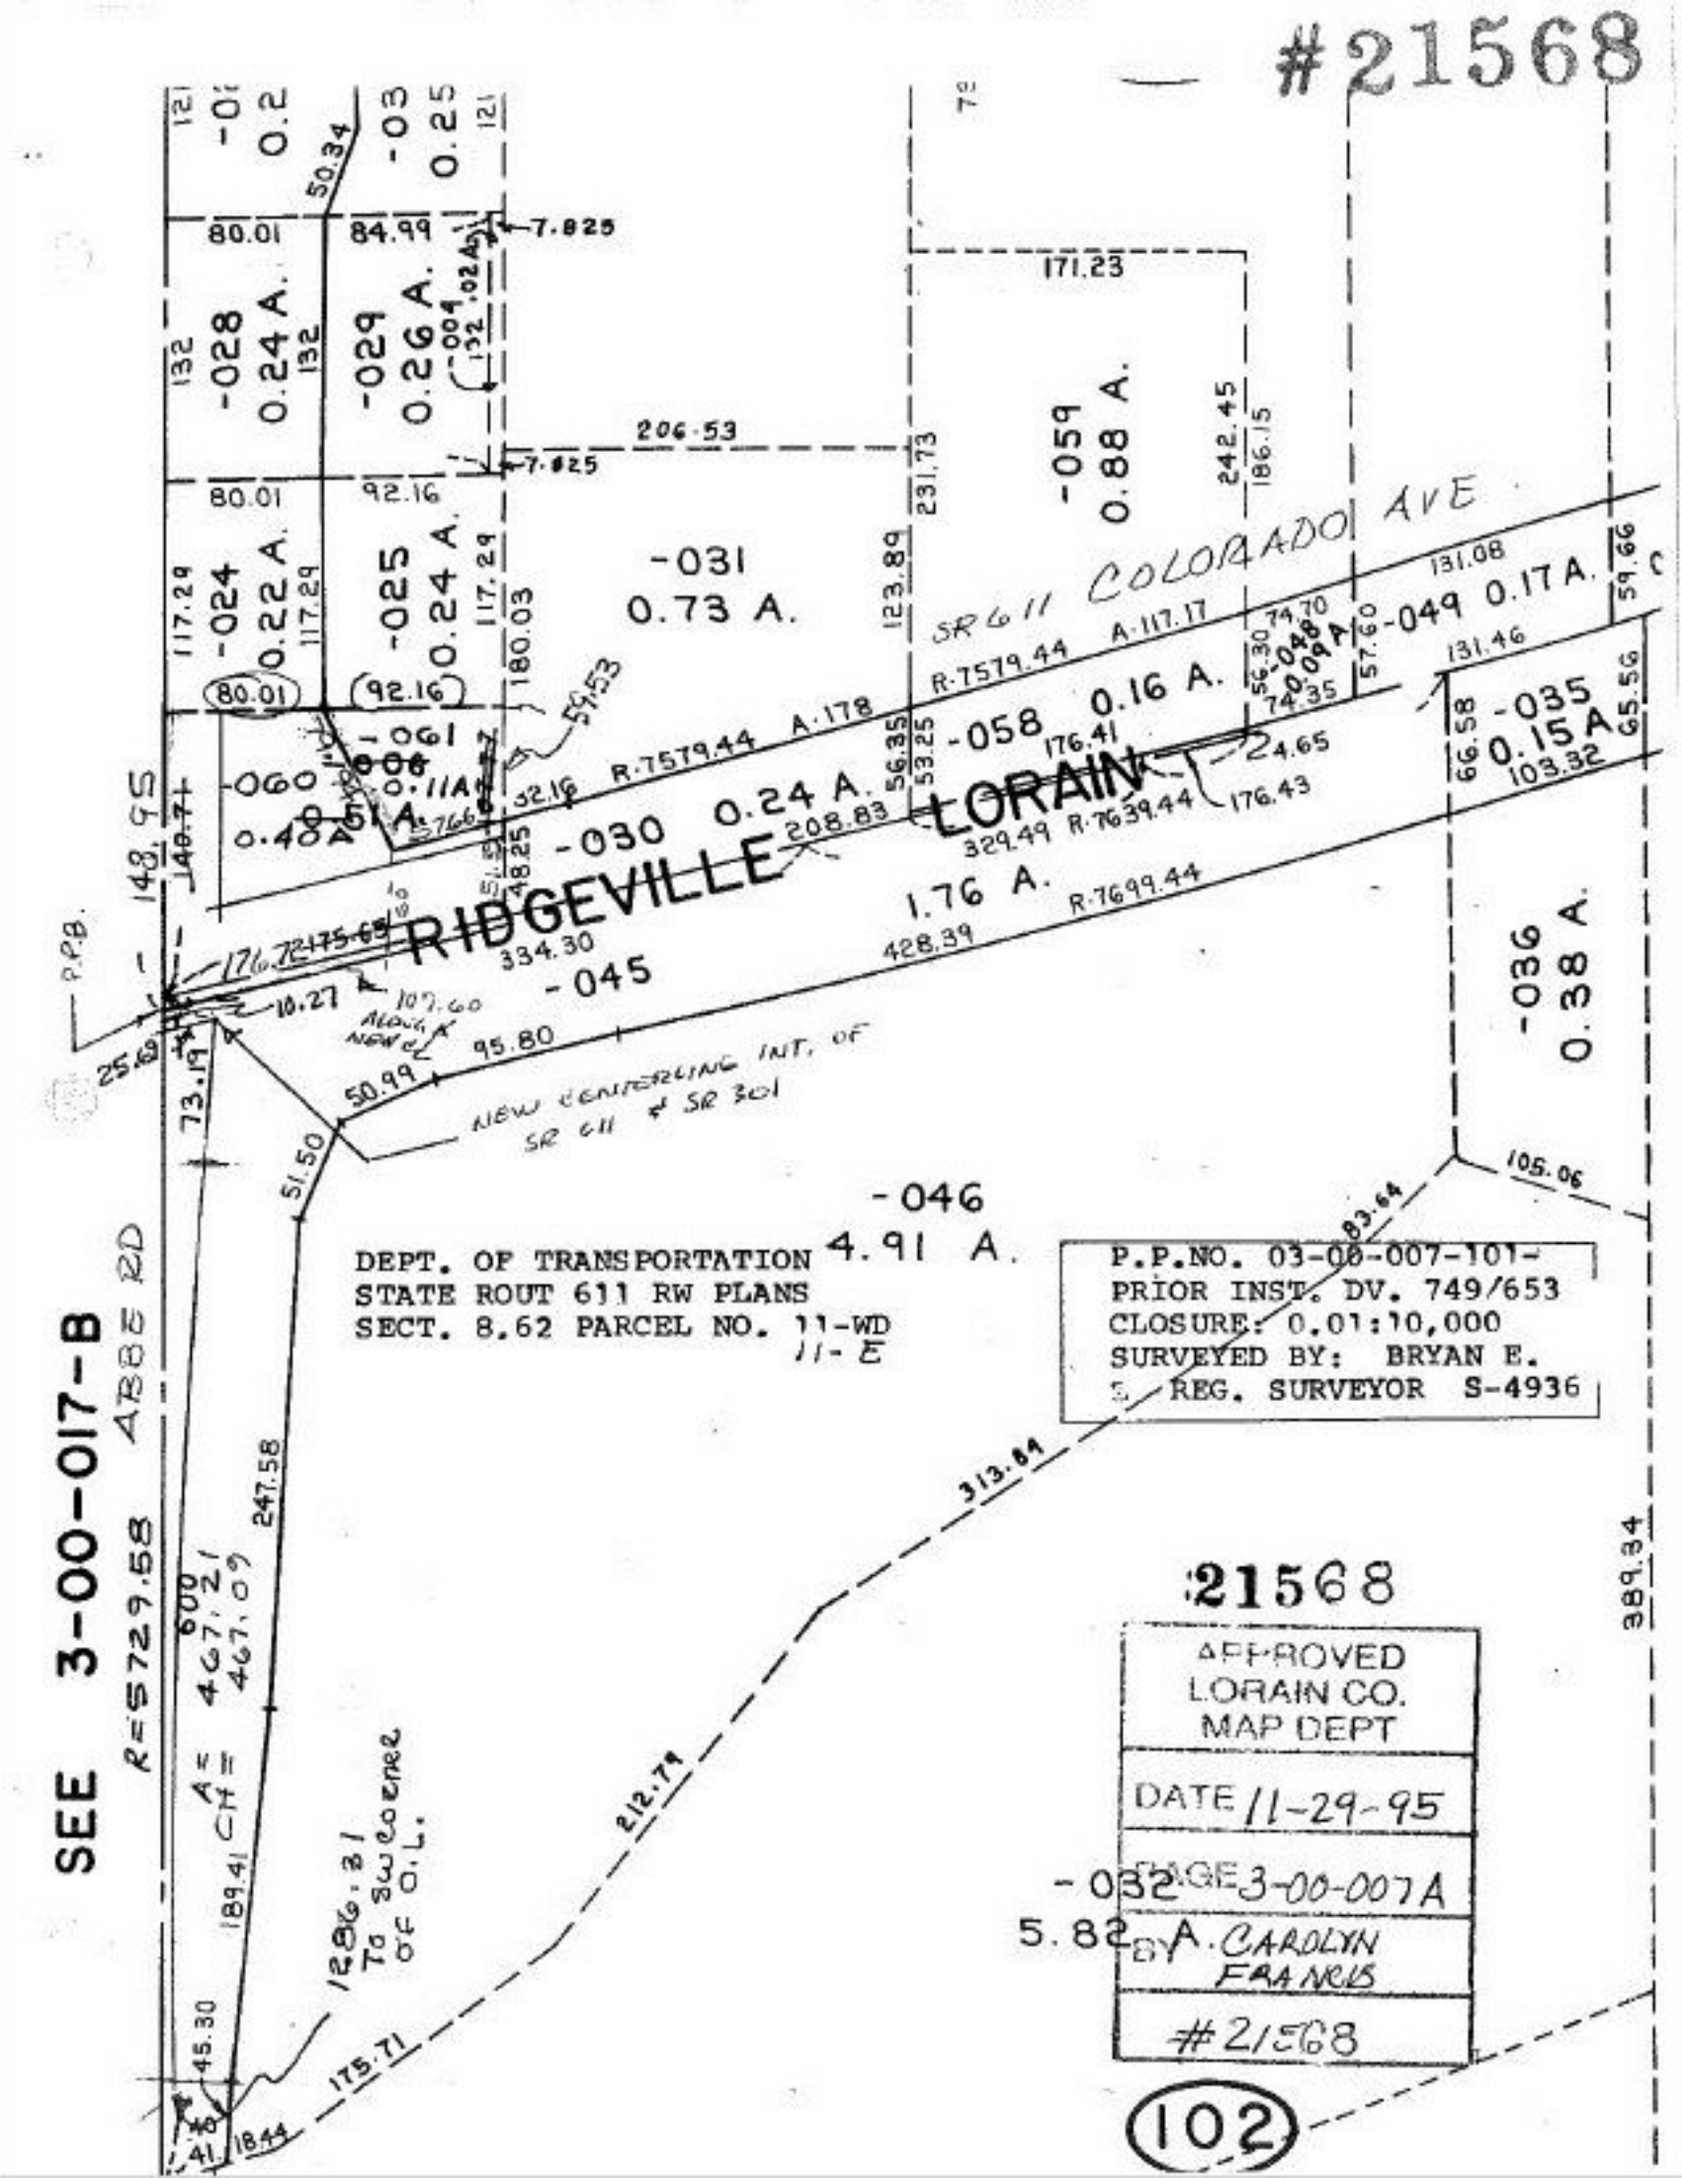

DEPT. OF TRANSPORTATION
STATE ROUT 611 RW PLANS
SECT. 8.62 PARCEL NO. 11-WD
11-E

P.P.NO. 03-00-007-101-
PRIOR INST. DV. 749/653
CLOSURE: 0.01:10,000
SURVEYED BY: BRYAN E.
REG. SURVEYOR S-4936

21568

APPROVED
LORAIN CO.
MAP DEPT

DATE 11-29-95

PAGE 3-00-007A

BY A. CAROLYN FRANCIS

#21568

102