21572

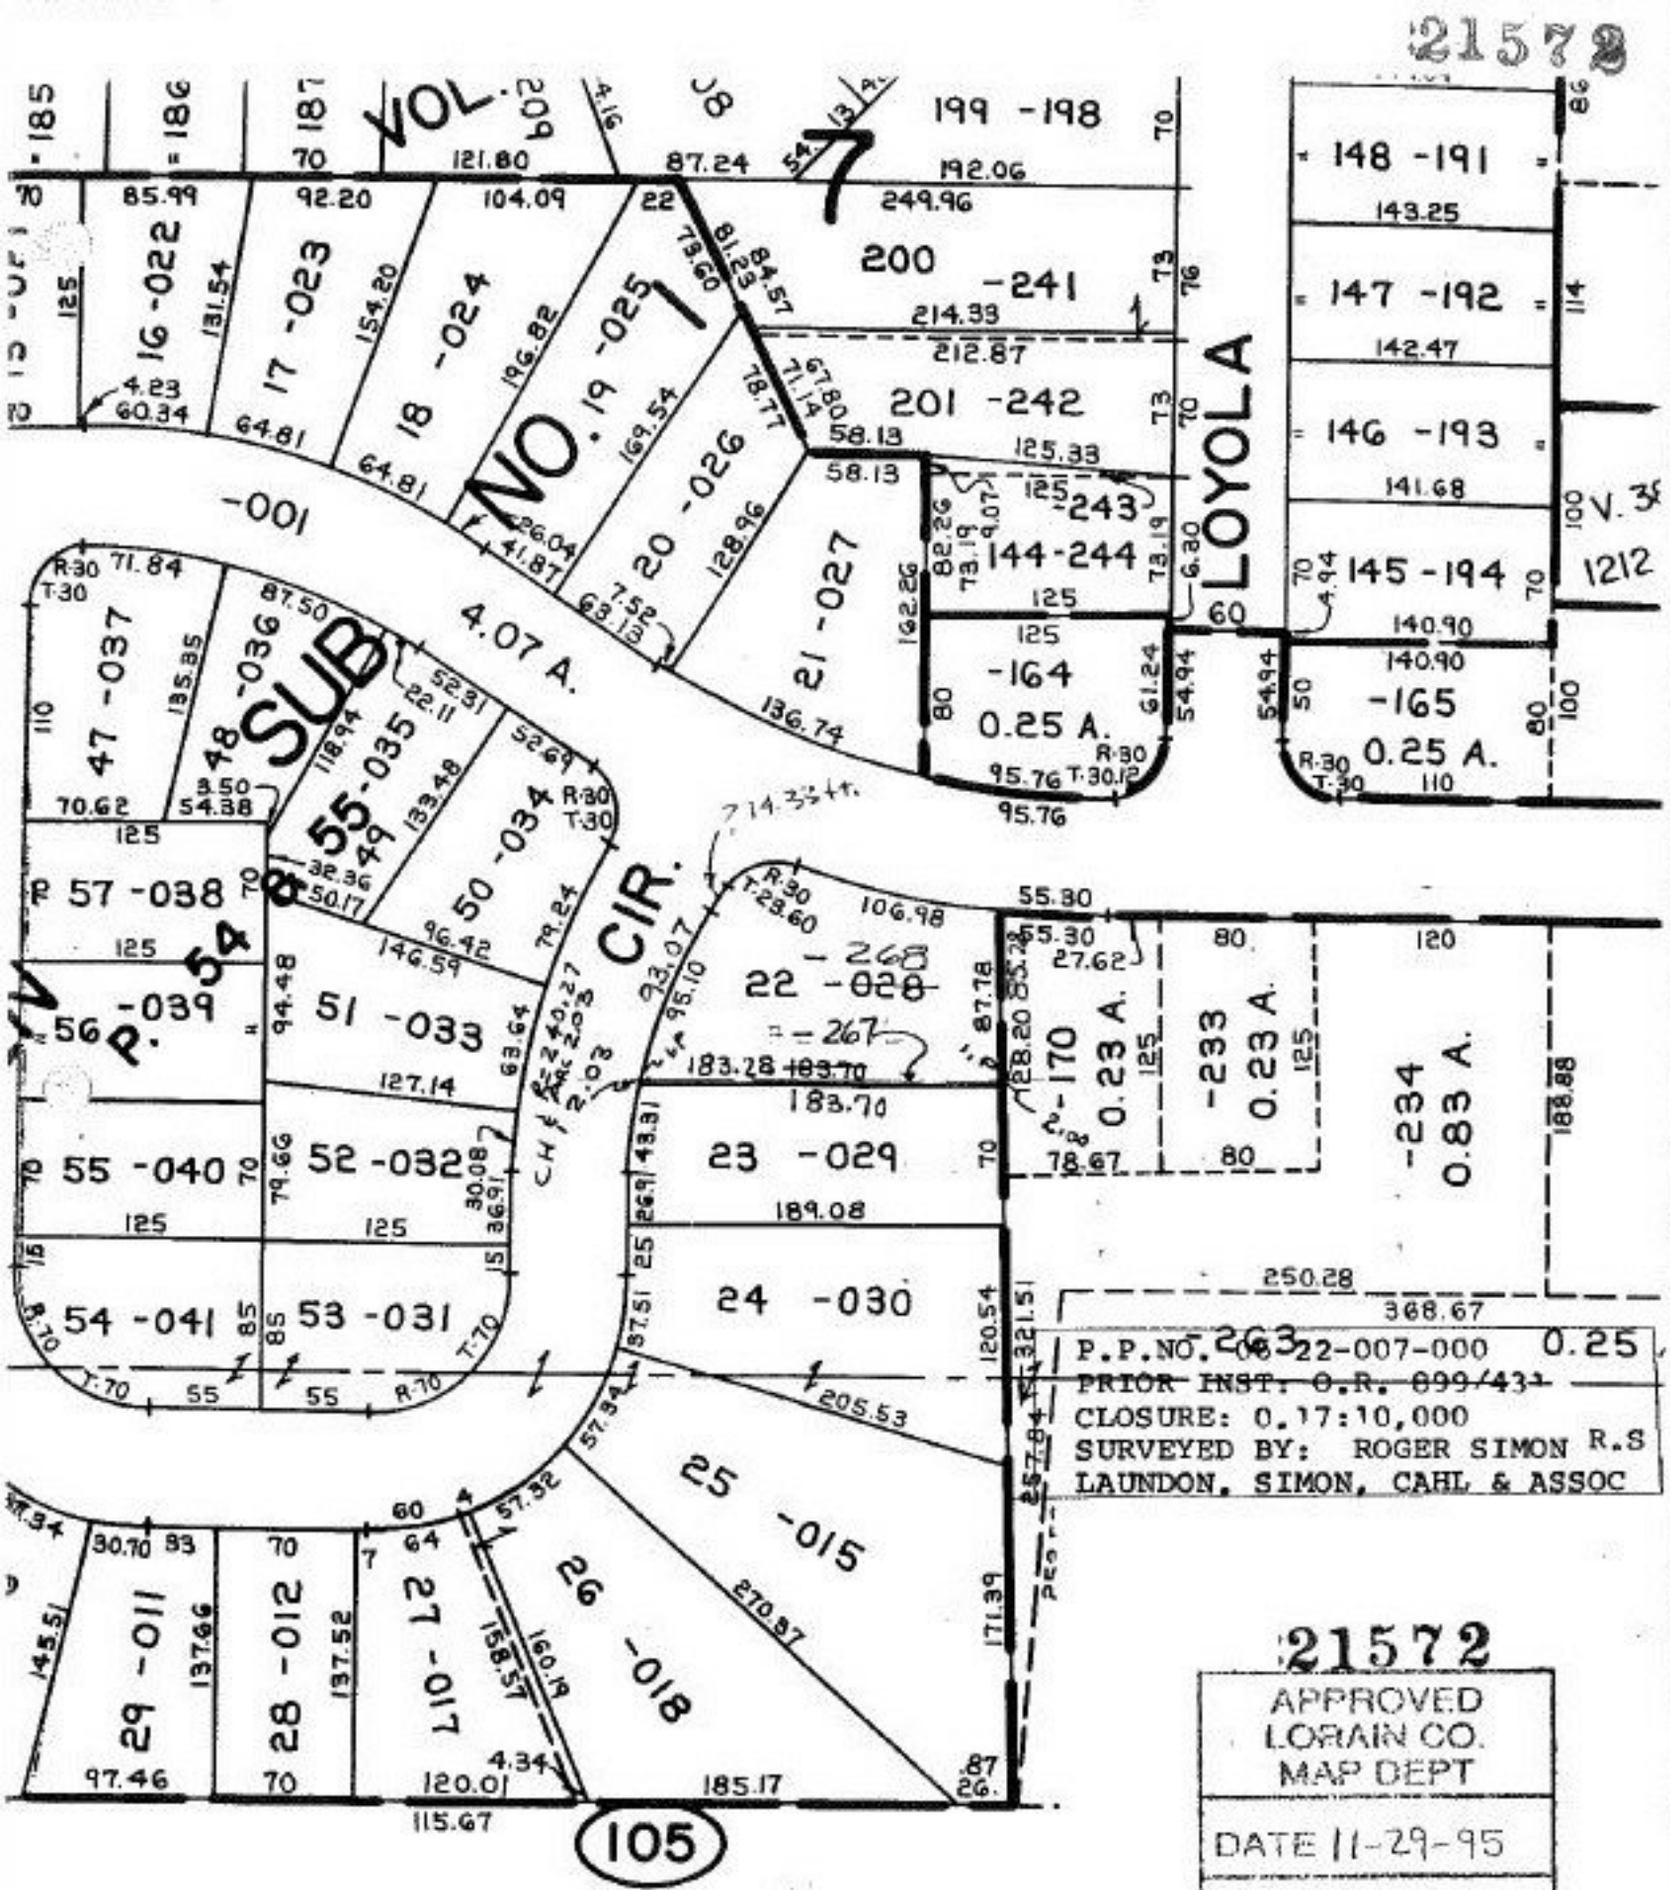

P.P.NO. 08-22-007-000 0.25
~~PRIOR INST. O.R. 099/43~~
CLOSURE: 0.17:10,000
SURVEYED BY: ROGER SIMON R.S
LAUNDON, SIMON, CAHL & ASSOC

21572

APPROVED
LORAIN CO.
MAP DEPT

DATE 11-29-95

PAGE 6-16

BY CAROLYN FRANCIS

#21572

5