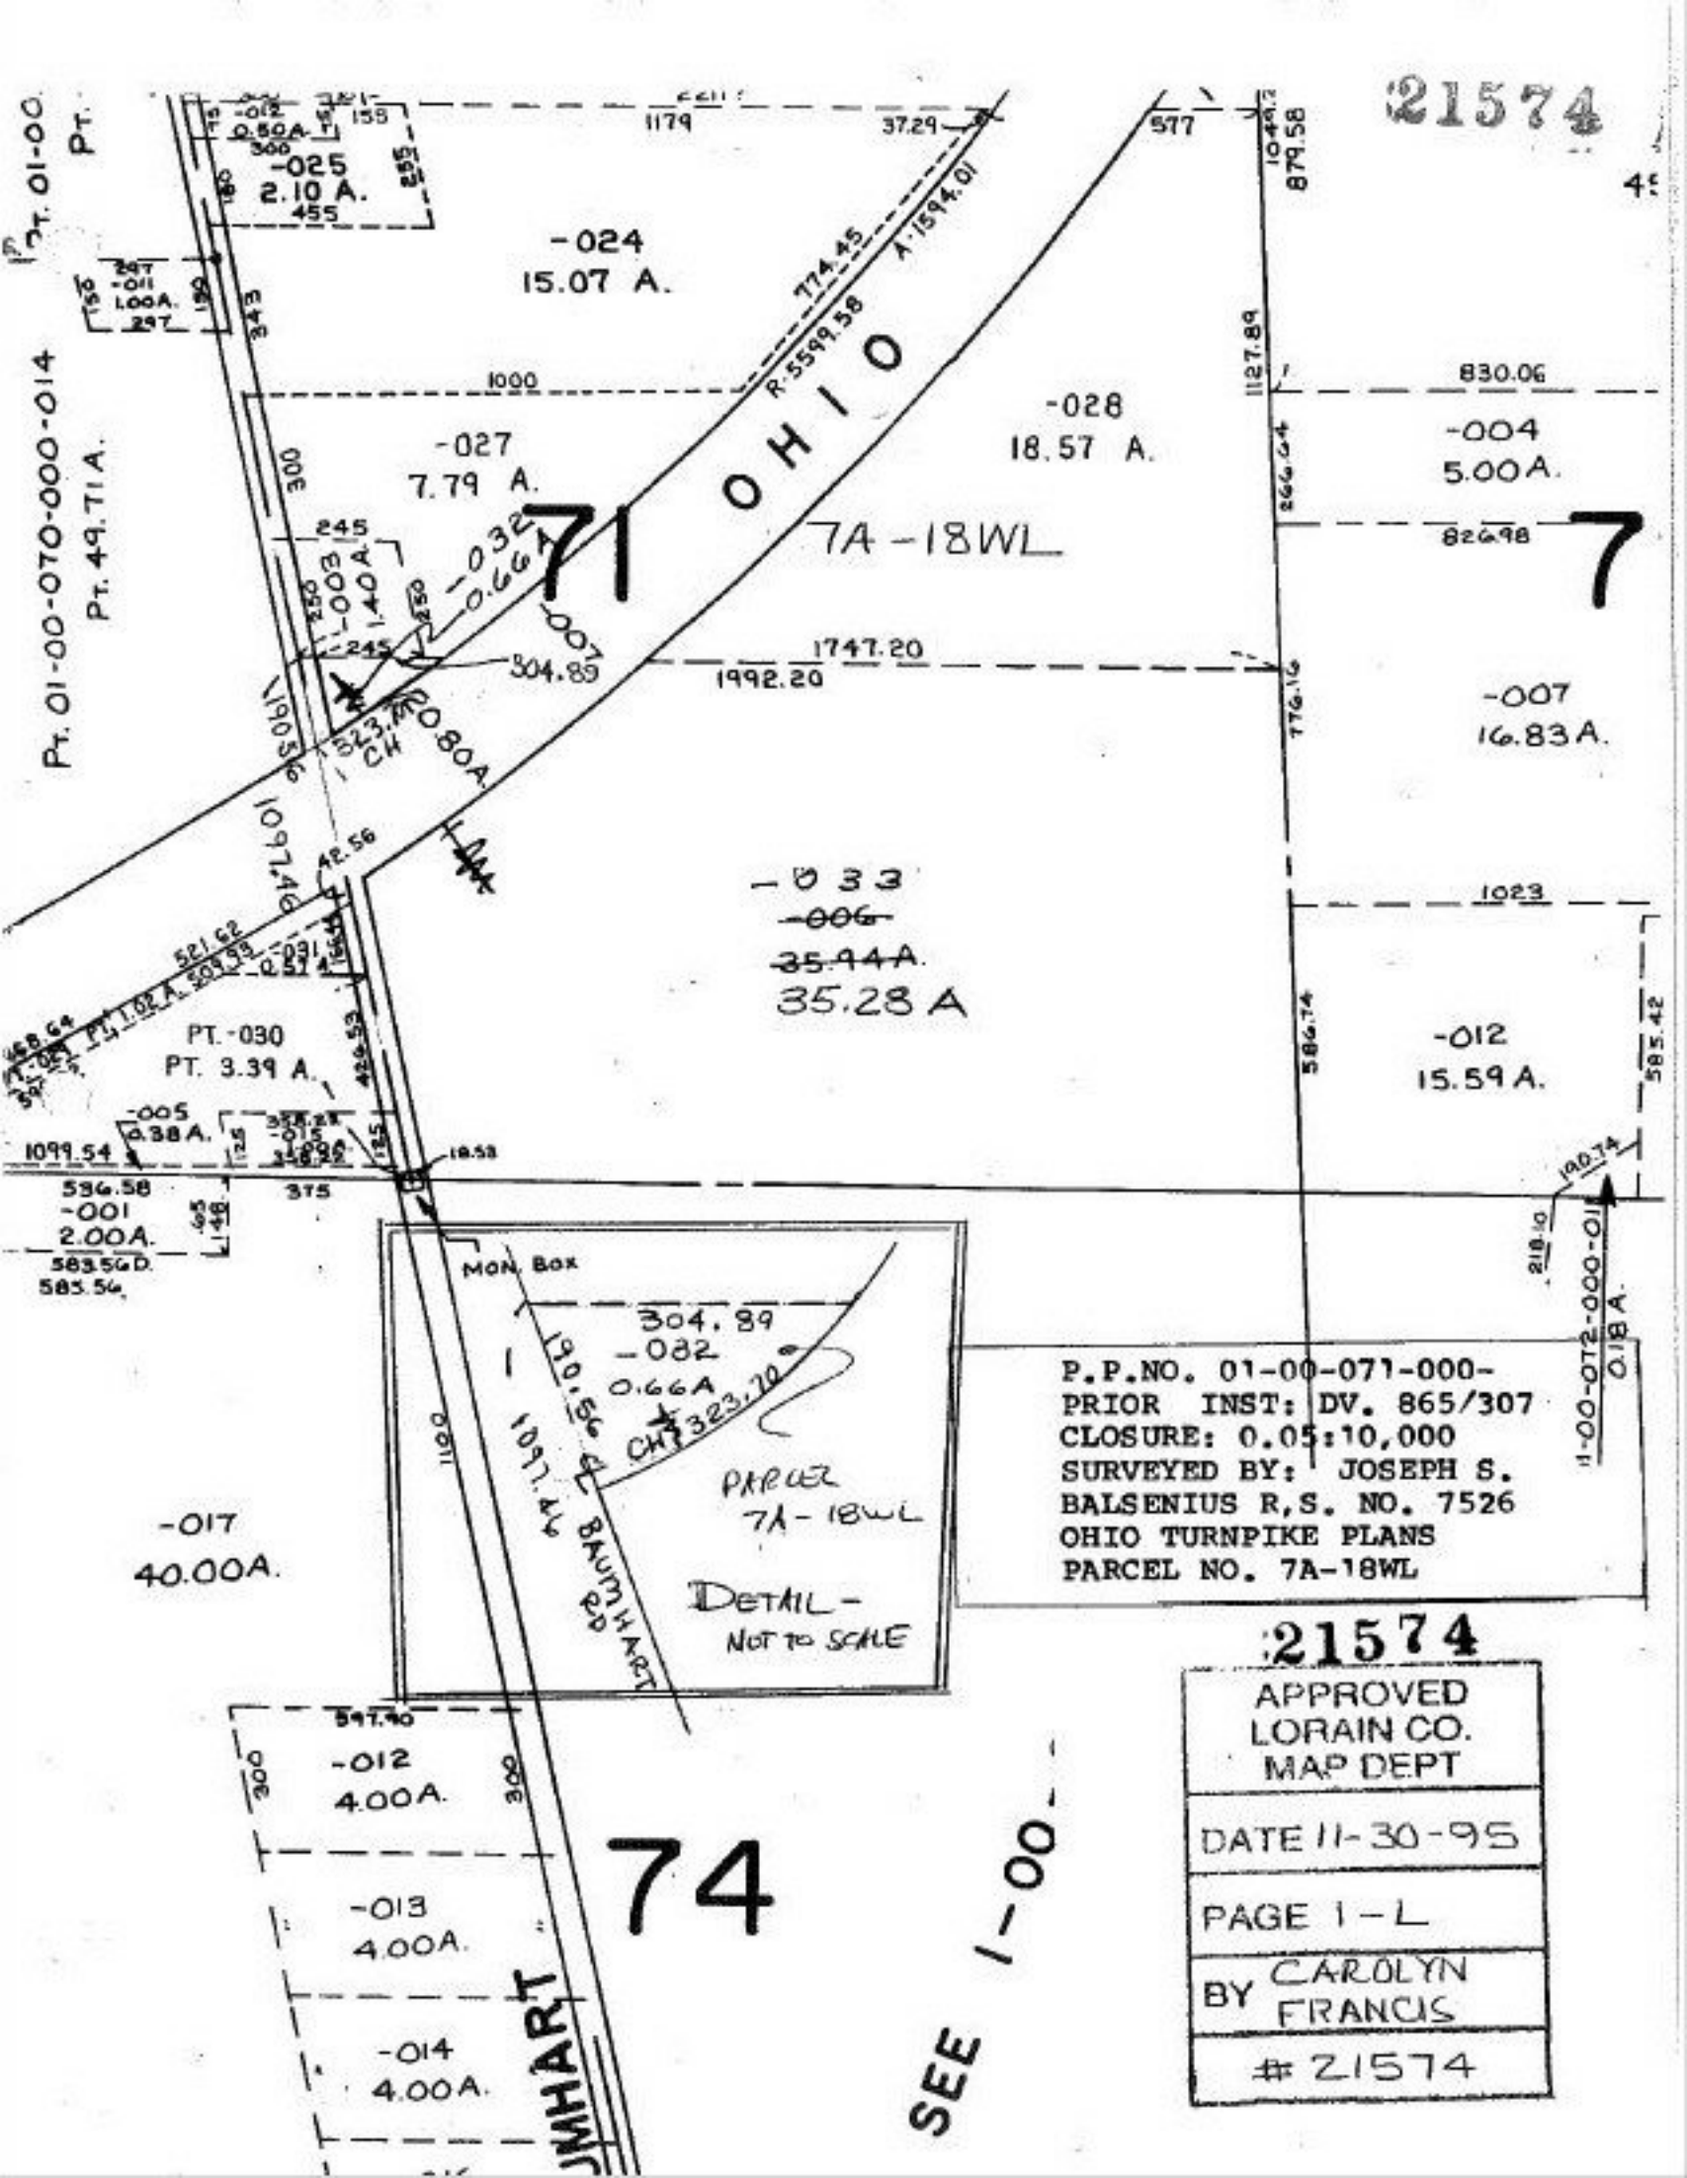
21574
Pt. 01-00
Pt. 01-00-070-000-014
Pt. 49.71 A.
-025
2.10 A.
-024
15.07 A.
-011
1.00A.
-027
7.79 A.
-003
1.40A.
-032
0.66A
-028
18.57 A.
-004
5.00A.
-007
16.83A.
OHIO
7A-18WL
7
1179
37.29
577
879.58
1044.2
774.45
R-5599.58
Δ 1594.01
1000
1127.89
830.06
266.64
826.98
300
245
304.89
1747.20
1992.20
776.16
1907.40
42.56
823.80A
CH
-033
-006
35.94A.
35.28 A
1023
586.74
-012
15.59A.
585.42
PT.-030
PT. 3.39 A.
-005
0.38A.
1099.54
536.58
-001
2.00A.
583.54D.
583.54
375
18.53
190.74
218.10
MON. Box
304.89
-032
0.66A
CH 323.70'
190.56
1097.46
BAUMHART RD
PARCEL
7A-18WL
DETAIL-
NOT TO SCALE
P.P.NO. 01-00-071-000-
PRIOR INST: DV. 865/307
CLOSURE: 0.05:10,000
SURVEYED BY: JOSEPH S.
BALSENIUS R,S. NO. 7526
OHIO TURNPIKE PLANS
PARCEL NO. 7A-18WL
-017
40.00A.
597.40
-012
4.00A.
-013
4.00A.
-014
4.00A.
74
BAUMHART
SEE 1-00-
21574
APPROVED
LORAIN CO.
MAP DEPT
DATE 11-30-95
PAGE 1-L
BY CAROLYN
FRANCIS
21574