21582-D

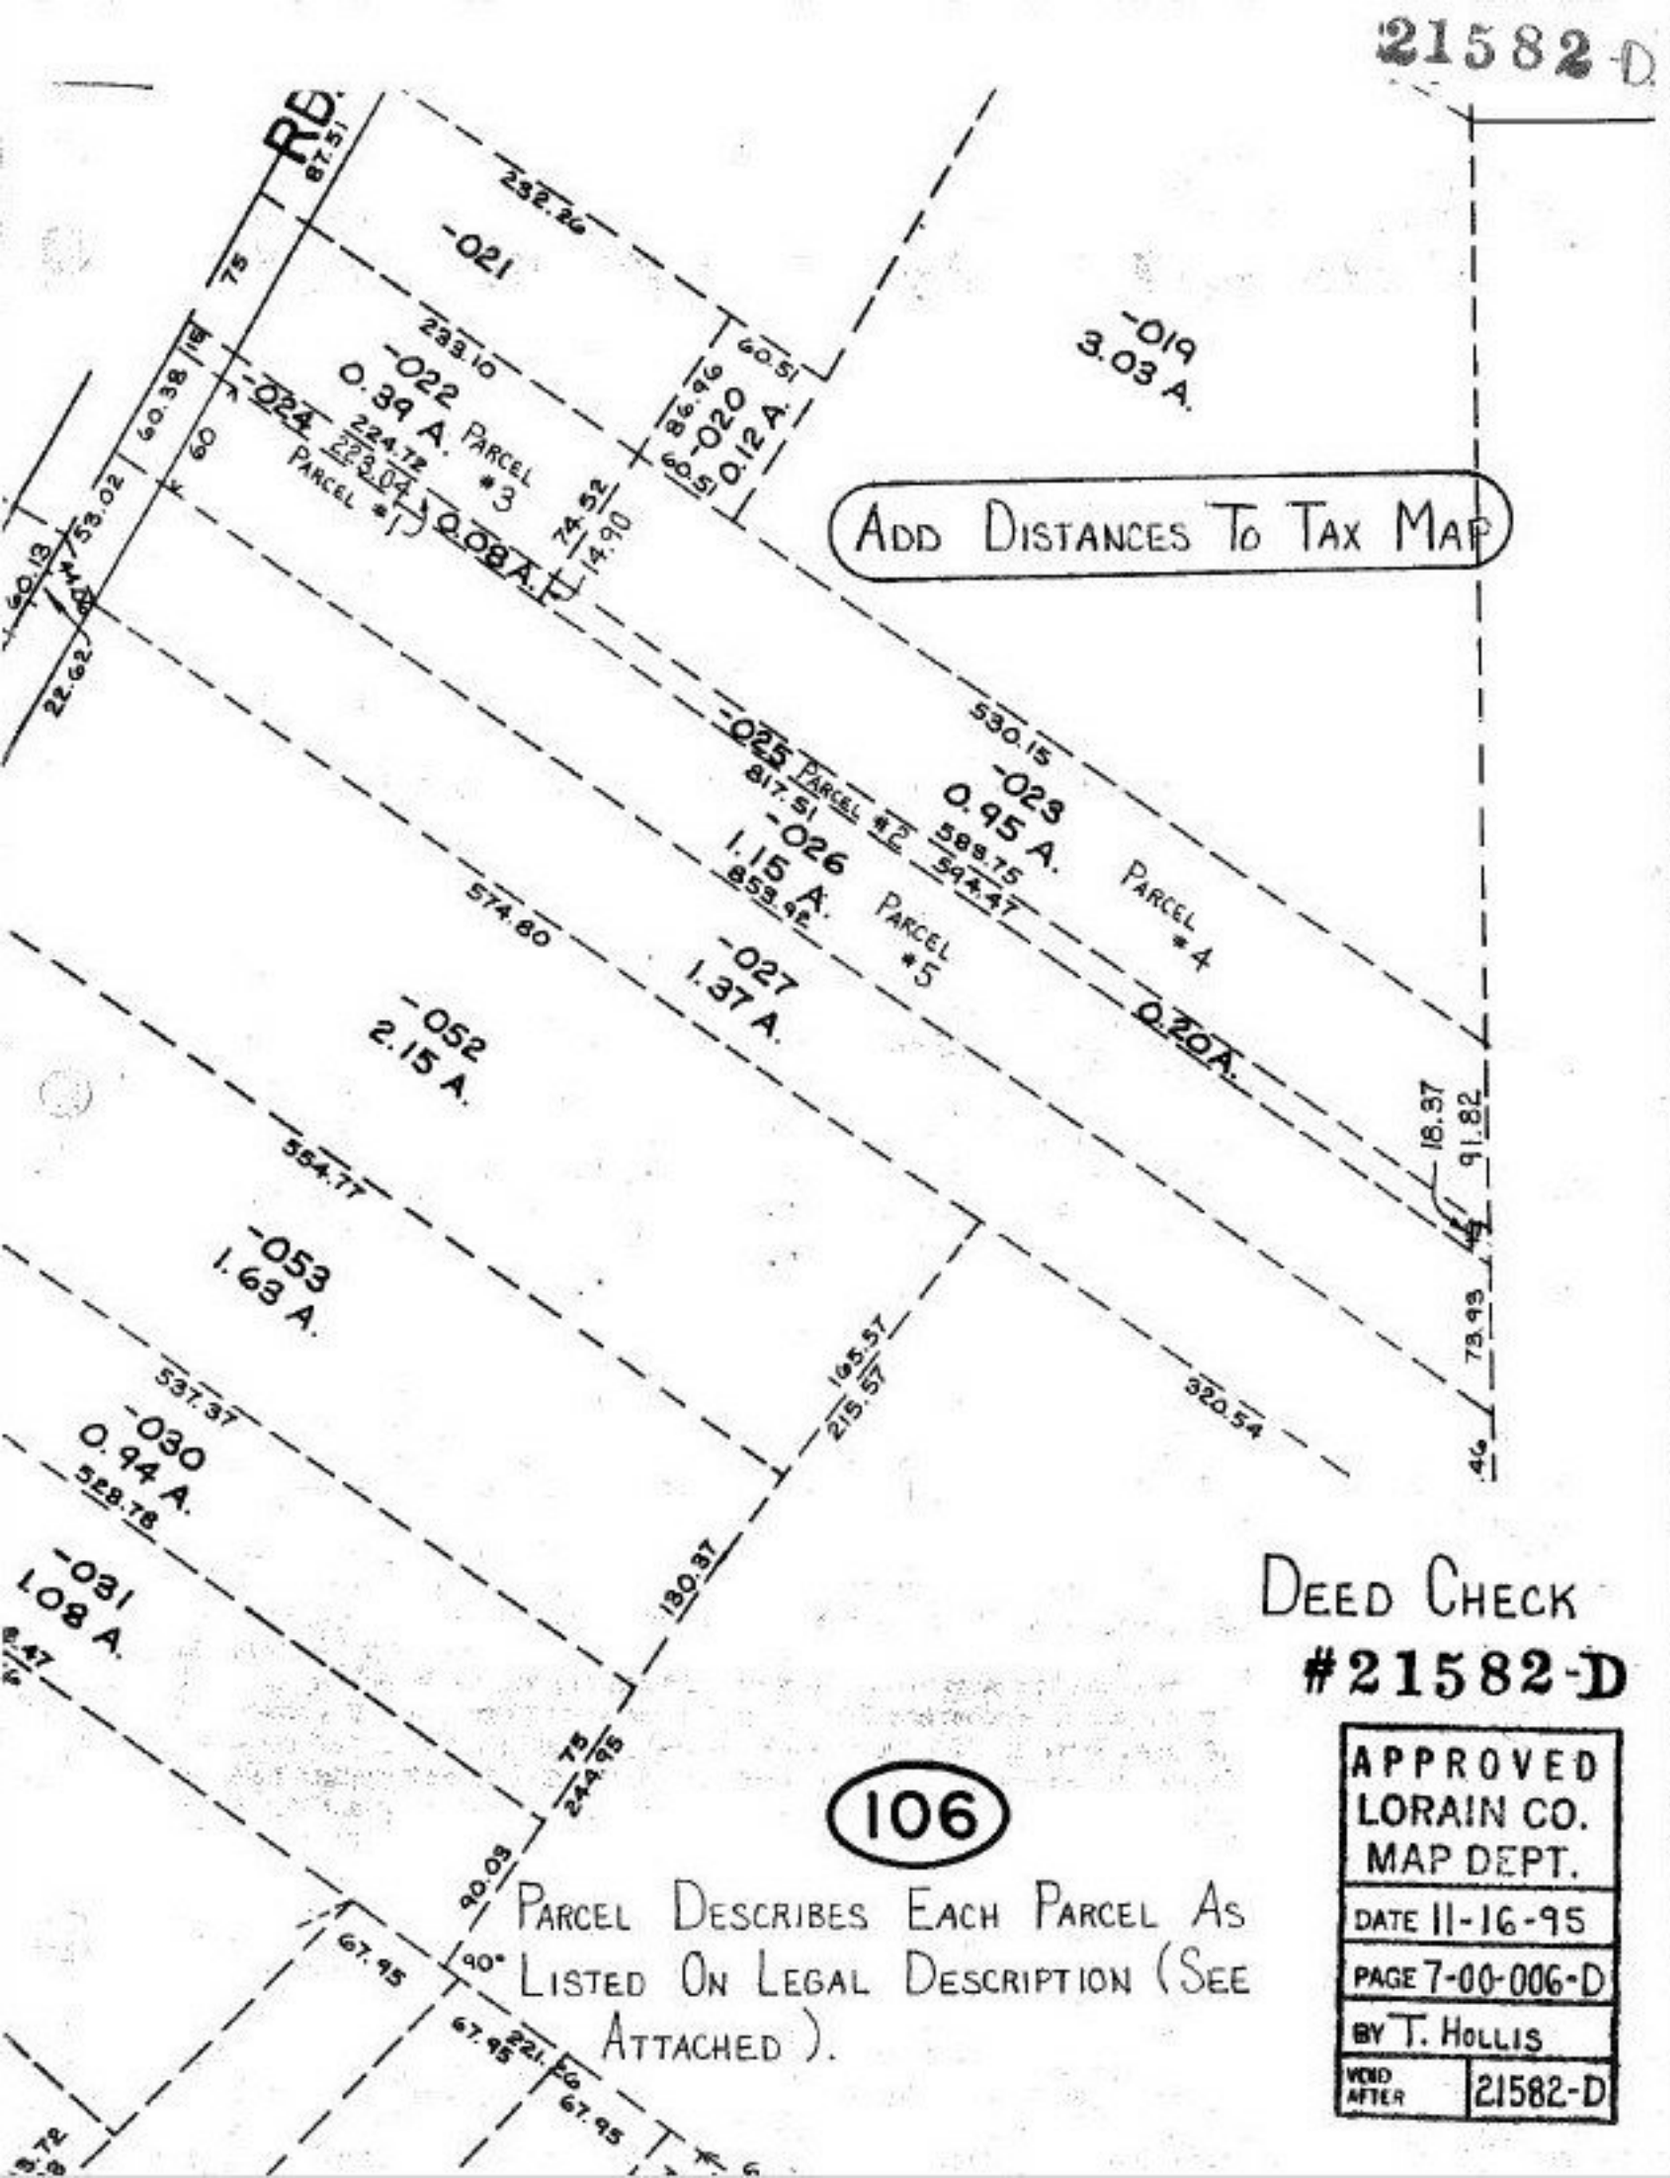

DEED CHECK
#21582-D

APPROVED LORAIN CO. MAP DEPT.	
DATE 11-16-95	
PAGE 7-00-006-D	
BY T. HOLLIS	
VOID AFTER	21582-D

106

PARCEL DESCRIBES EACH PARCEL AS LISTED ON LEGAL DESCRIPTION (SEE ATTACHED).