21583

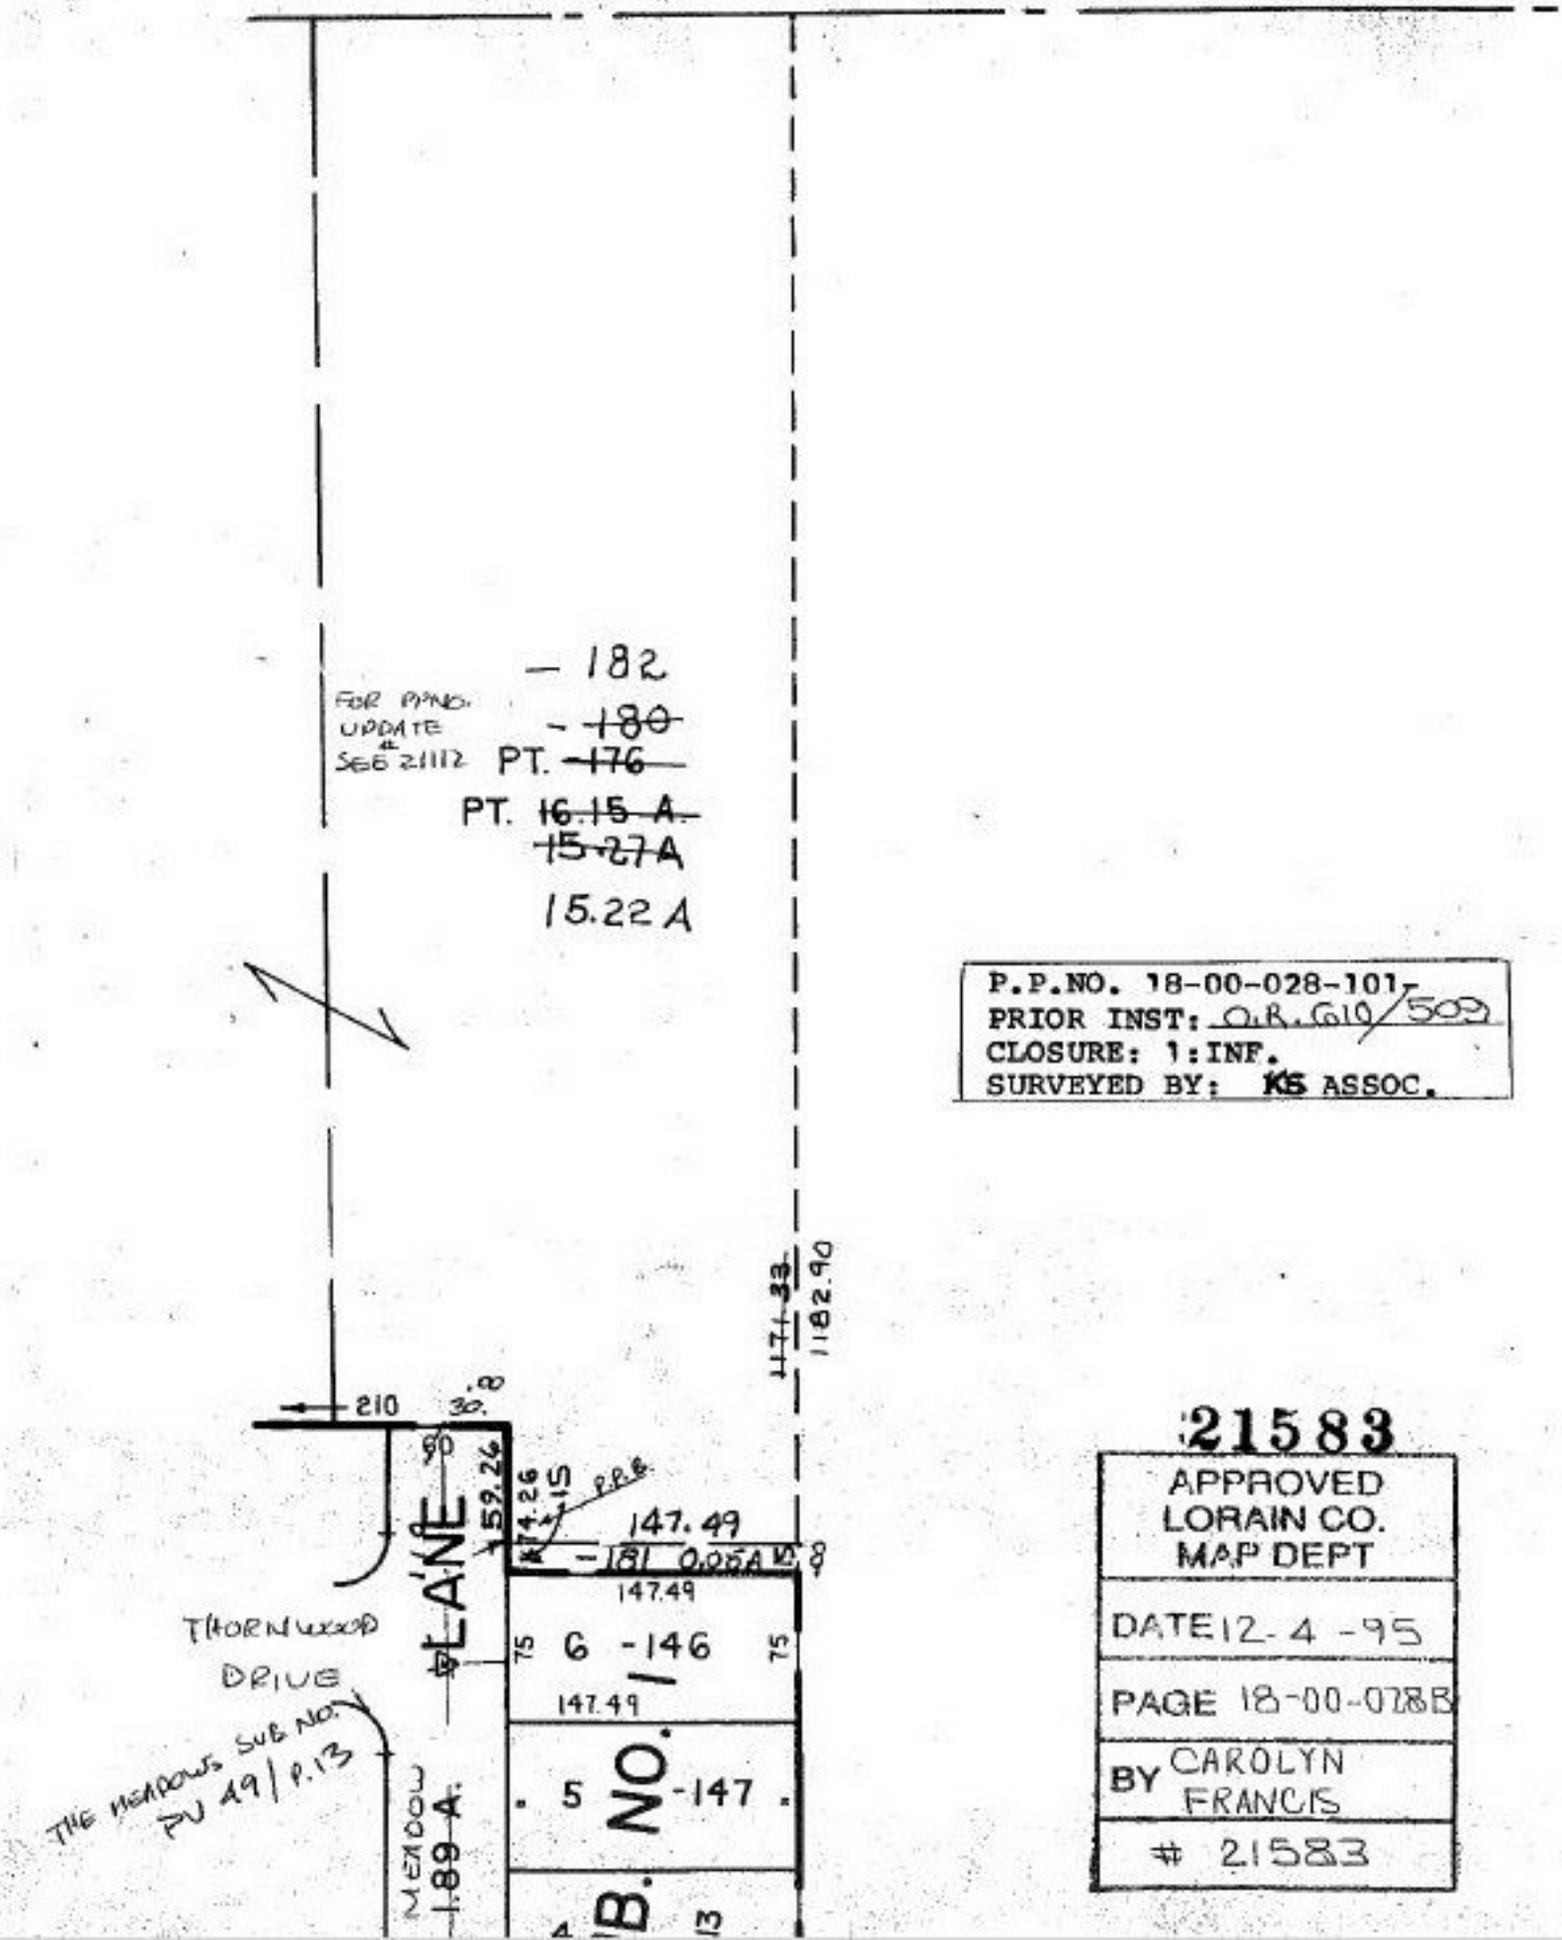

P.P.NO. 18-00-028-101-
PRIOR INST: O.R. 610/509
CLOSURE: 1:INF.
SURVEYED BY: KS ASSOC.

21583

APPROVED LORAIN CO. MAP DEPT
DATE 12-4-95
PAGE 18-00-028B
BY CAROLYN FRANCIS
21583