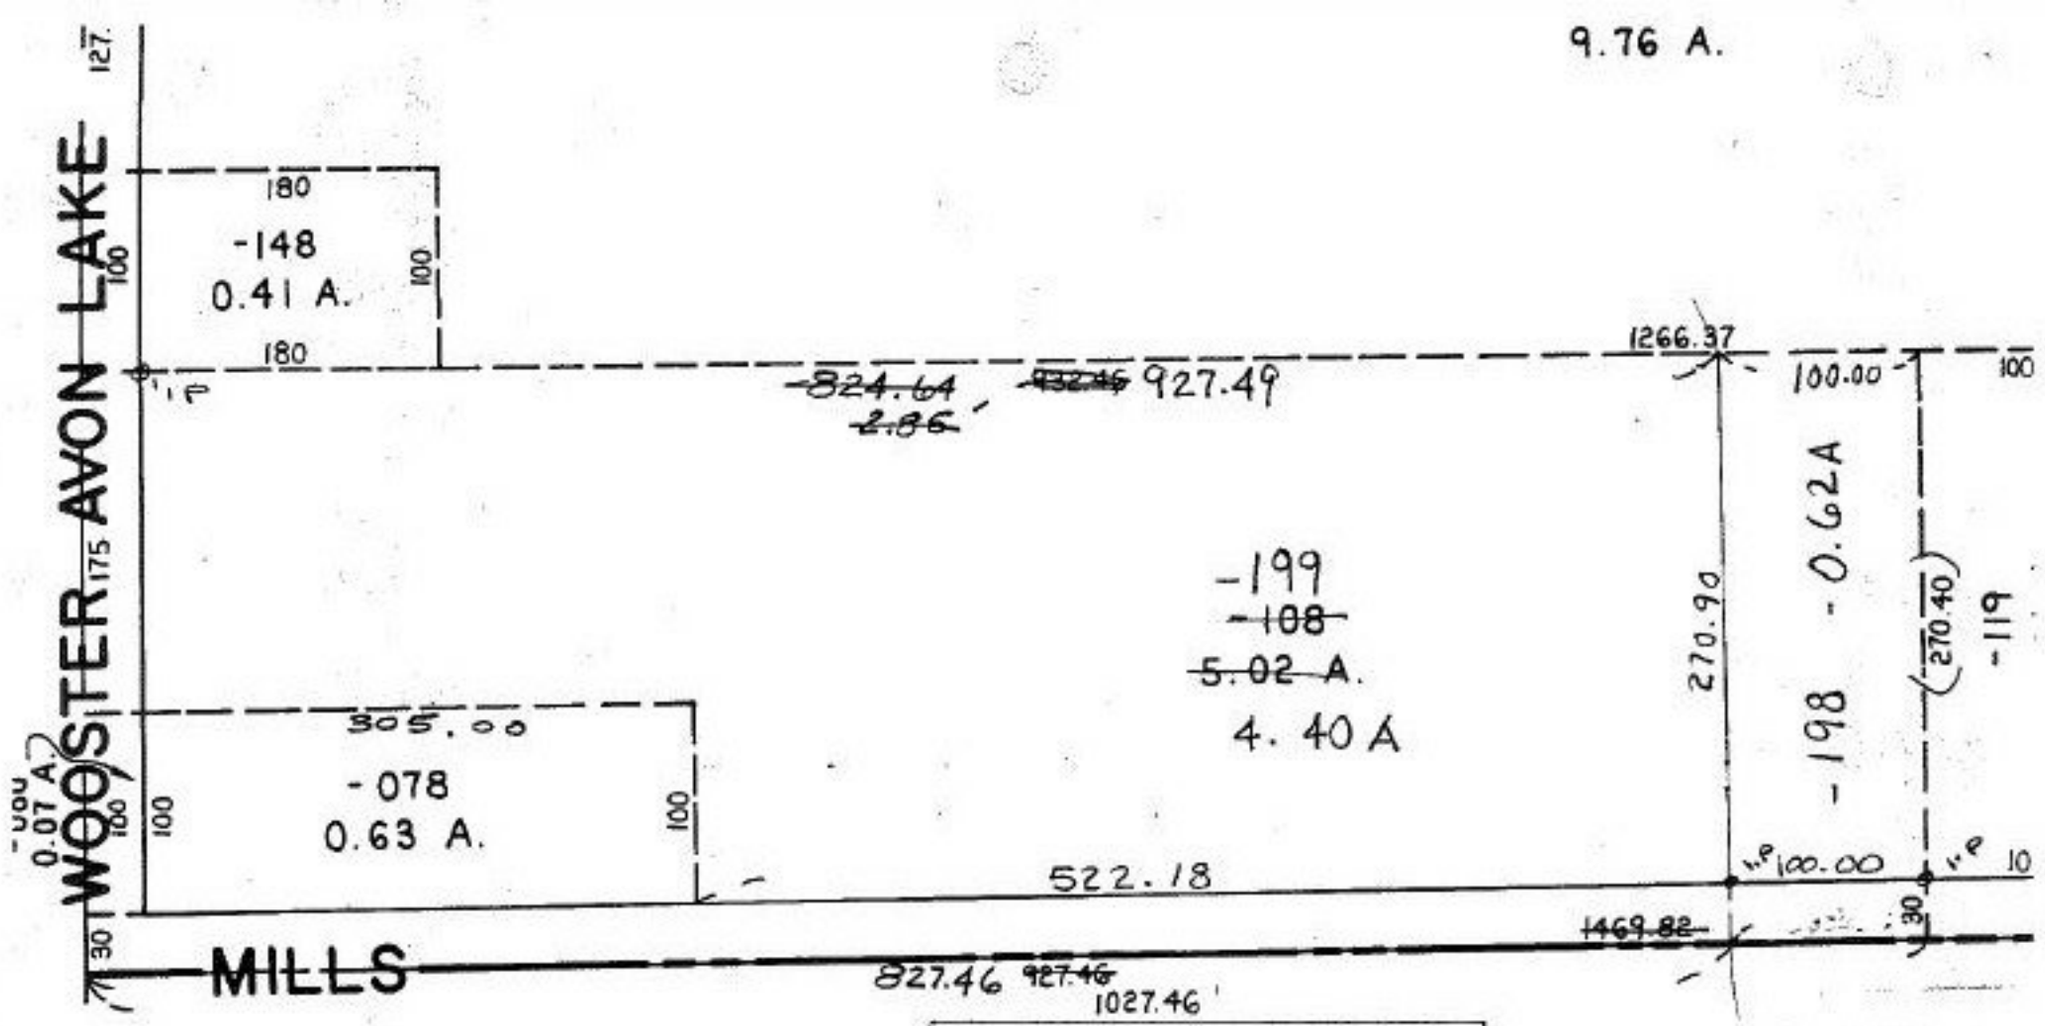

21586

APPROVED
LORAIN CO.
MAP DEPT

DATE 12-4-95

PAGE 4-00-013-G

BY CAROLYN FRANCIS

21586

21586