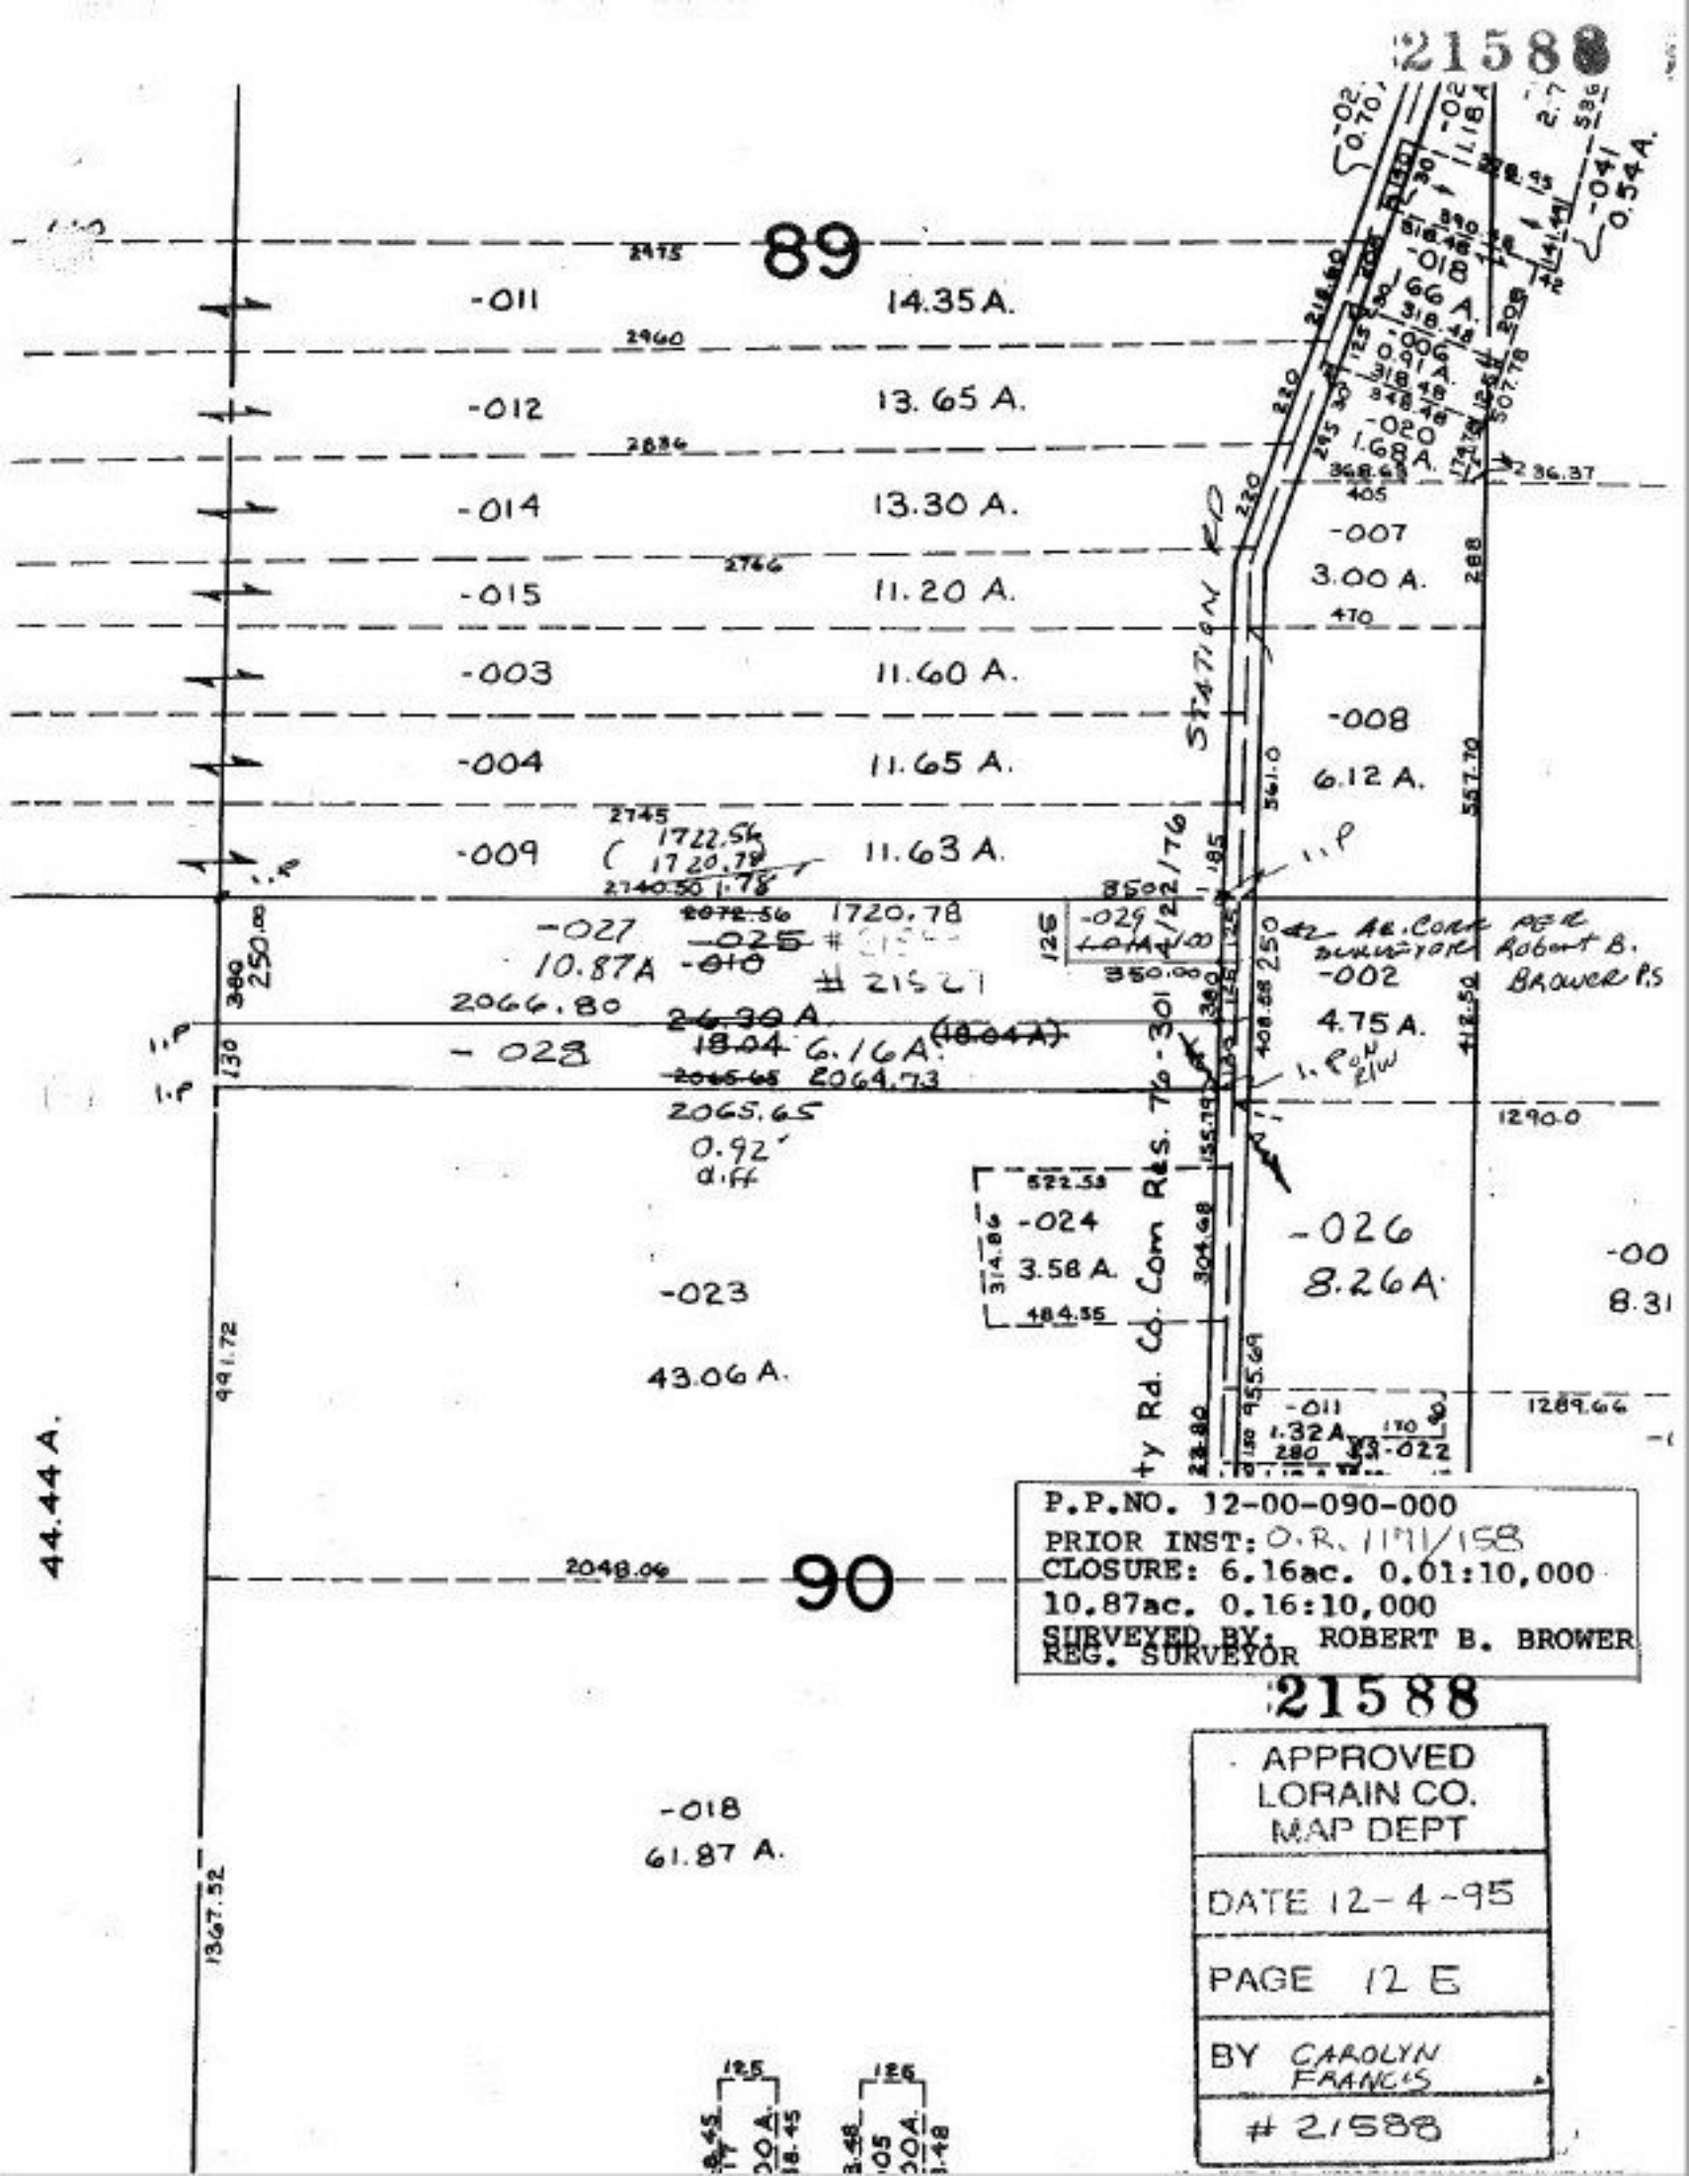
21588
89
-011
14.35 A.
-012
13.65 A.
-014
13.30 A.
-015
11.20 A.
-003
11.60 A.
-004
11.65 A.
-009
11.63 A.
-027
10.87A
-025
-010
-028
-029
-024
3.58 A.
-026
8.26A
-023
43.06 A.
-018
61.87 A.
-007
3.00 A.
-008
6.12 A.
-002
4.75 A.
-011
1.32A
-022
-020
1.60 A.
-021
1.66 A.
-041
0.54A.
44.44 A.
90
STATION RD
P.P.NO. 12-00-090-000
PRIOR INST: O.R. 1191/158
CLOSURE: 6.16ac. 0.01:10,000
10.87ac. 0.16:10,000
SURVEYED BY: ROBERT B. BROWER
REG. SURVEYOR
21588
APPROVED
LORAIN CO.
MAP DEPT
DATE 12-4-95
PAGE 12 E
BY CAROLYN FRANCIS
# 21588