21588

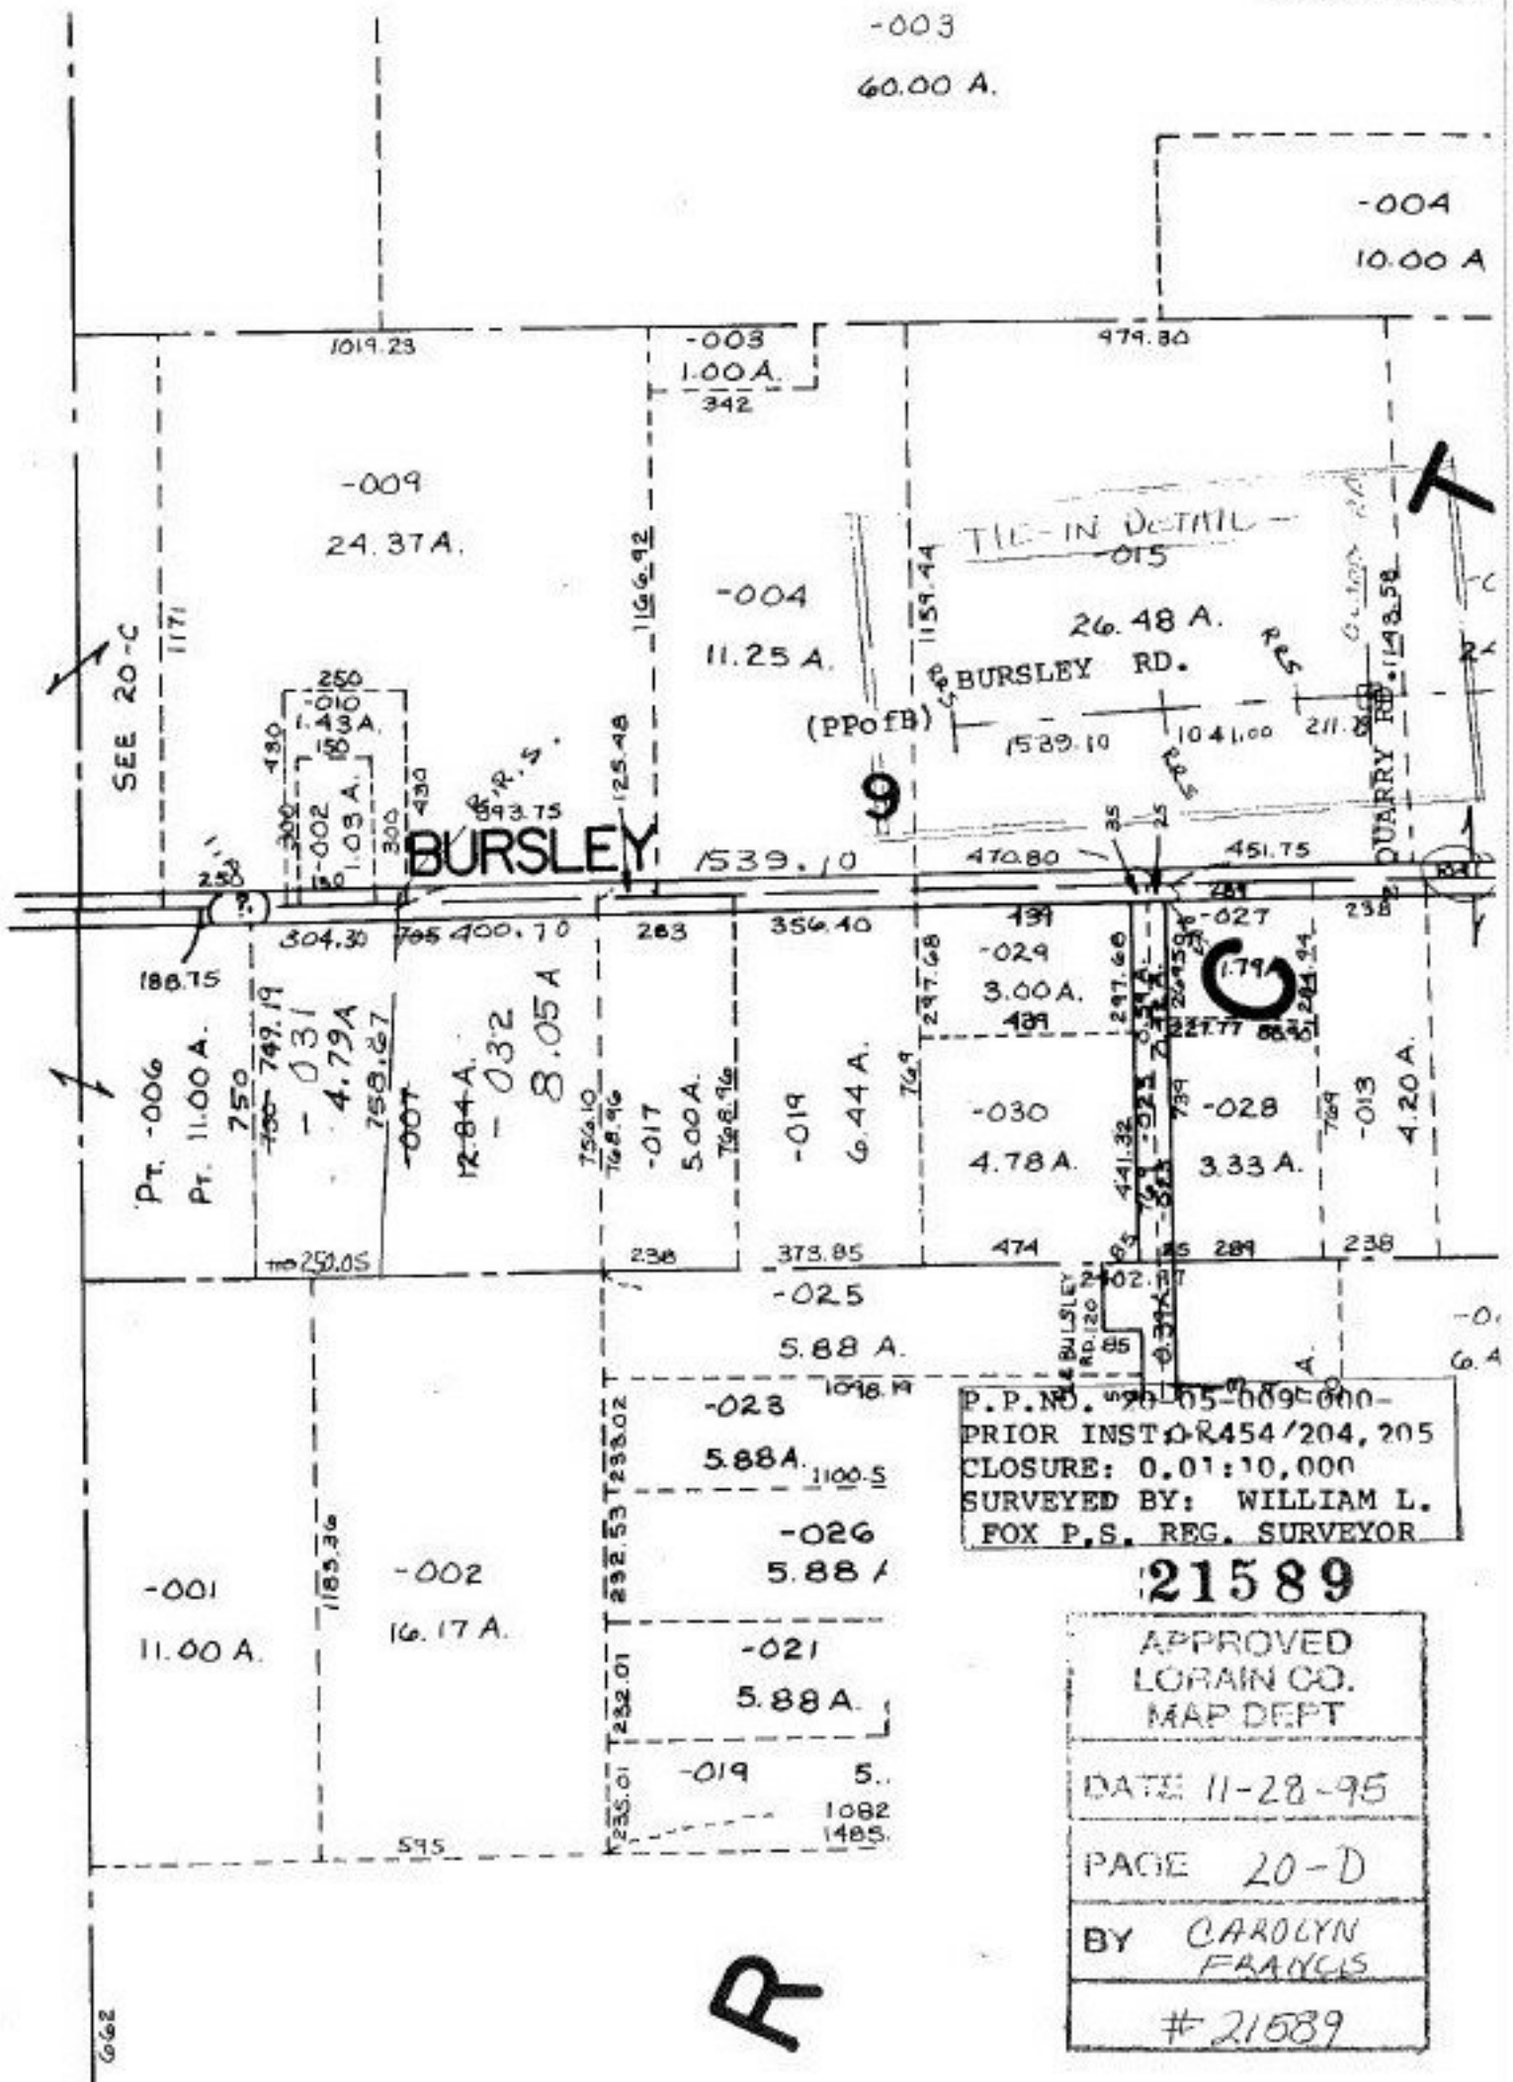
-003
60.00 A.
-004
10.00 A
1019.23
-003
1.00A.
342
979.80
-009
24.37A.
-004
11.25 A.
TIE-IN DETAIL
-015
26.48 A.
BURSLEY RD.
(PPofB)
1539.10
1041.00
211.58
QUARRY RD.
SEE 20-C
1171
1166.92
1159.44
1143.58
-002
1.03 A.
BURSLEY
1539.10
470.80
451.75
-027
1.79A
-029
3.00A.
-030
4.78A.
-028
3.33 A.
-013
4.20A.
-031
4.79A
-032
8.05A
-017
5.00A.
-019
6.44 A.
-025
5.88 A.
-023
5.88A.
-026
5.88 A
-021
5.88A.
-001
11.00 A.
-002
16.17 A.
Pt. -006
Pt. 11.00 A.
1018.14
1100.5
1185.36
595
1082
1485
P.P.NO. 20-05-009-000-
PRIOR INST OR 454/204, 205
CLOSURE: 0.01:10,000
SURVEYED BY: WILLIAM L.
FOX P.S. REG. SURVEYOR
21589
APPROVED
LORAIN CO.
MAP DEPT
DATE 11-28-95
PAGE 20-D
BY CAROLYN
FRANCIS
#21589