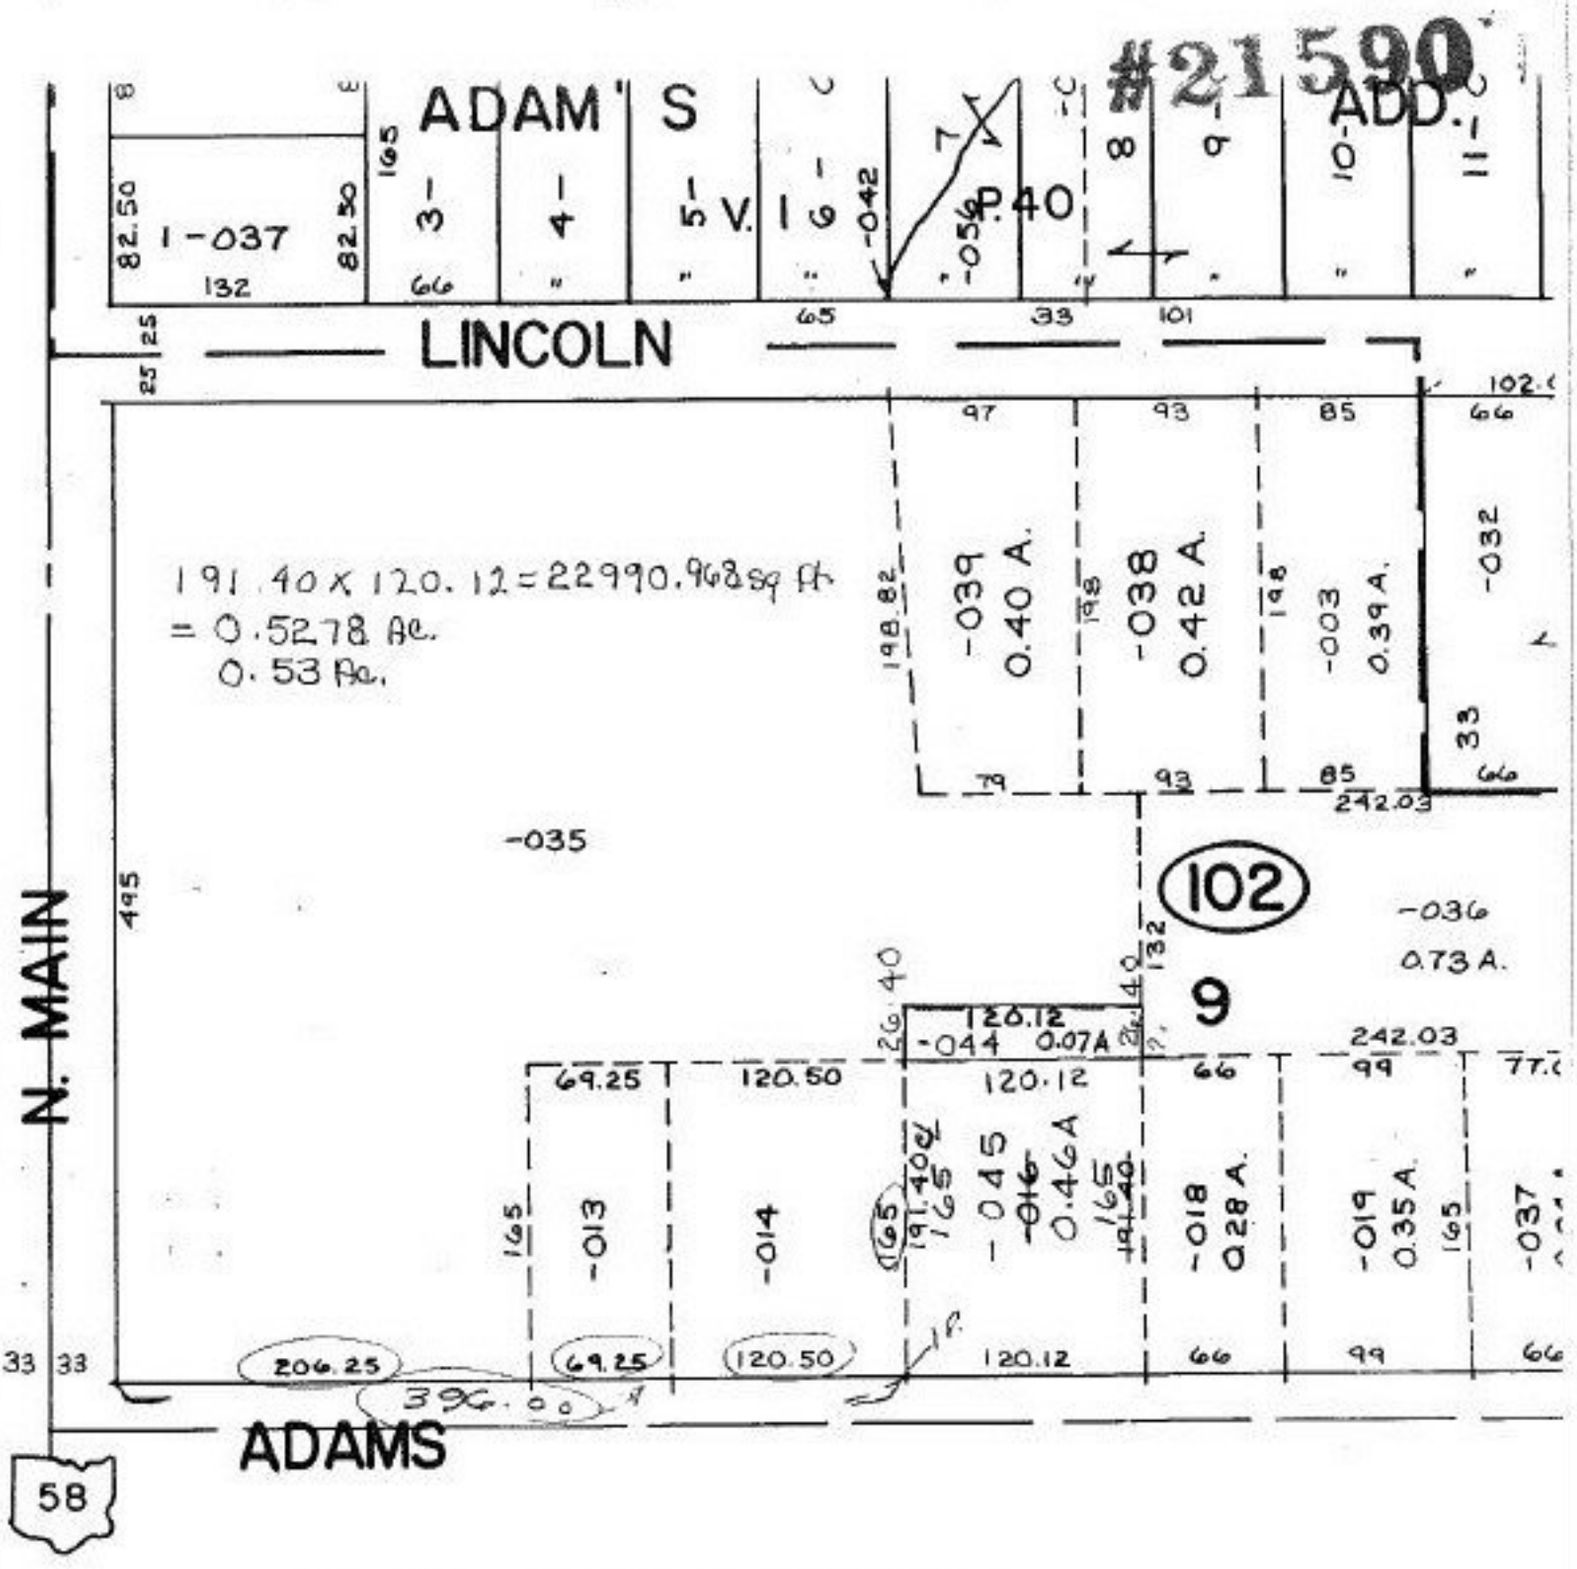

P.P.NO. 18-00-021-102-
PRIOR INST. O.R. 1096/200
CLOSURE: 1:INF.
SURVYED BY: WILLIAM L. FOX
REG. SURVEYOR

21590

APPROVED
LORAIN CO.
MAP DEPT

DATE 12-5-95

PAGE 18-00-021A

BY CAROLYN FRANCIS

21590

WELLINGTON

SCALE: 1" = 100'