21591-X

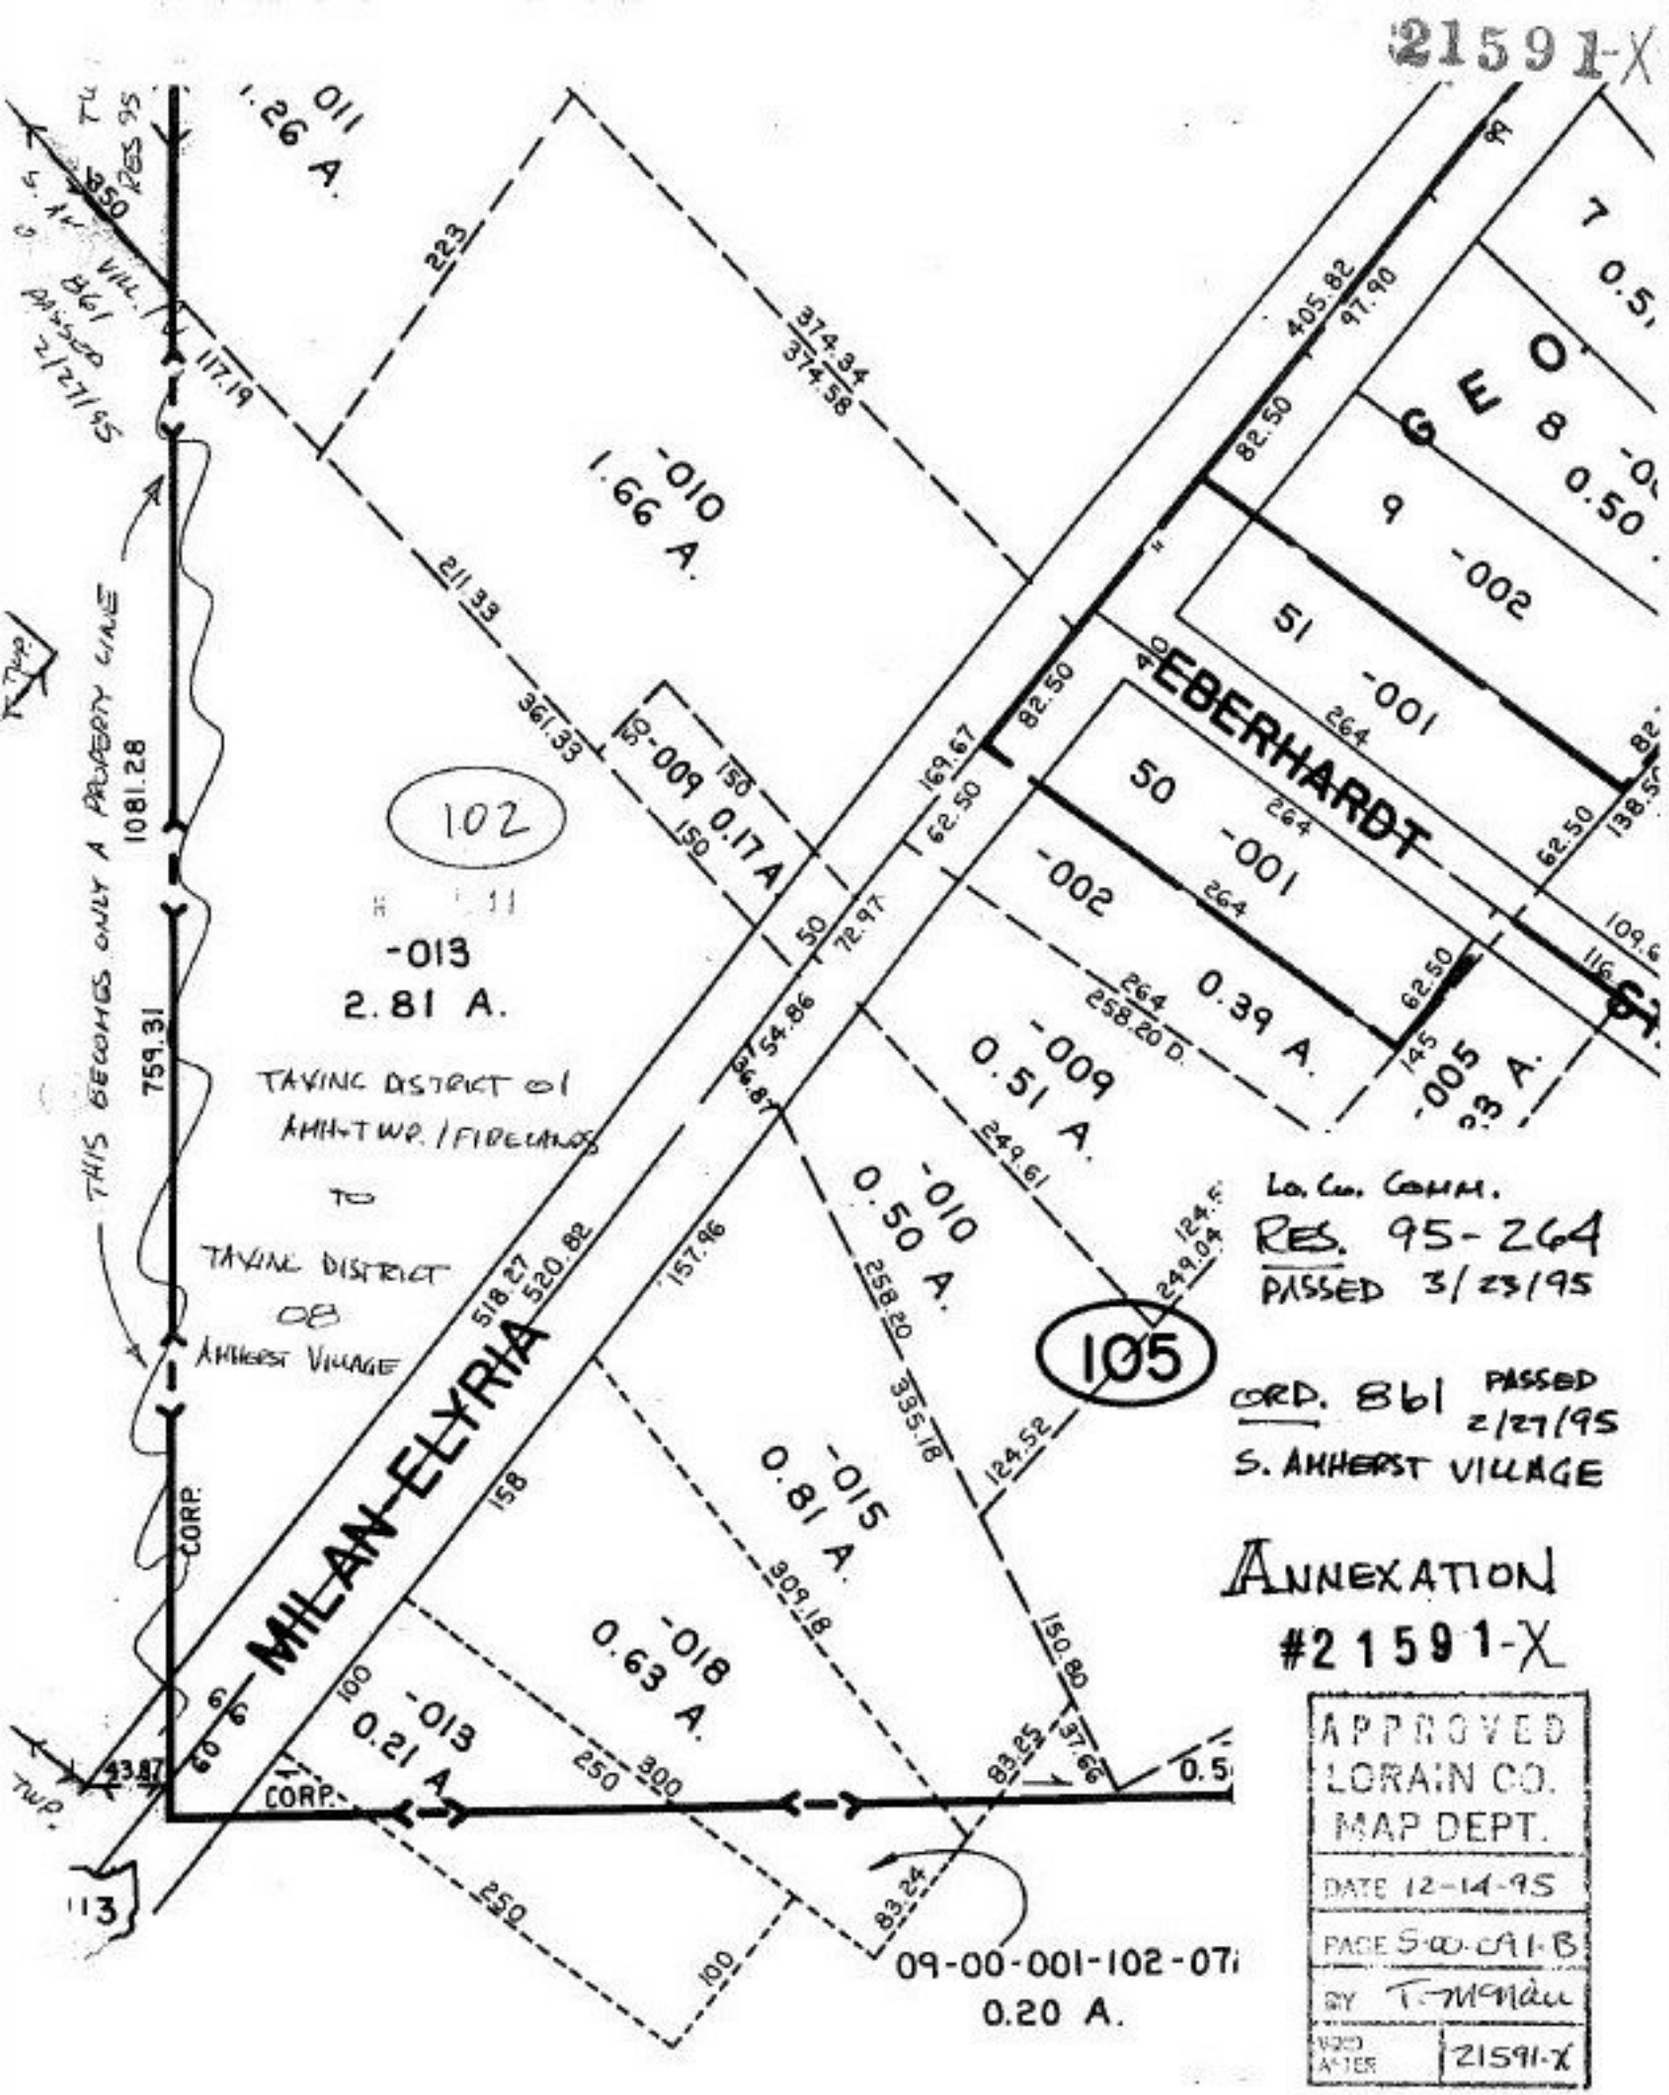
011
1.26 A.
223
374.34
374.58
-010
1.66 A.
211.33
361.33
-009 0.17 A
150
150
169.67
62.50
50
72.97
102
-013
2.81 A.
TAXING DISTRICT OF
AMH-TWP./FIRELANDS
TO
TAXING DISTRICT
OF
AMHERST VILLAGE
THIS BECOMES ONLY A PROPERTY LINE
1081.28
759.31
CORP.
MILAN-ELYRIA
518.27
520.82
54.86
86.87
-009
0.51 A.
249.61
-010
0.50 A.
258.20
157.96
105
124.52
-015
0.81 A.
309.18
158
-018
0.63 A.
-013
0.21 A
100
250
300
83.25
37.62
150.80
83.24
250
100
09-00-001-102-07
0.20 A.
405.82
97.90
82.50
EBERHARDT
9
-002
51
-001
264
50
-001
264
-002
264
258.20 D.
0.39 A.
62.50
145
-005
0.3 A.
7
0.5
8
0.50
109.6
116
LA. CO. COMM.
RES. 95-264
PASSED 3/23/95
ORD. 861 PASSED 2/27/95
S. AMHERST VILLAGE
ANNEXATION
#21591-X
APPROVED
LORAIN CO.
MAP DEPT.
DATE 12-14-95
PAGE S-00-091-B
BY T. McMahon
NEW AREA 21591-X