21591

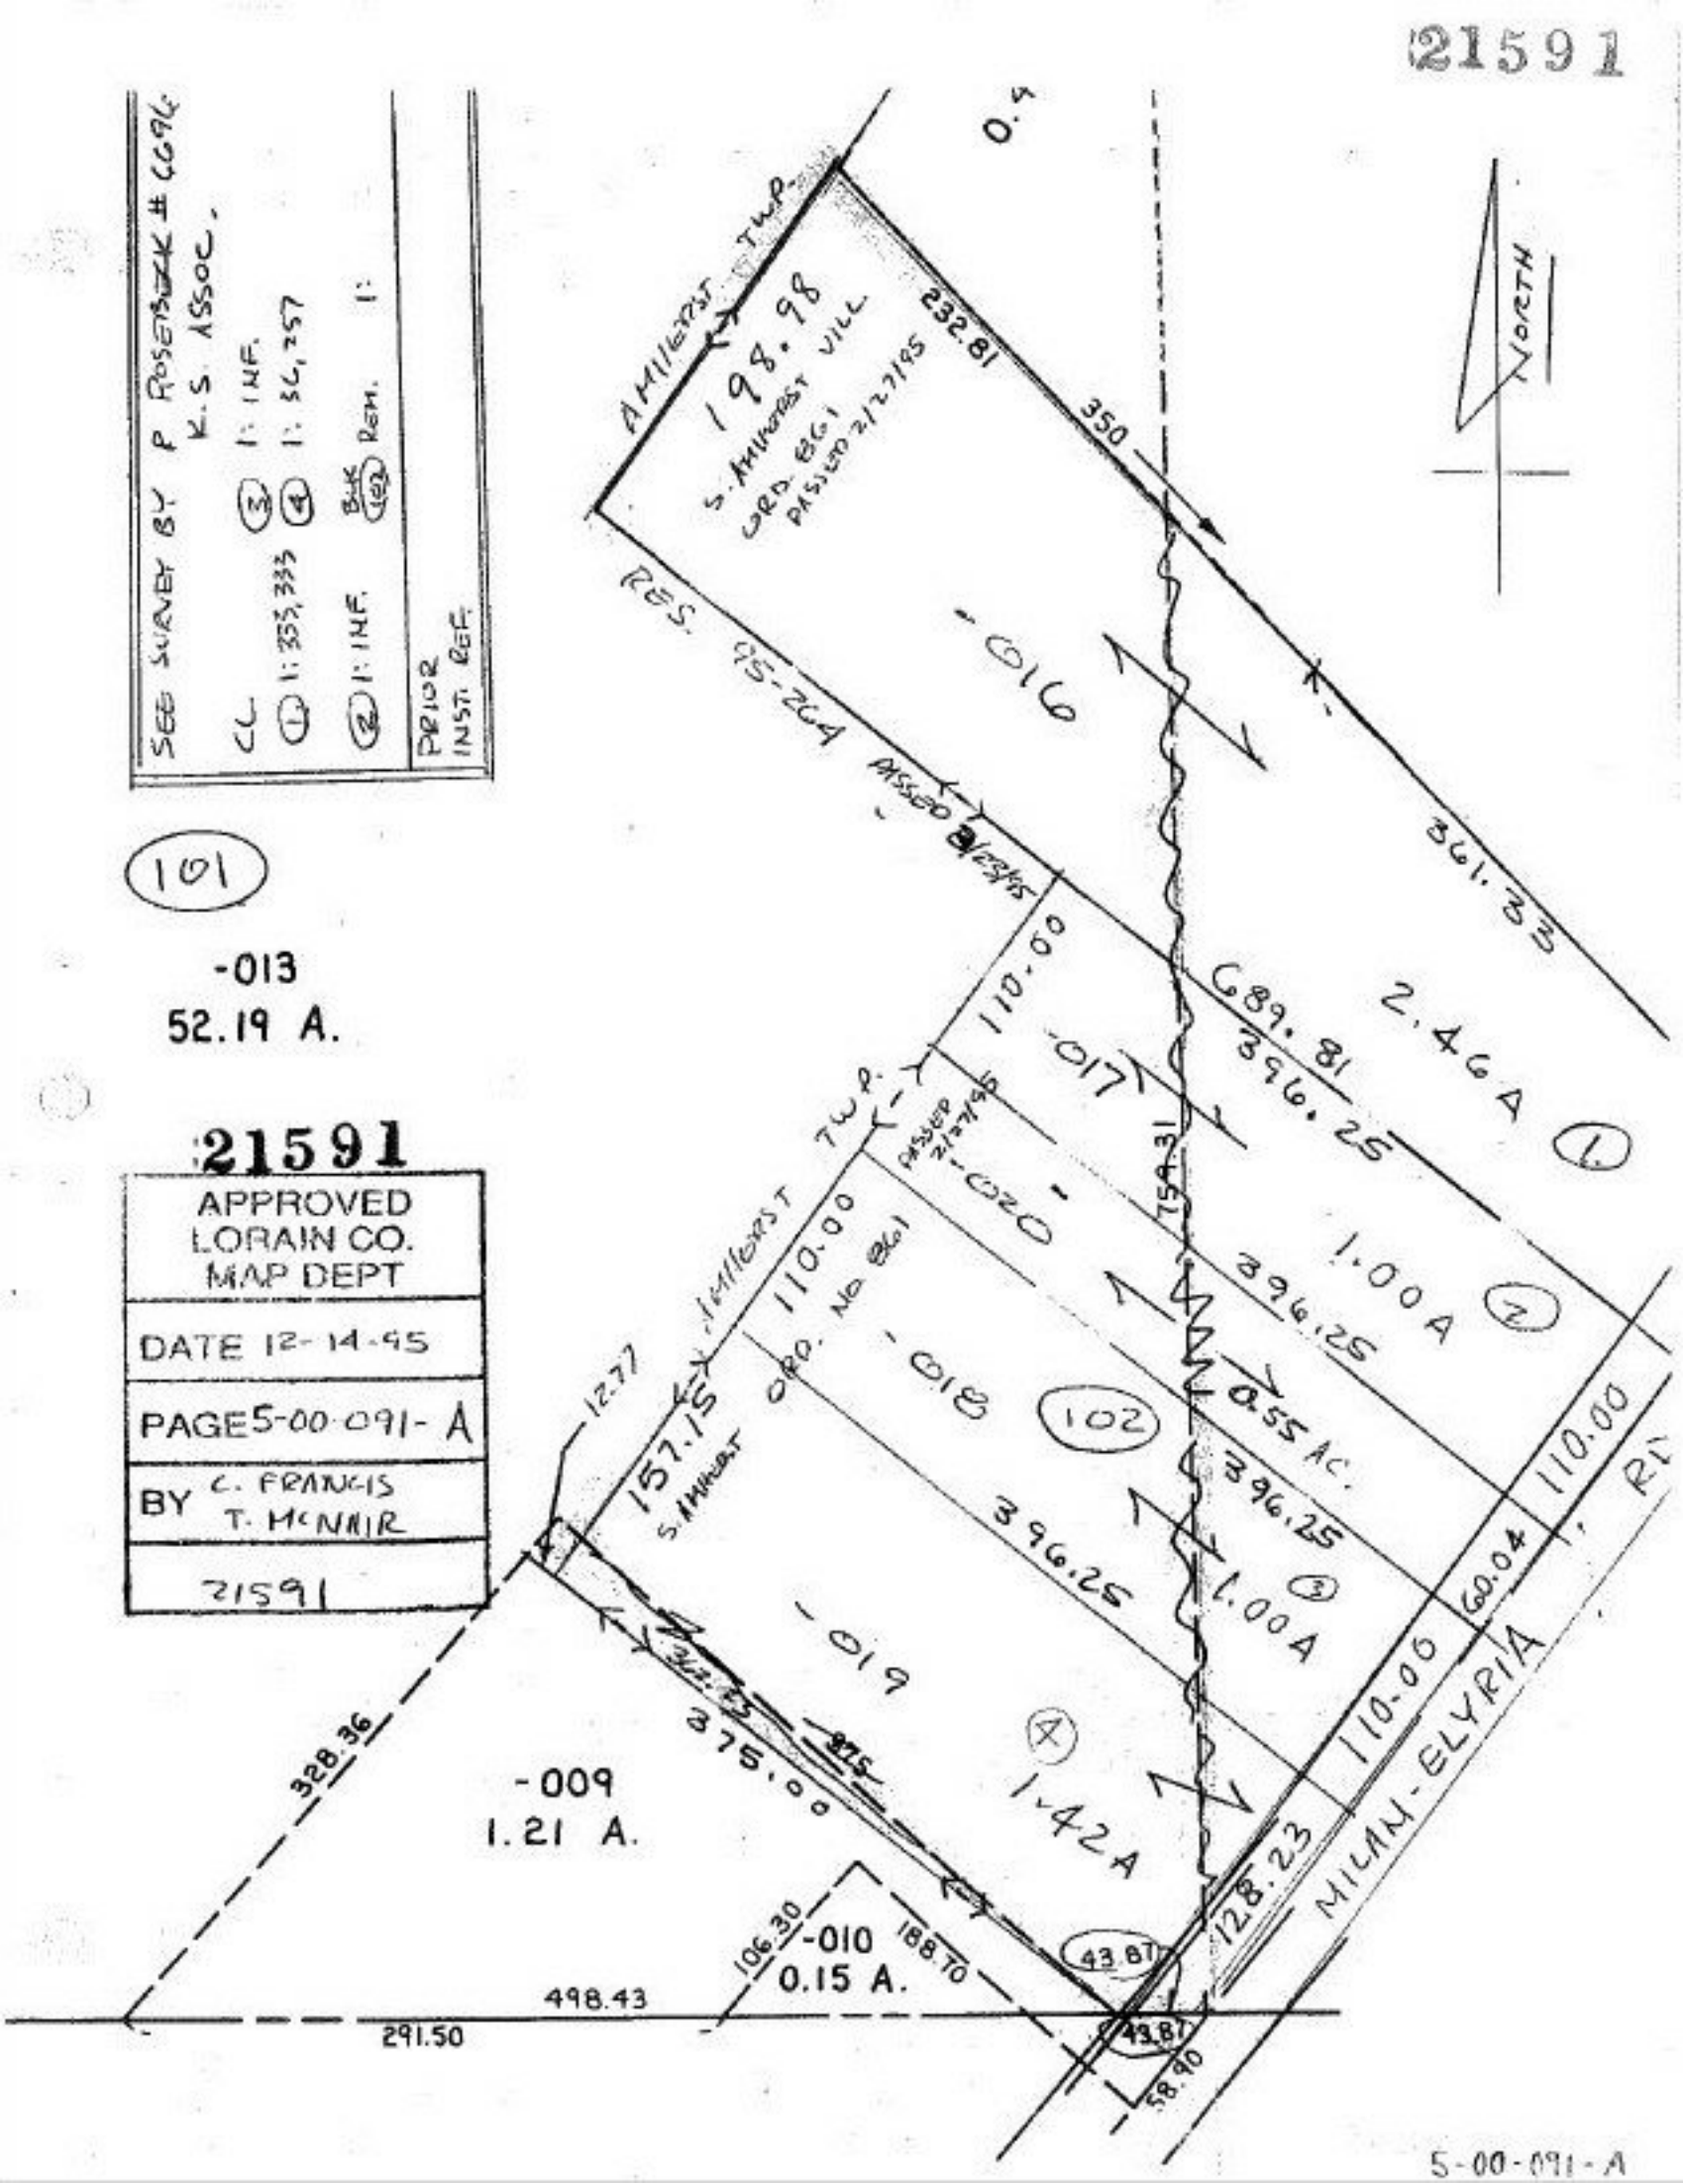

SEE SURVEY BY P ROSEBROCK # 6096 K.S. ASSOC.	
CL	
(1) 1: 333,333	(3) 1: INF.
(2) 1: INF.	(4) 1: 36,257
	Bnk (162) Rem. 1:
PRIOR INST. REF.	

(101)

-013
52.19 A.

21591

APPROVED LORAIN CO. MAP DEPT
DATE 12-14-95
PAGE 5-00-091-A
BY C. FRANCIS T. McNAIR
21591

5-00-091-A