21593

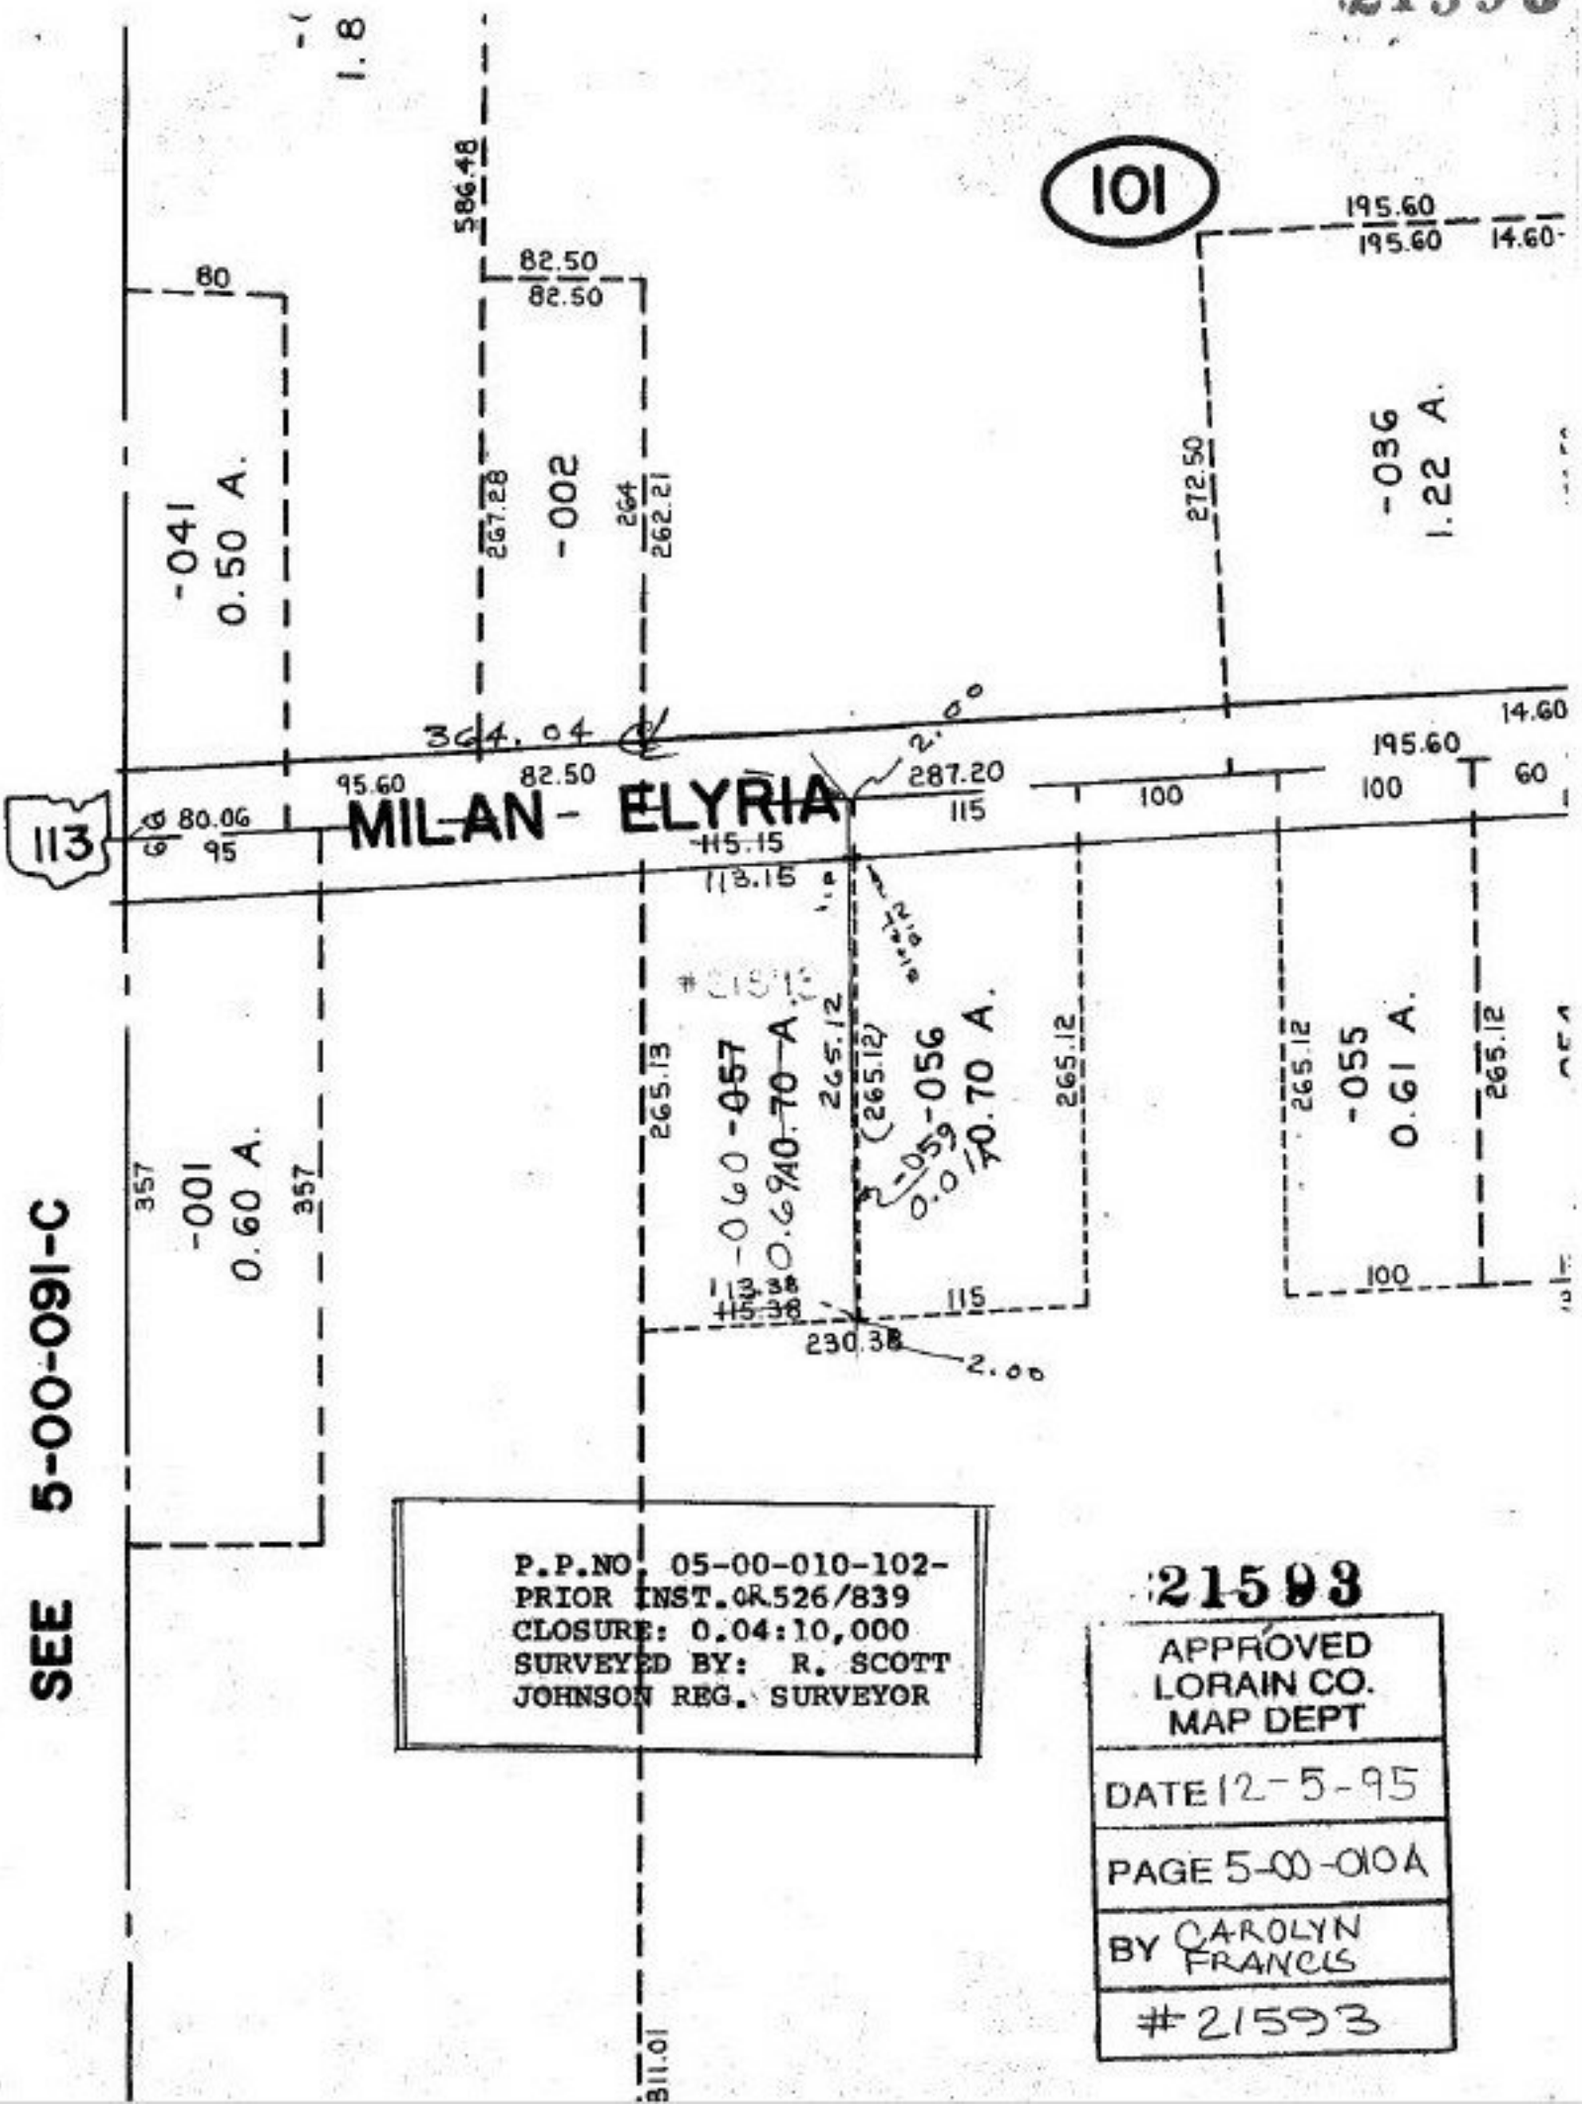

P.P.NO. 05-00-010-102-
PRIOR INST.OR526/839
CLOSURE: 0.04:10,000
SURVEYED BY: R. SCOTT
JOHNSON REG. SURVEYOR

21593

APPROVED
LORAIN CO.
MAP DEPT

DATE 12-5-95

PAGE 5-00-010A

BY CAROLYN FRANCIS

#21593