SEE SURVEY BY EARL HUNTER PS 7537
11/15/95
-018 1 INF.
-019 1 INF.

PRIOR INSTR. REF. —
OR 319/97 & 023-5/31

#21598
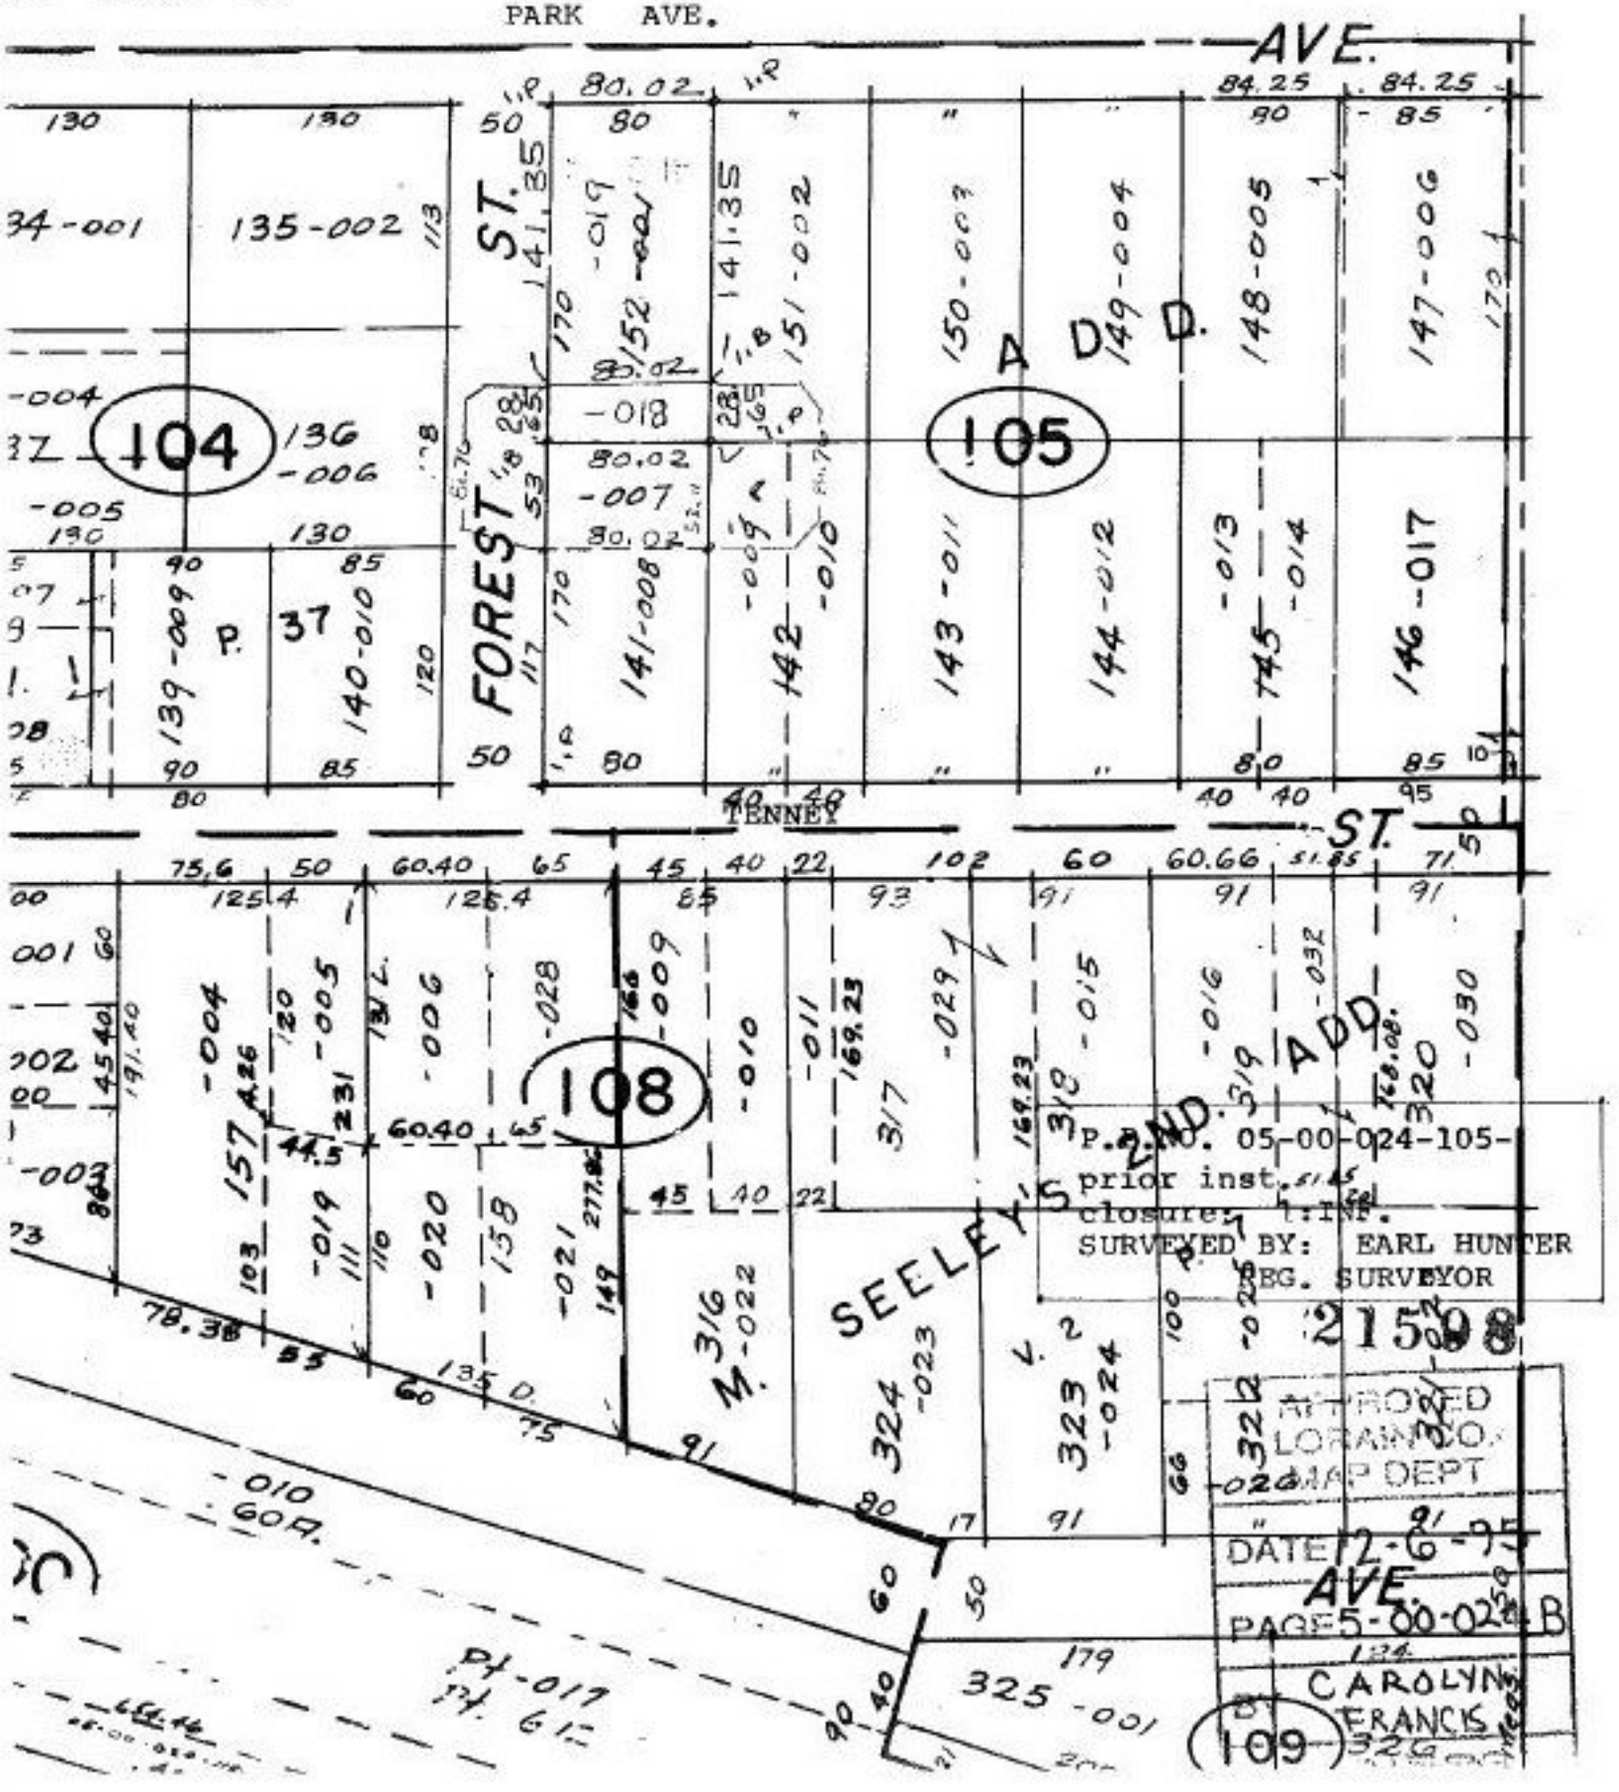
00-023-B