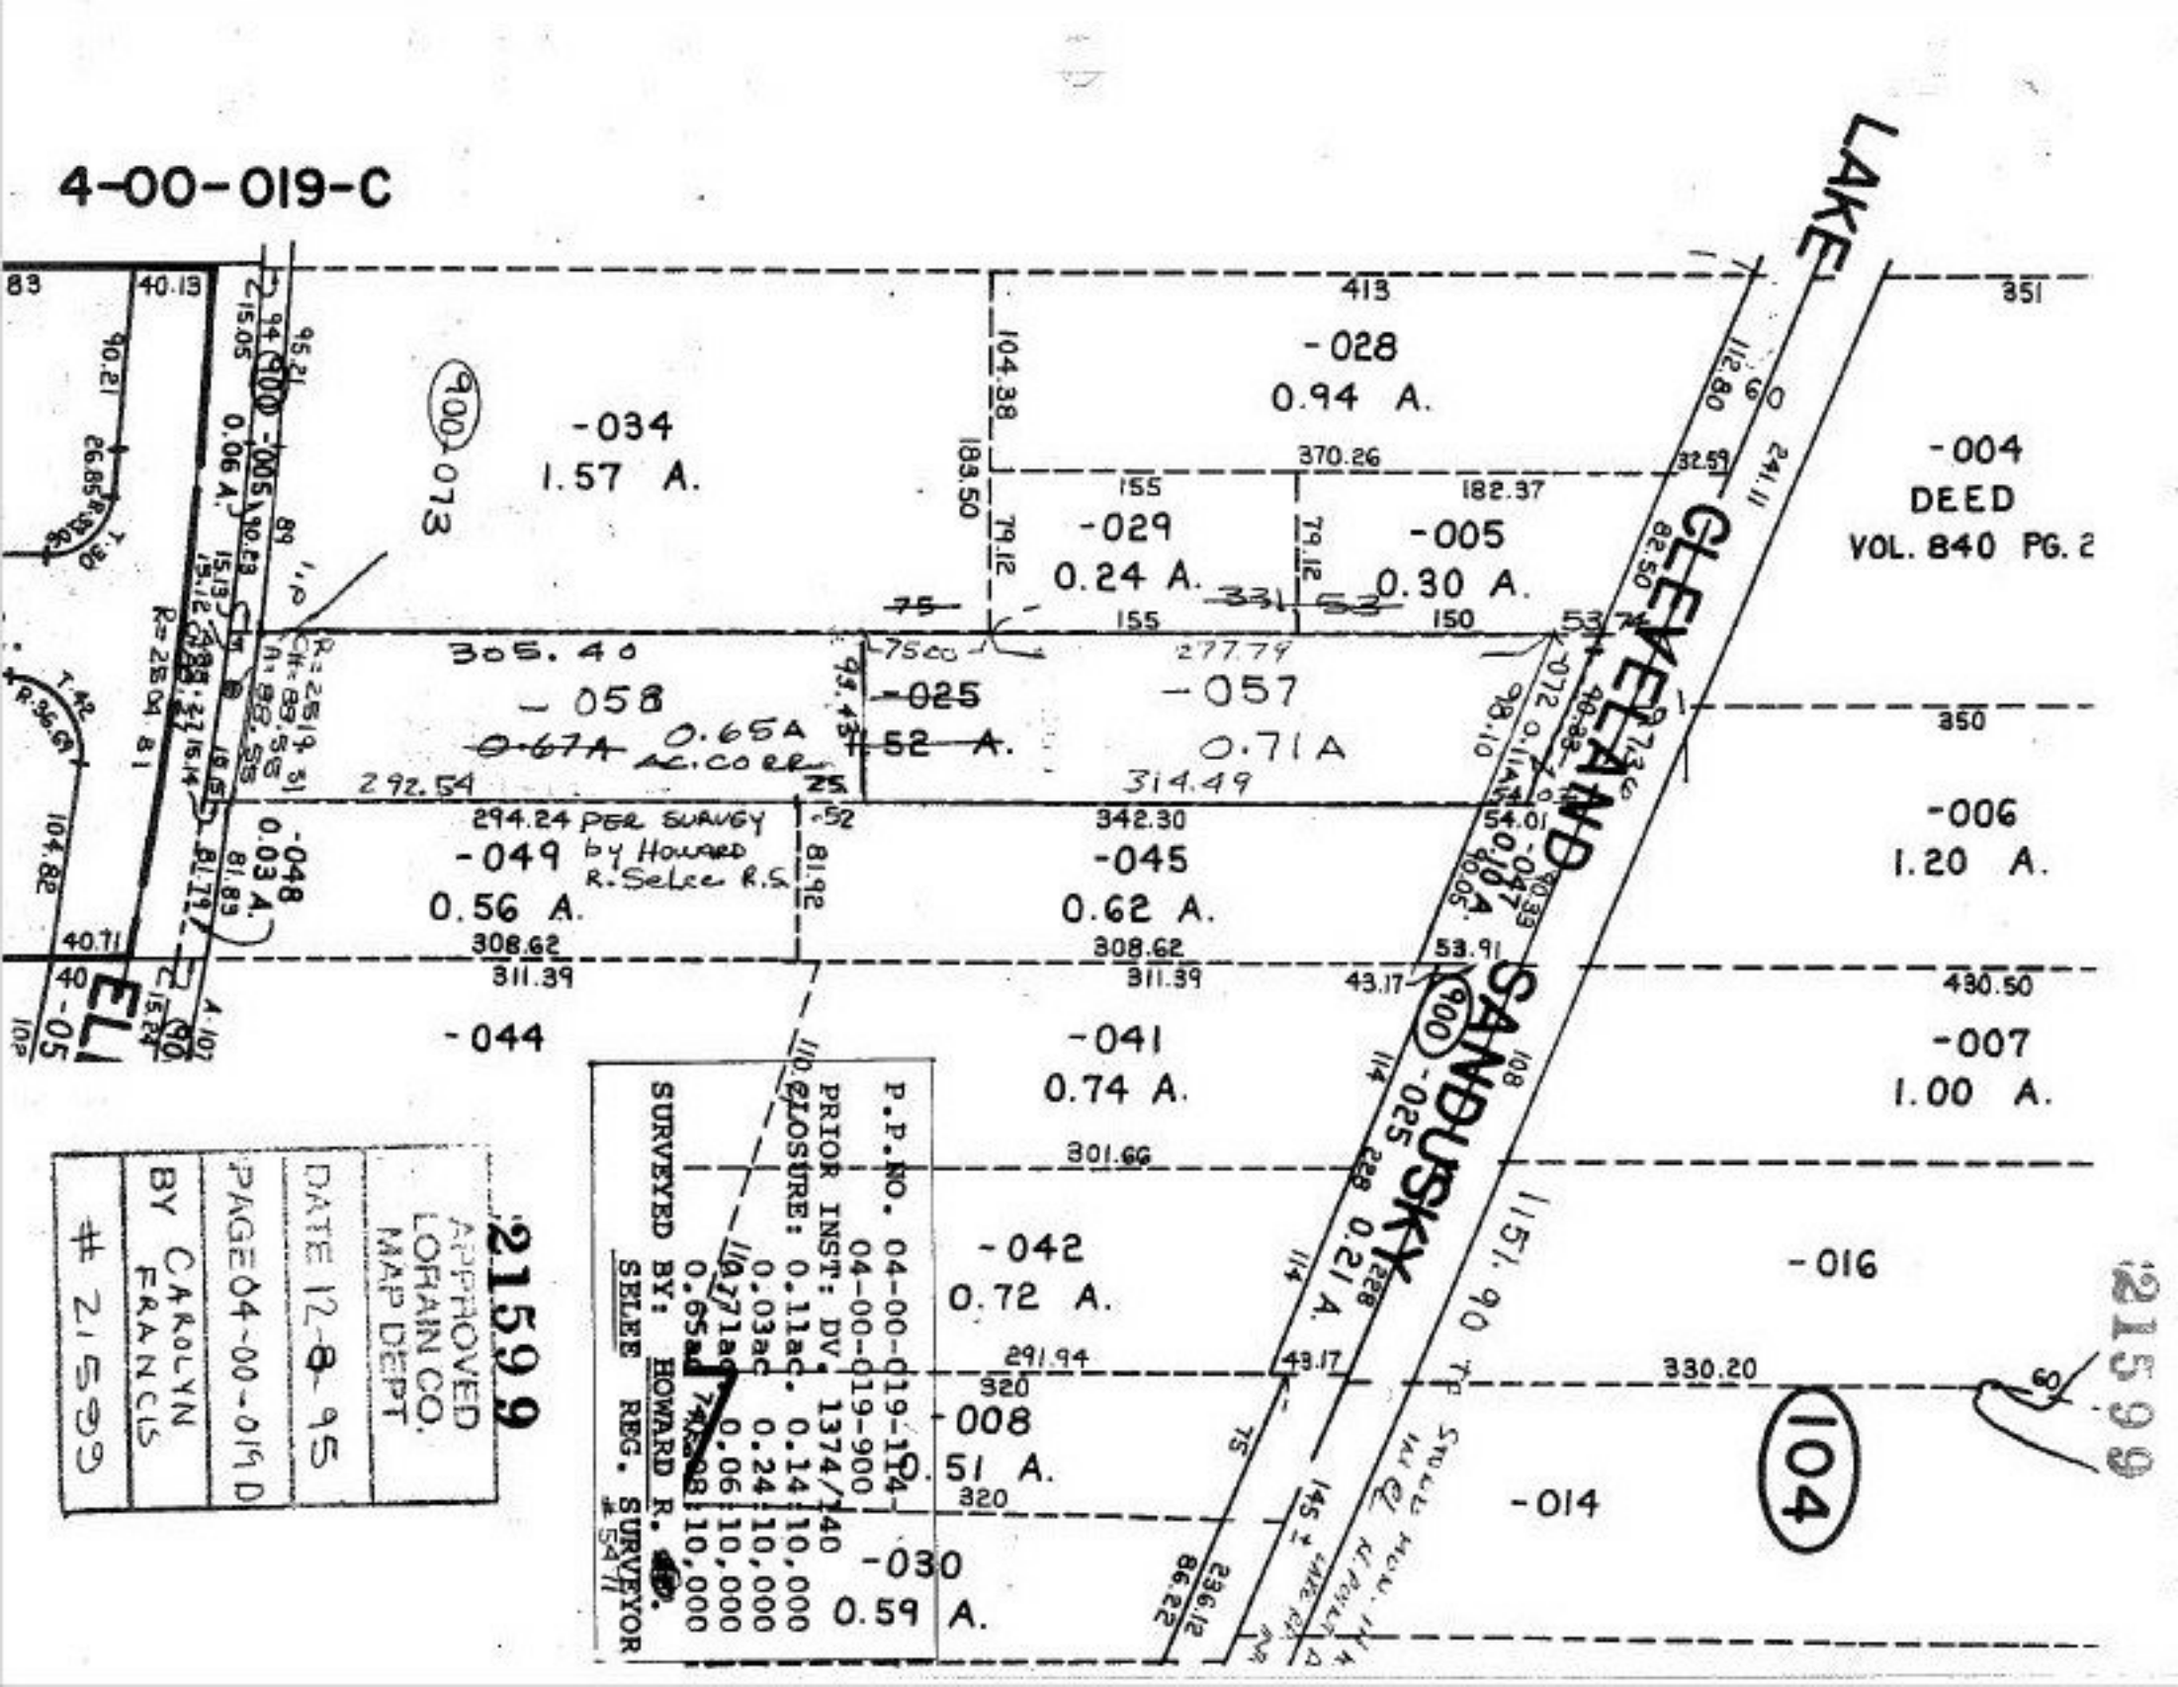
4-00-019-C
LAKE
ERIE
CLEVELAND
SANDUSKY
900
073
-034
1.57 A.
-028
0.94 A.
-029
0.24 A.
-005
0.30 A.
-004
DEED
VOL. 840 PG. 2
-058
0.65A
-025
.52 A.
-057
0.71A
-006
1.20 A.
-049
0.56 A.
-045
0.62 A.
-048
0.03 A.
-044
-041
0.74 A.
-007
1.00 A.
-042
0.72 A.
-016
-008
.51 A.
-014
-030
0.59 A.
-025
0.21 A.
104
305.40
277.79
294.24 PER SURVEY by Howard R. Selee R.S.
342.30
314.49
308.62
311.39
1151.90 T.P.
P.P.NO. 04-00-019-104
PRIOR INST: DV. 1374/140
CLOSURE: 0.11ac. 0.14 10,000
0.03ac 0.24 10,000
0.06 10,000
0.65ac 10,000
SURVEYED BY: HOWARD R. SELEE REG. SURVEYOR #5471
APPROVED LORAIN CO. MAP DEPT.
DATE 12-8-95
PAGE 04-00-019 D
BY CAROLYN FRANCIS
21599
21599
21599