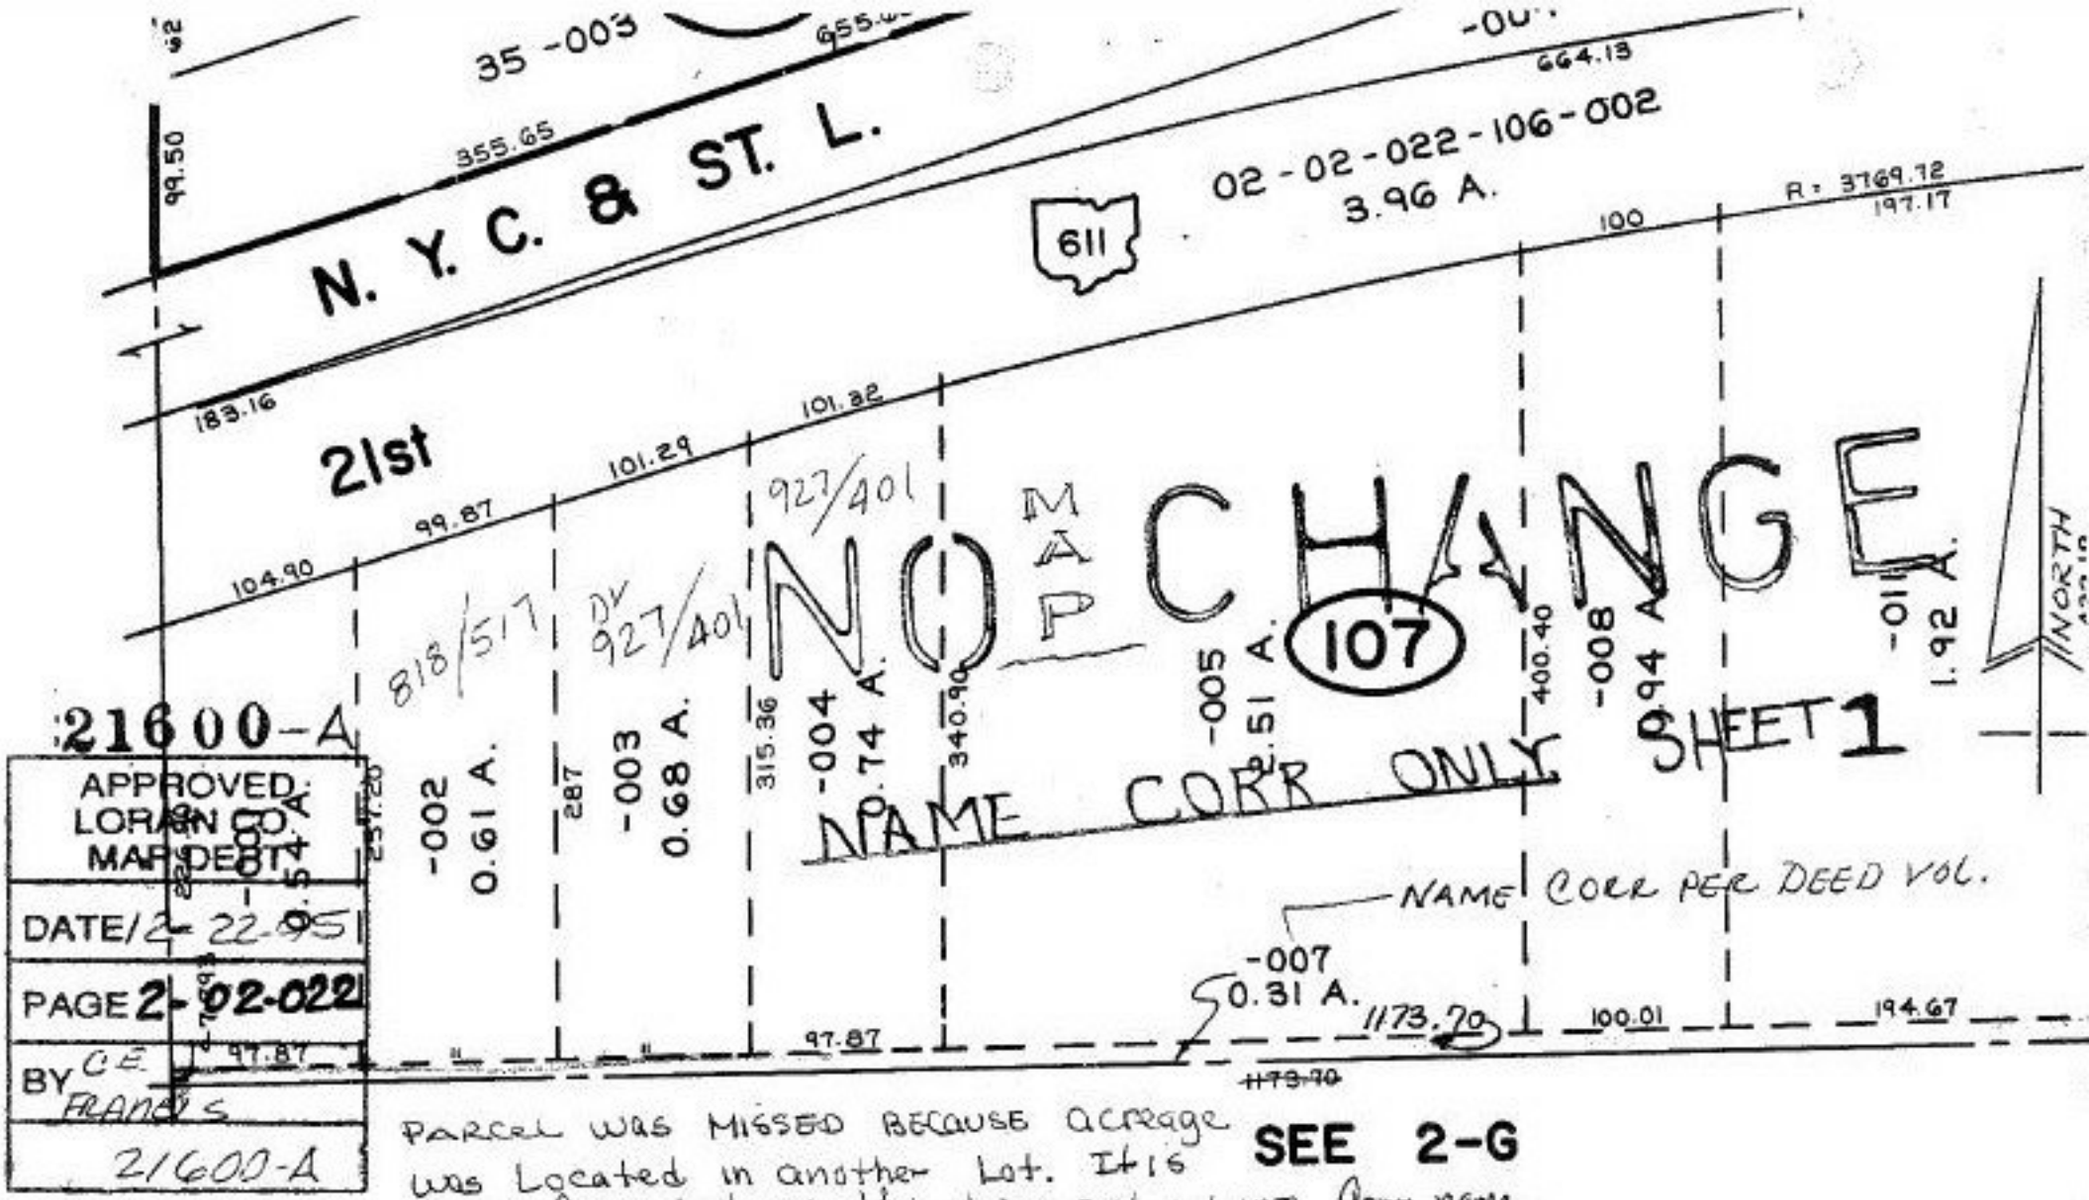

21600-A

DEED REF. # BLACK RIVER TWP.

SCALE: 1" = 100'

O.R. 1108/63 DV 1216/286
DV. 1068/159 DV. 1067/235
DV. 401/323 DV. 209/359, 364
DV. 204/220 DV. 103/267

21600-A