#21601

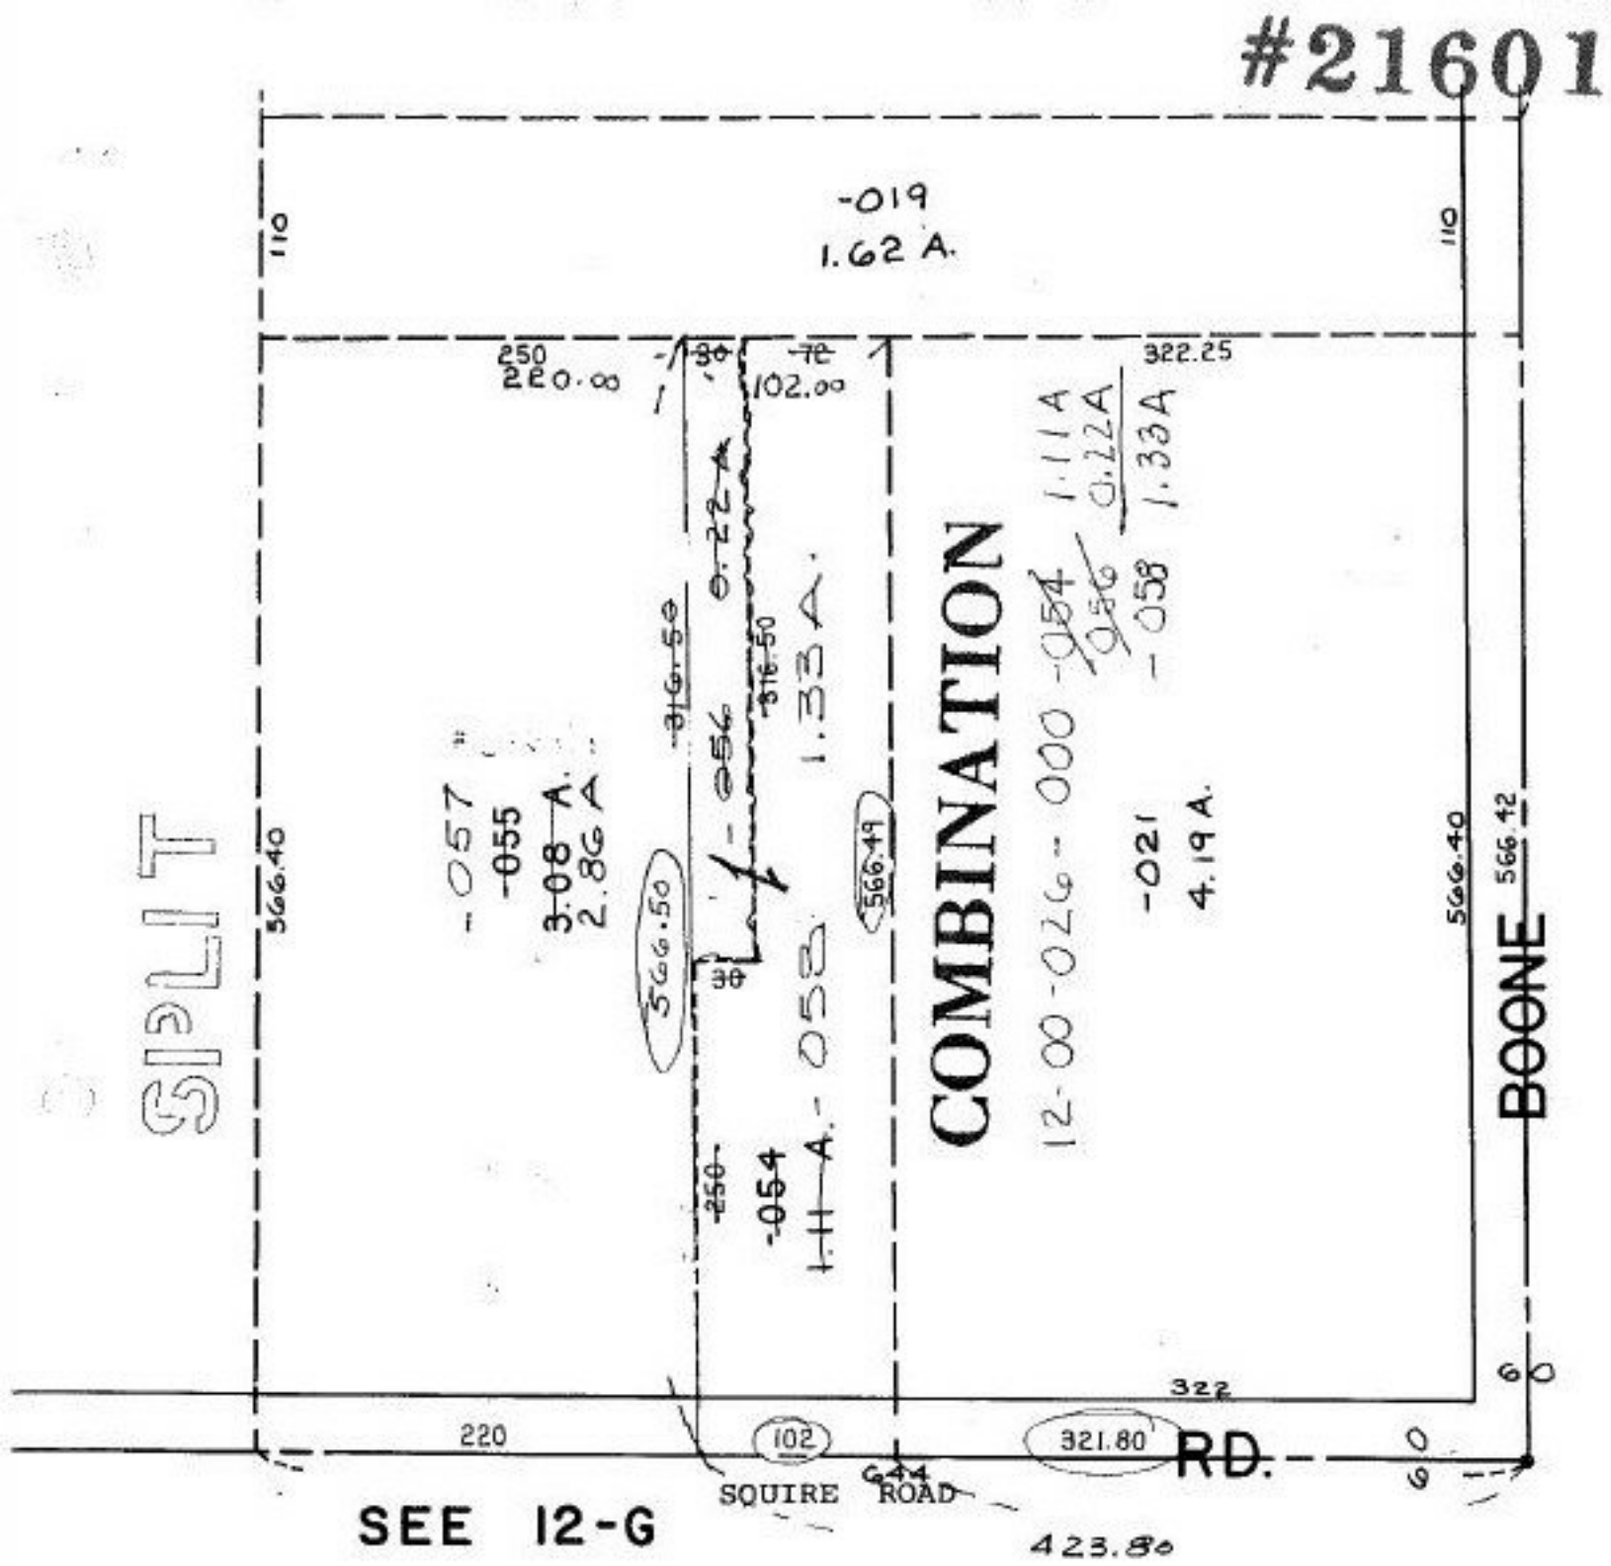

P.P.NO. 12-00-026-000
PRIOR INST:. O.R. (055)
O.R.973/5 (054)O.R.1274/
/716
CLOSURE: 0.22ac 0.06:10,
1.32ac.0.04:10,
SURVEYED BY: JOHN POZYWAK
REG. SURVEYOR

21601

APPROVED LORAIN CO. MAP DEPT
DATE 12-13-95
PAGE 12-00-026B
BY CAROLYN FRANCIS
21601

0 100 200

LUMBIA TWP.

: 1" = 100'