21602
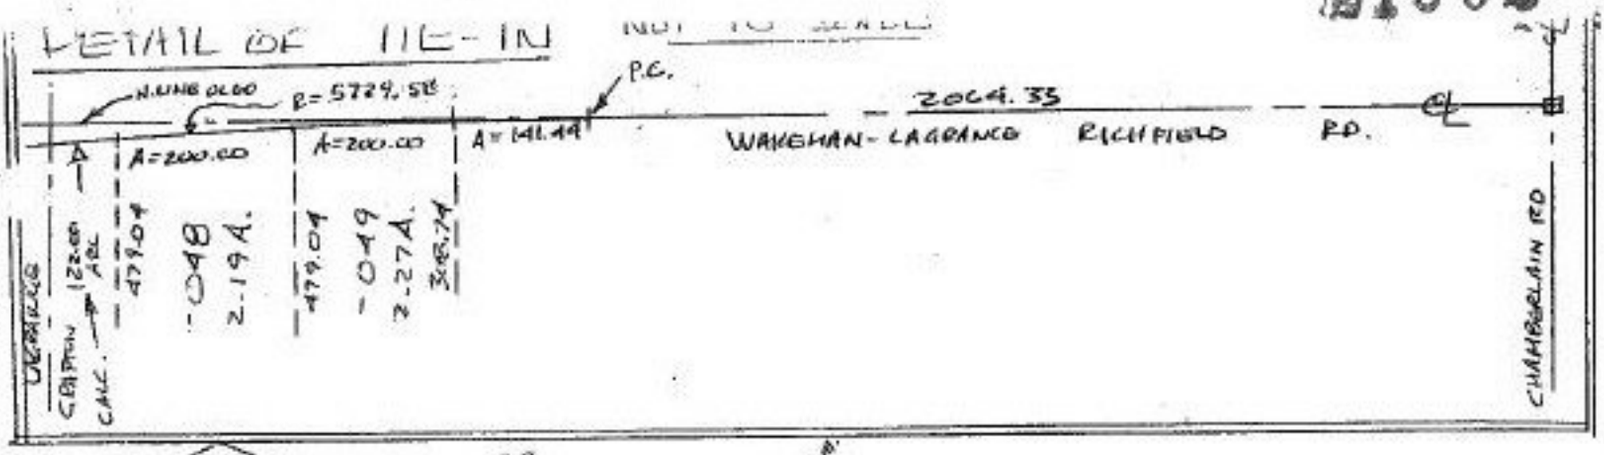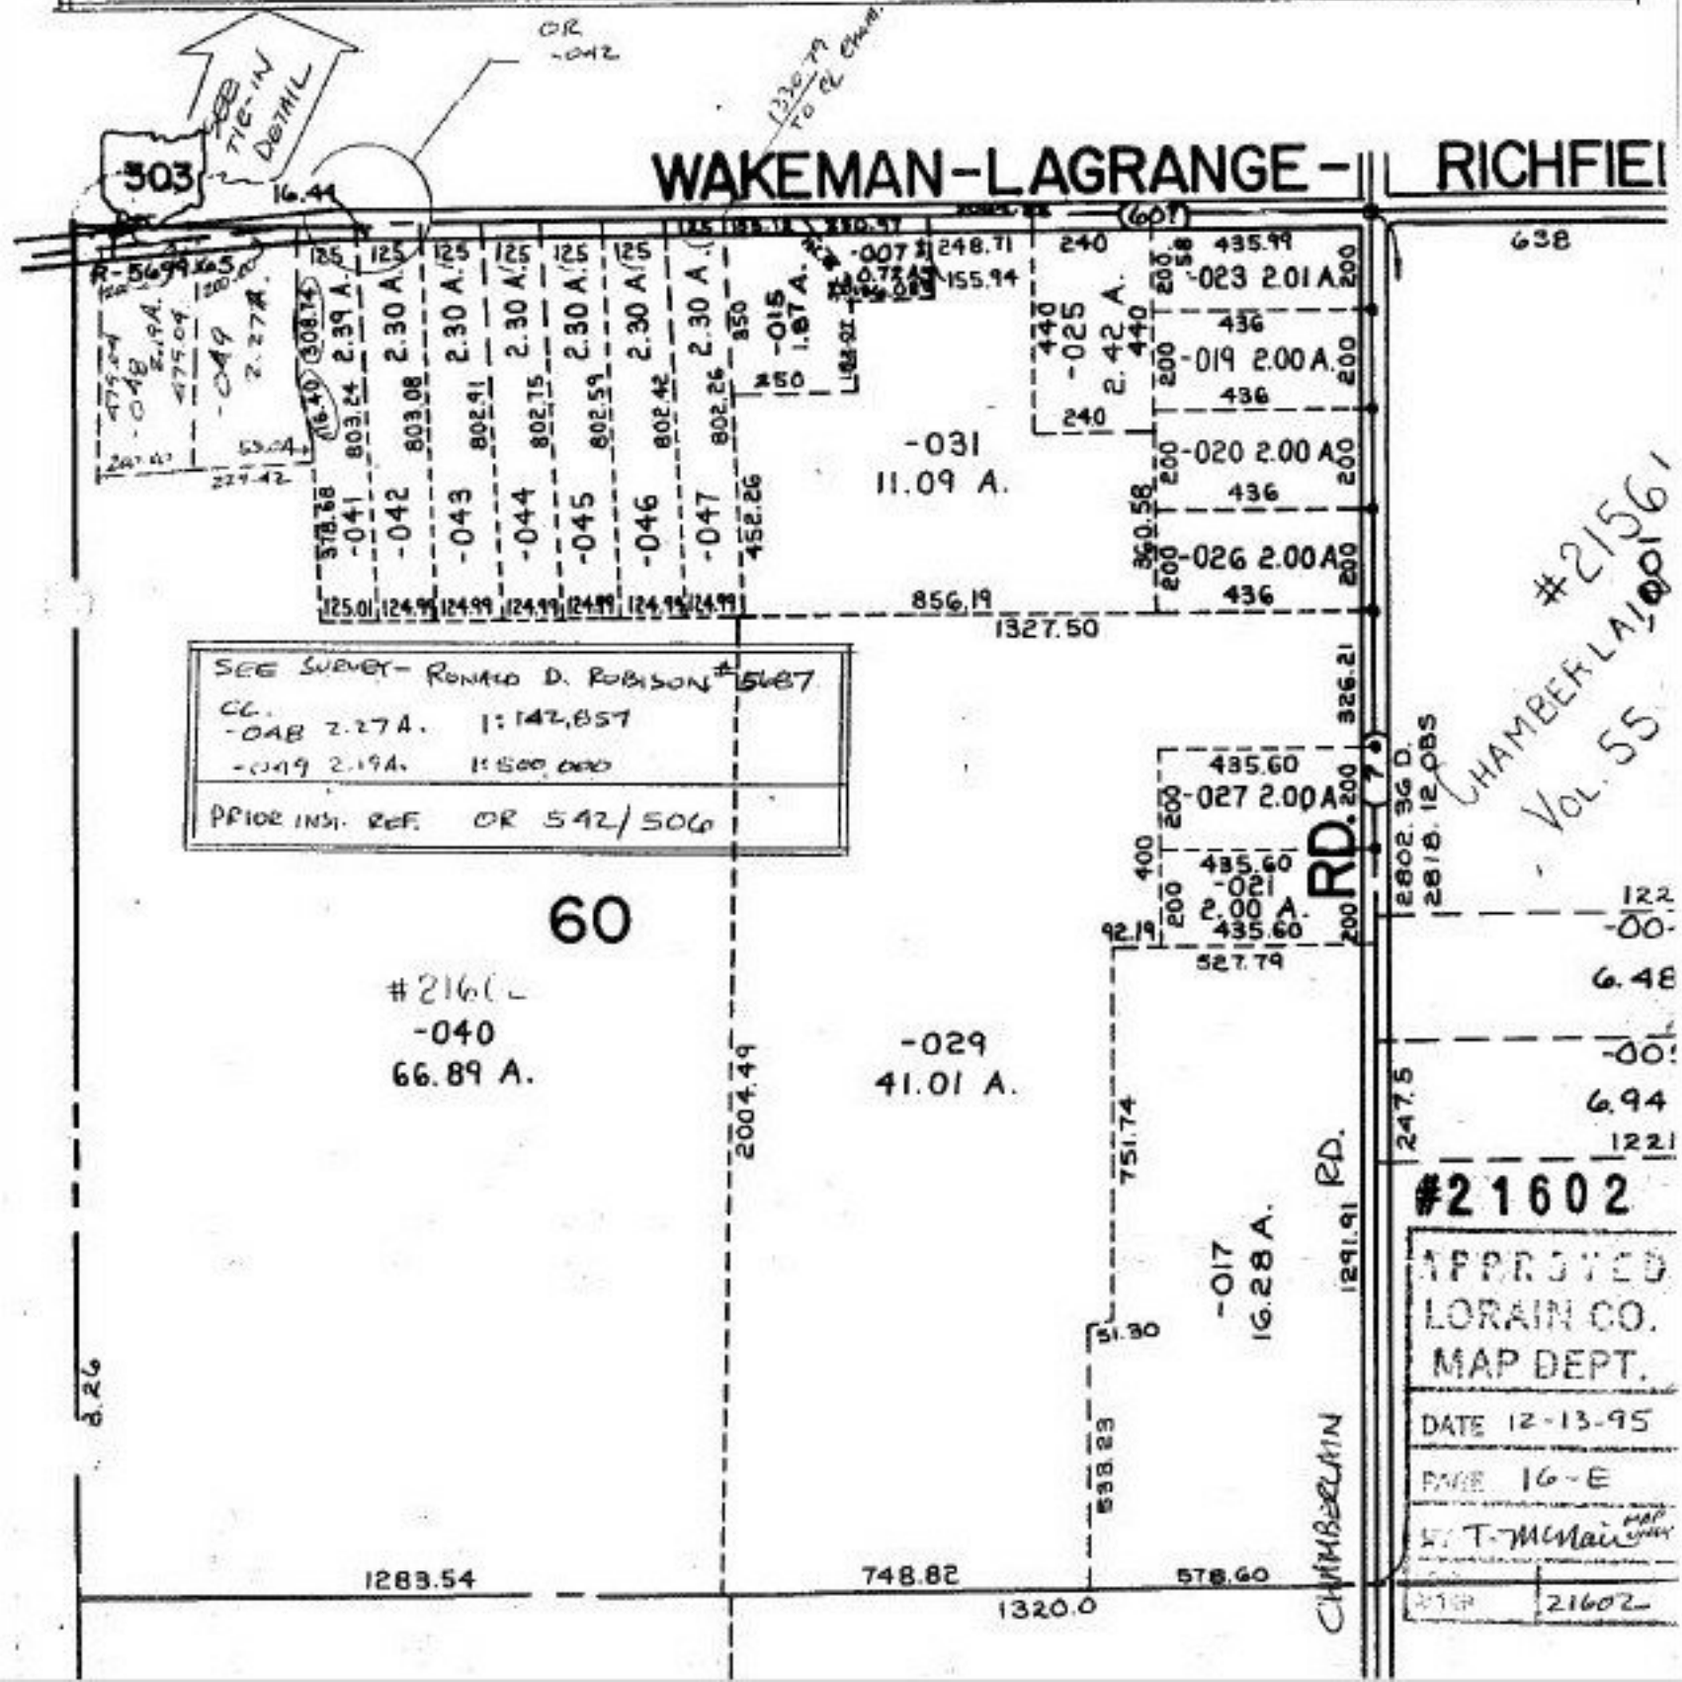
DETAIL OF TIE-IN NOT TO SCALE