21602

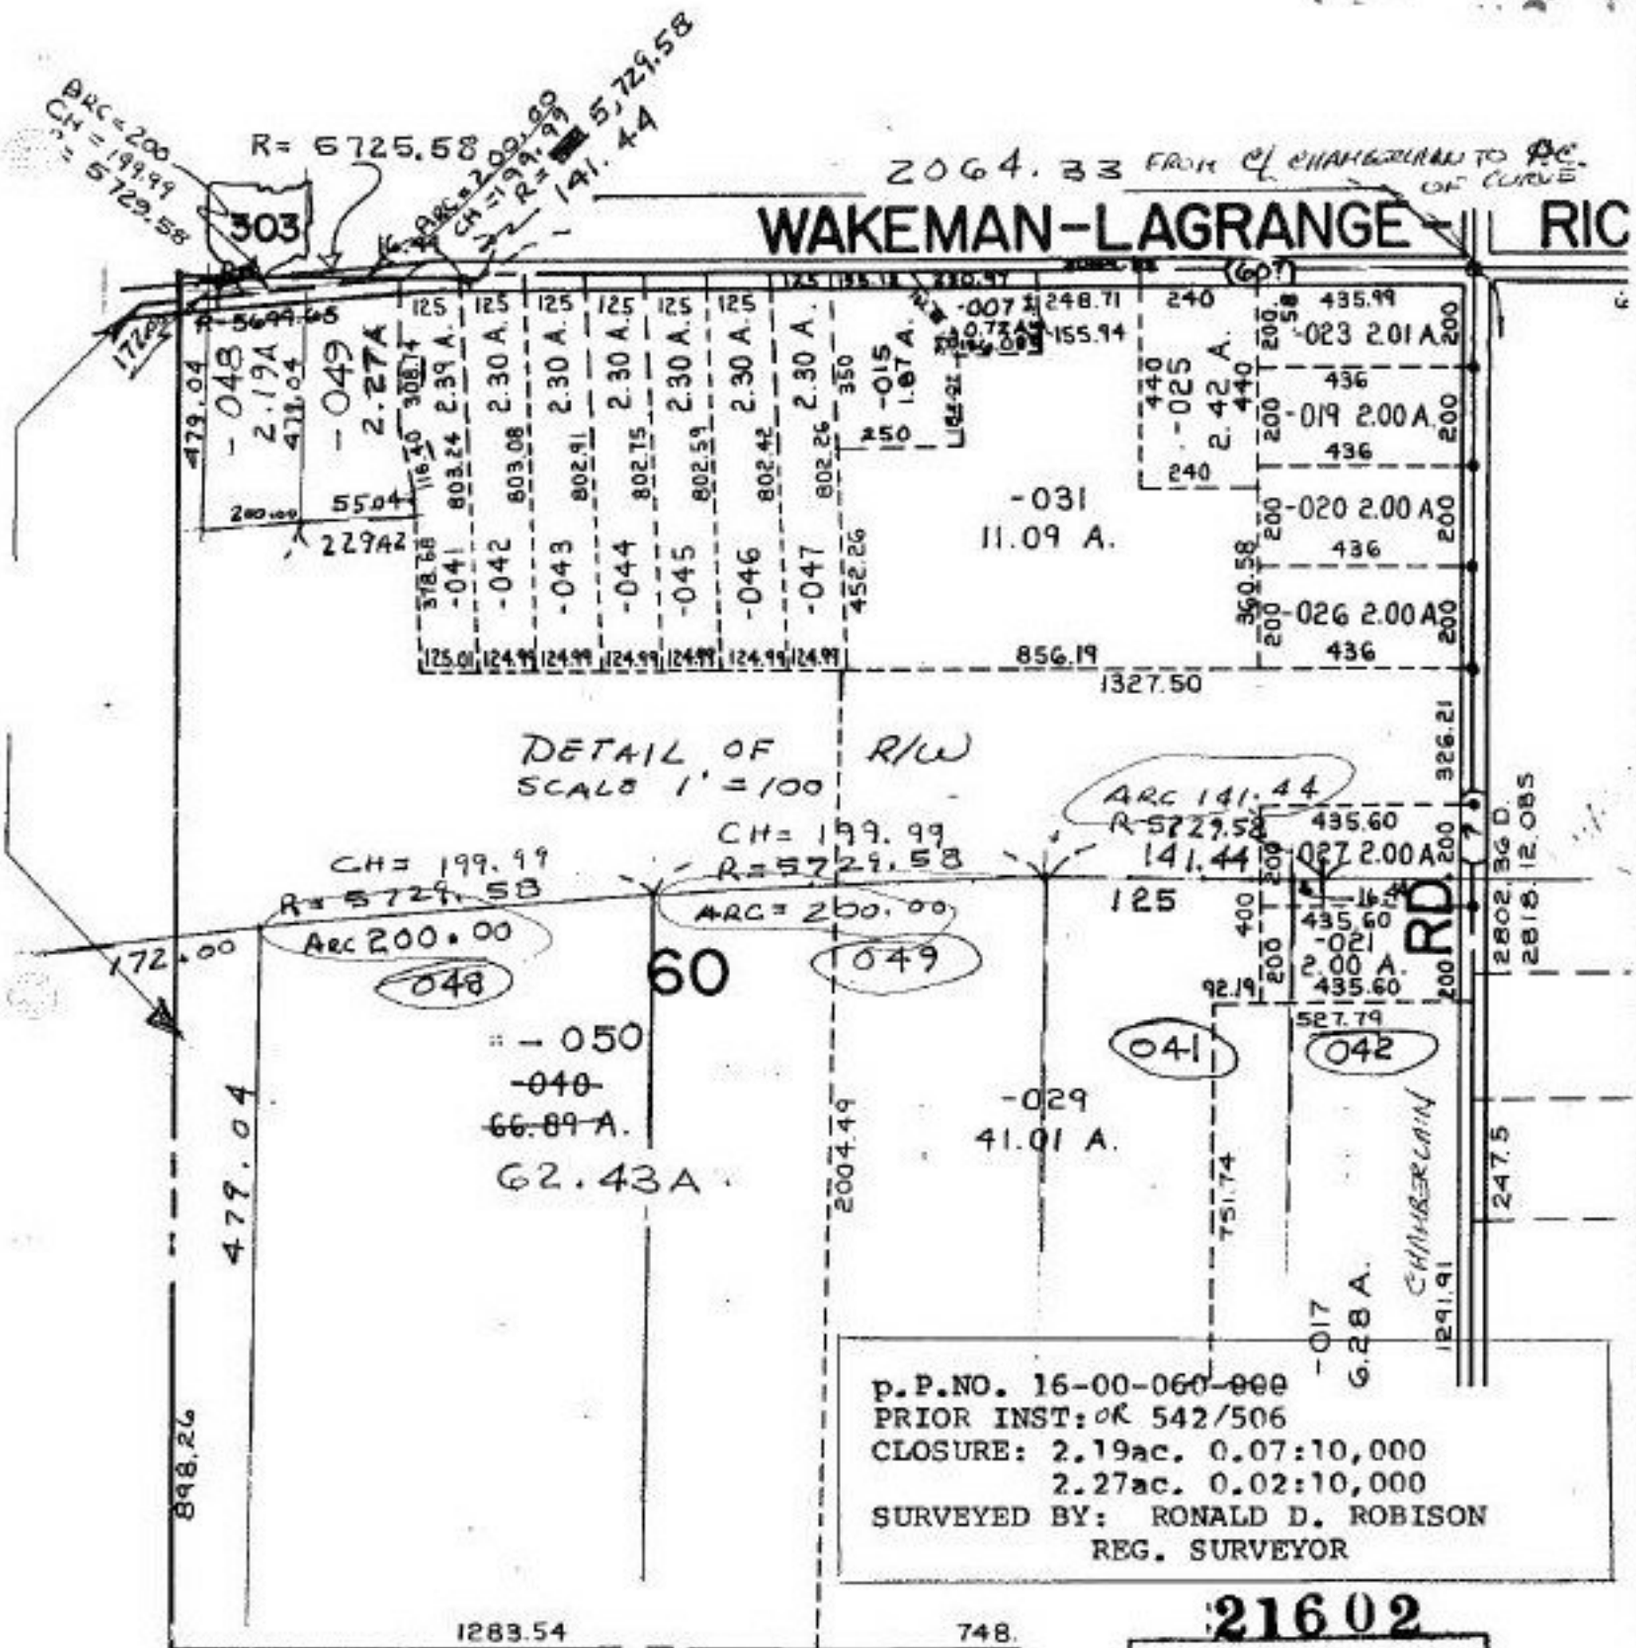

21602

APPROVED
LORAIN CO.
MAP DEPT

DATE 12-13-95

PAGE 16-E

BY CAROLYN FRANCIS

21602