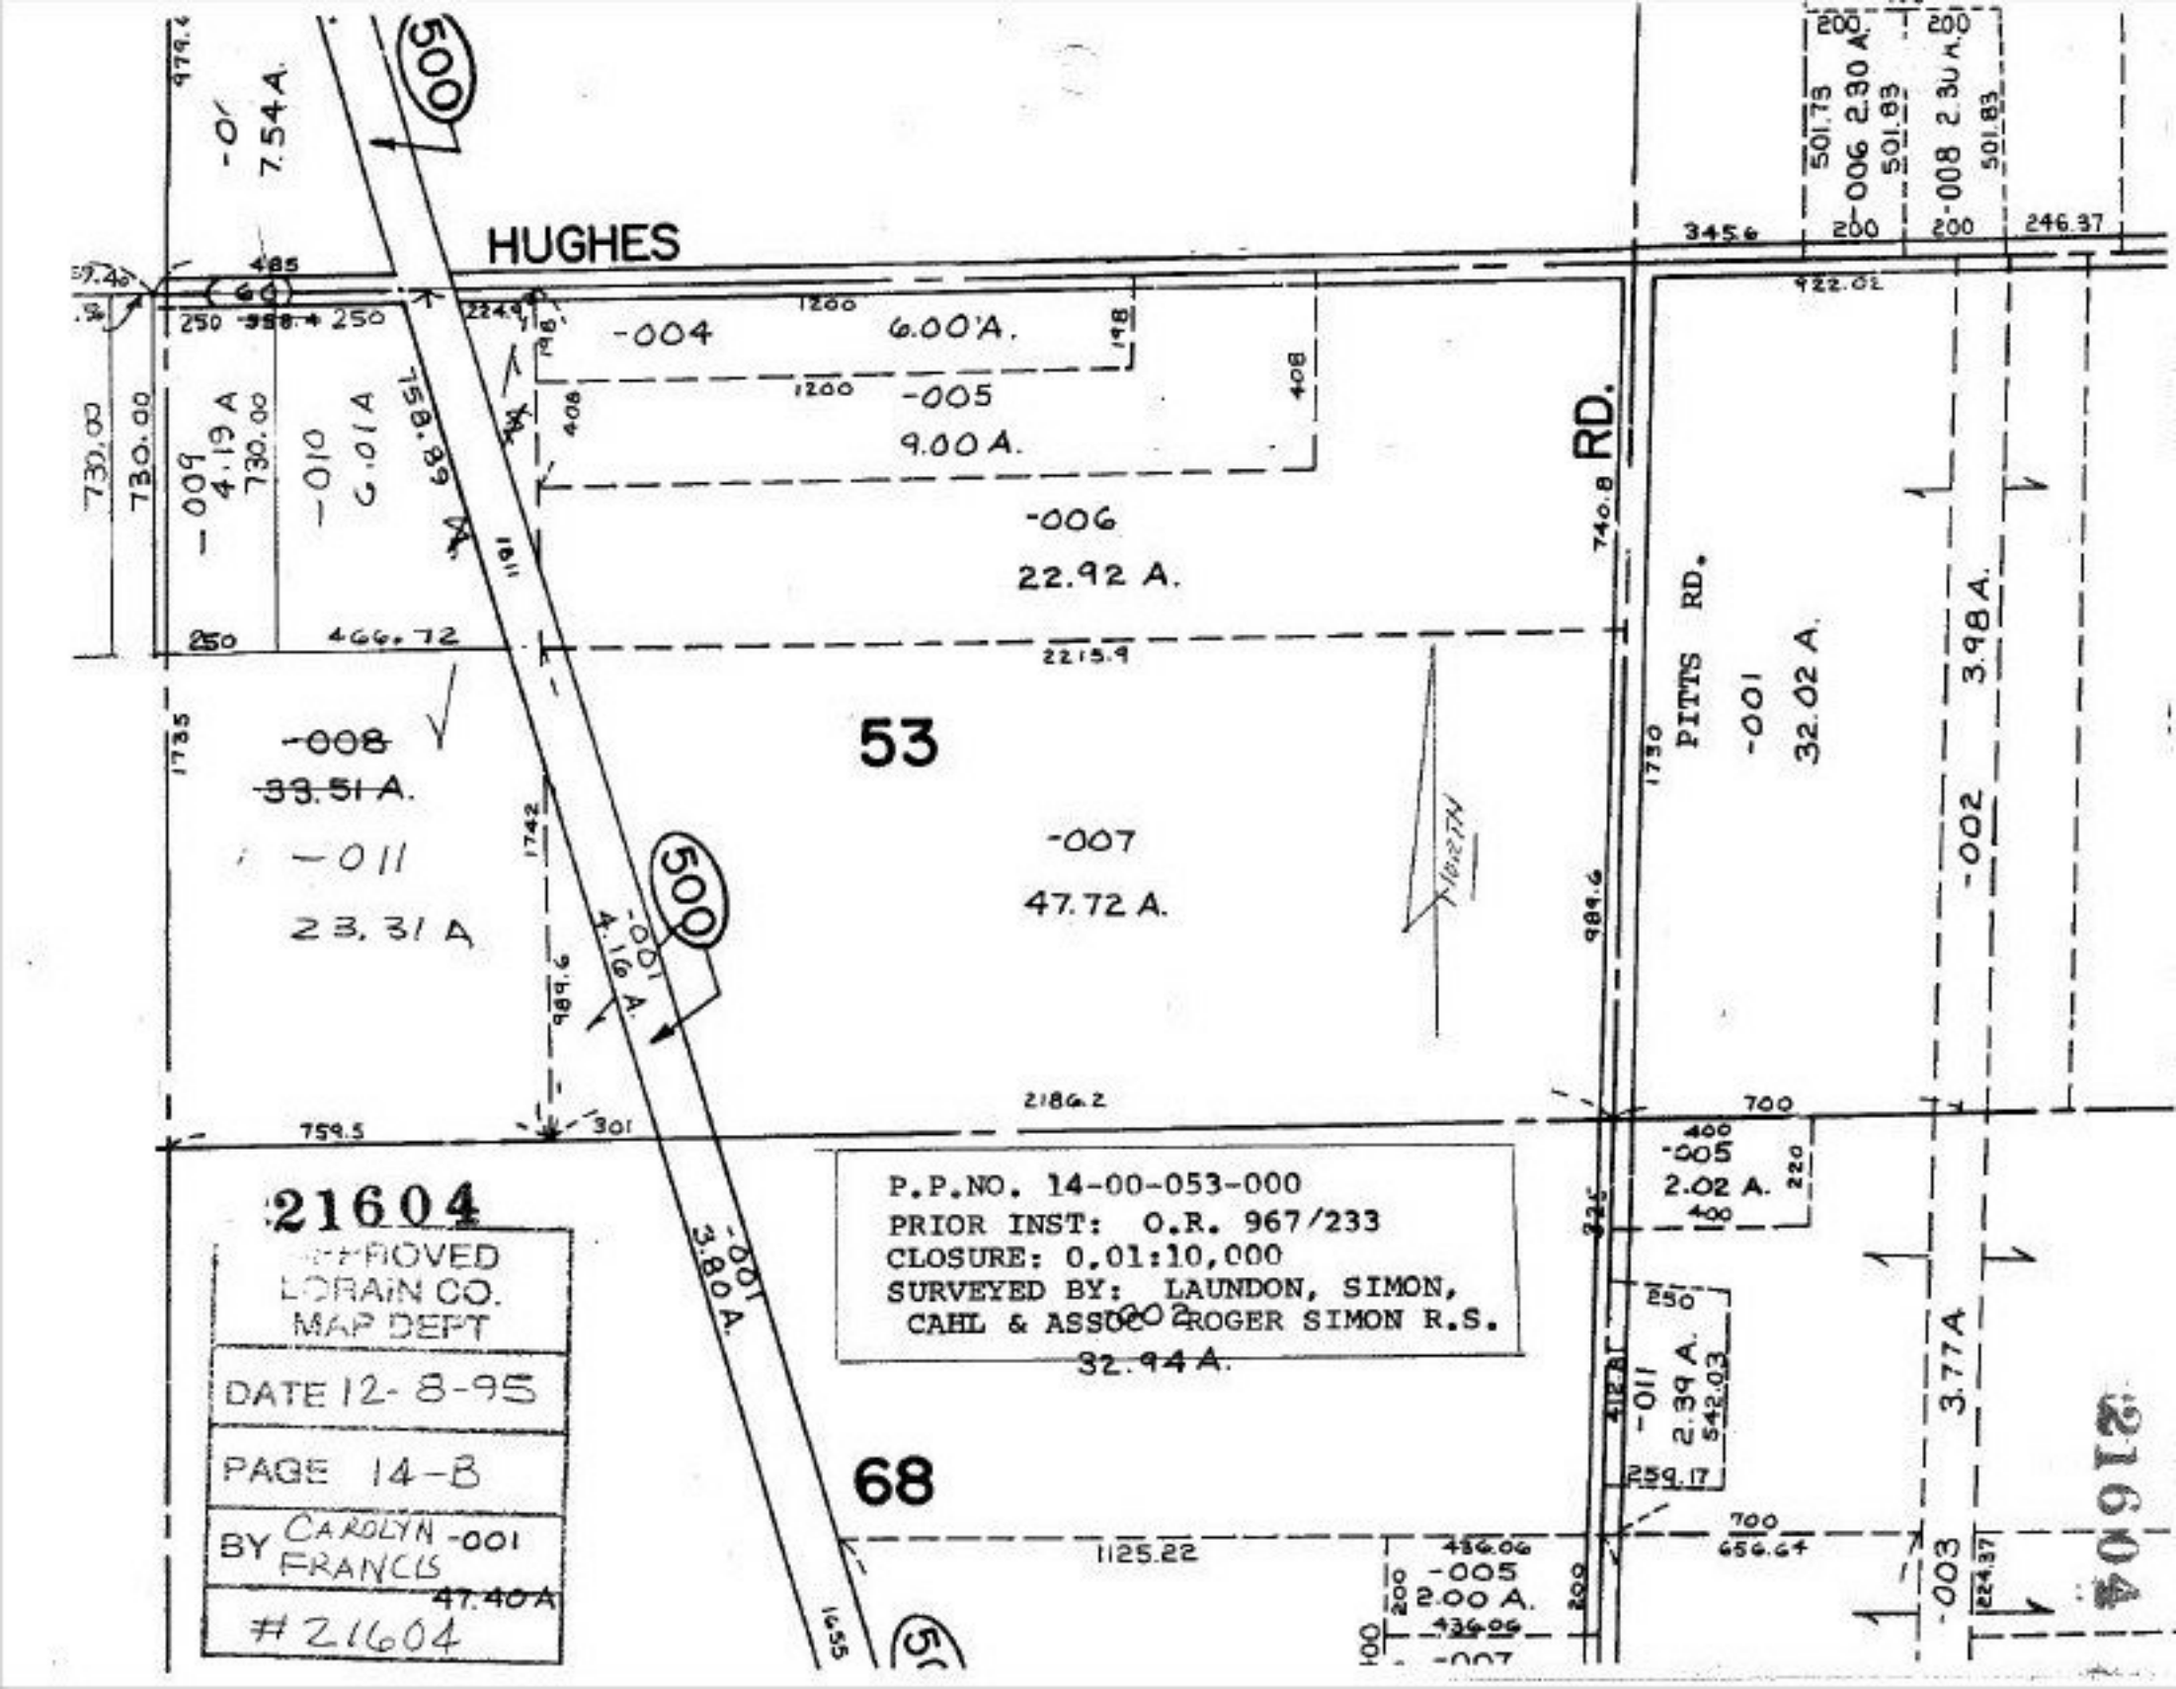
HUGHES
RD.
PITTS RD.
53
68
-004
6.00 A.
-005
9.00 A.
-006
22.92 A.
-007
47.72 A.
-008
33.51 A.
-009
4.19 A
-010
6.01 A
-011
23.31 A
-001
4.16 A.
-001
3.80 A.
-001
32.02 A.
-002
3.98 A.
-003
3.77 A
-005
2.02 A.
-011
2.39 A.
-005
2.00 A.
-006 2.30 A.
-008 2.30 A.
500
P.P.NO. 14-00-053-000
PRIOR INST: O.R. 967/233
CLOSURE: 0.01:10,000
SURVEYED BY: LAUNDON, SIMON, CAHL & ASSOC ROGER SIMON R.S.
32.94 A.
21604
APPROVED
LORAIN CO.
MAP DEPT
DATE 12-8-95
PAGE 14-B
BY CAROLYN FRANCIS
#21604
21604