#21609

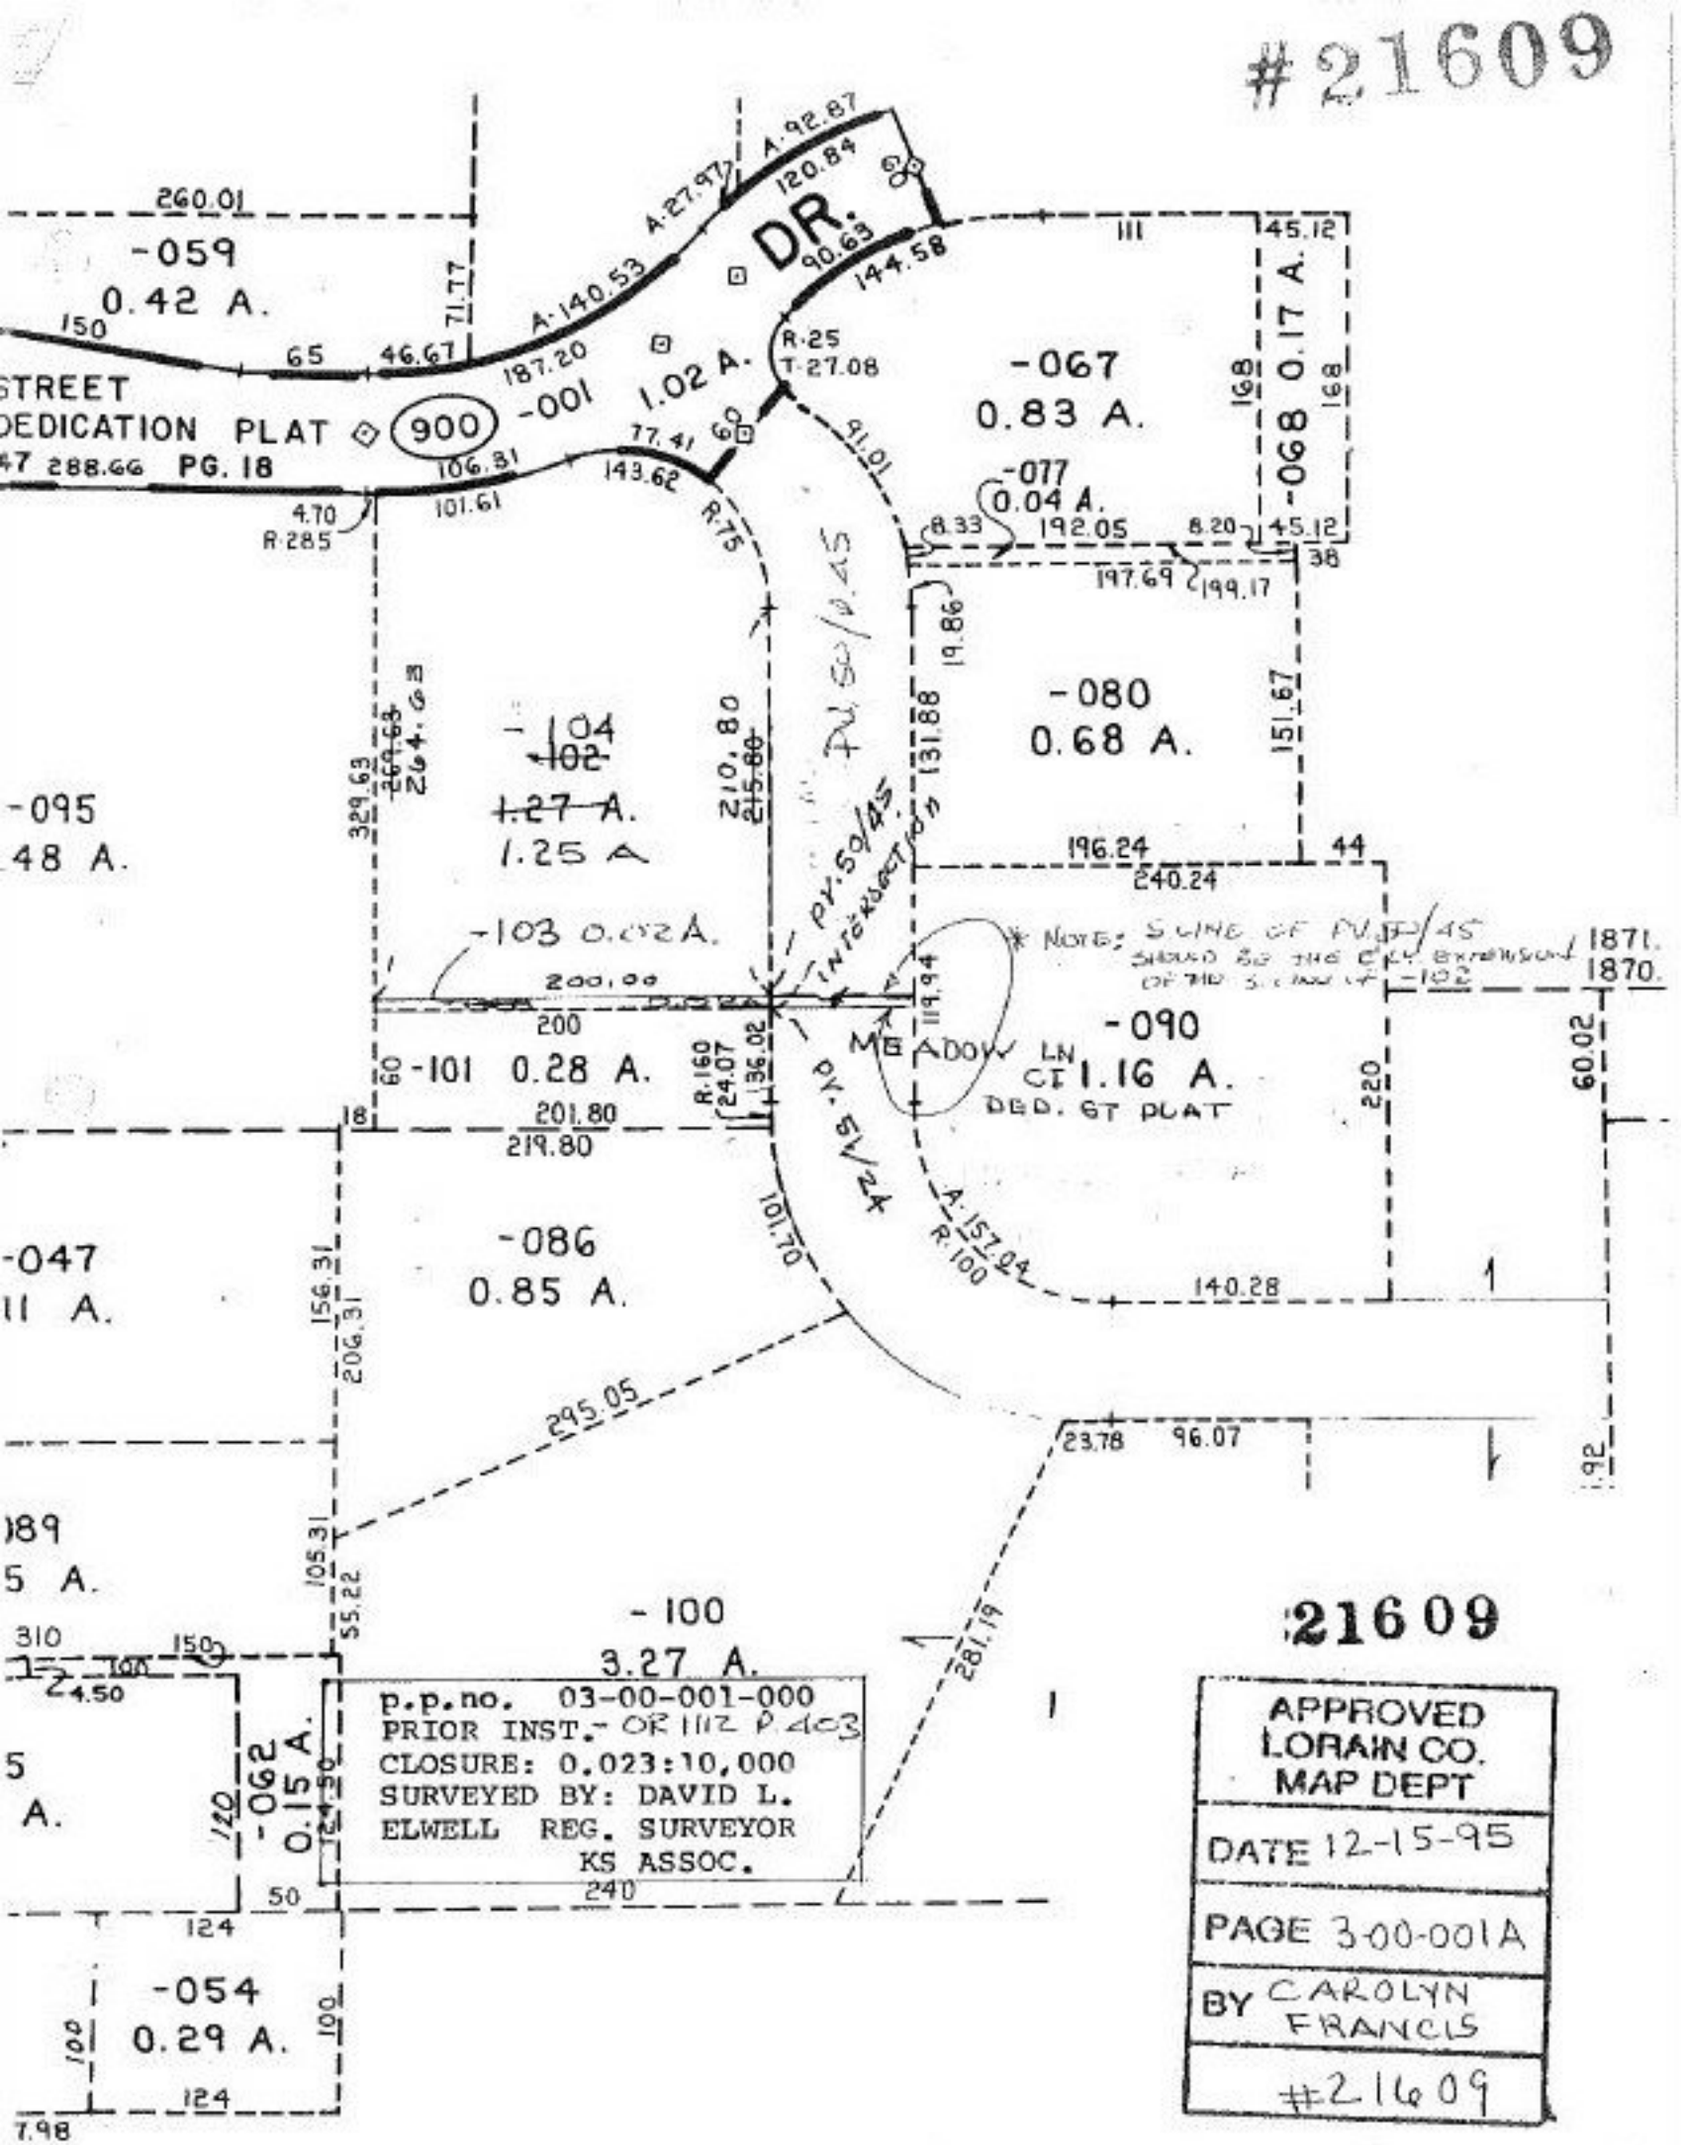

#21609

APPROVED LORAIN CO. MAP DEPT
DATE 12-15-95
PAGE 3-00-001A
BY CAROLYN FRANCIS
#21609