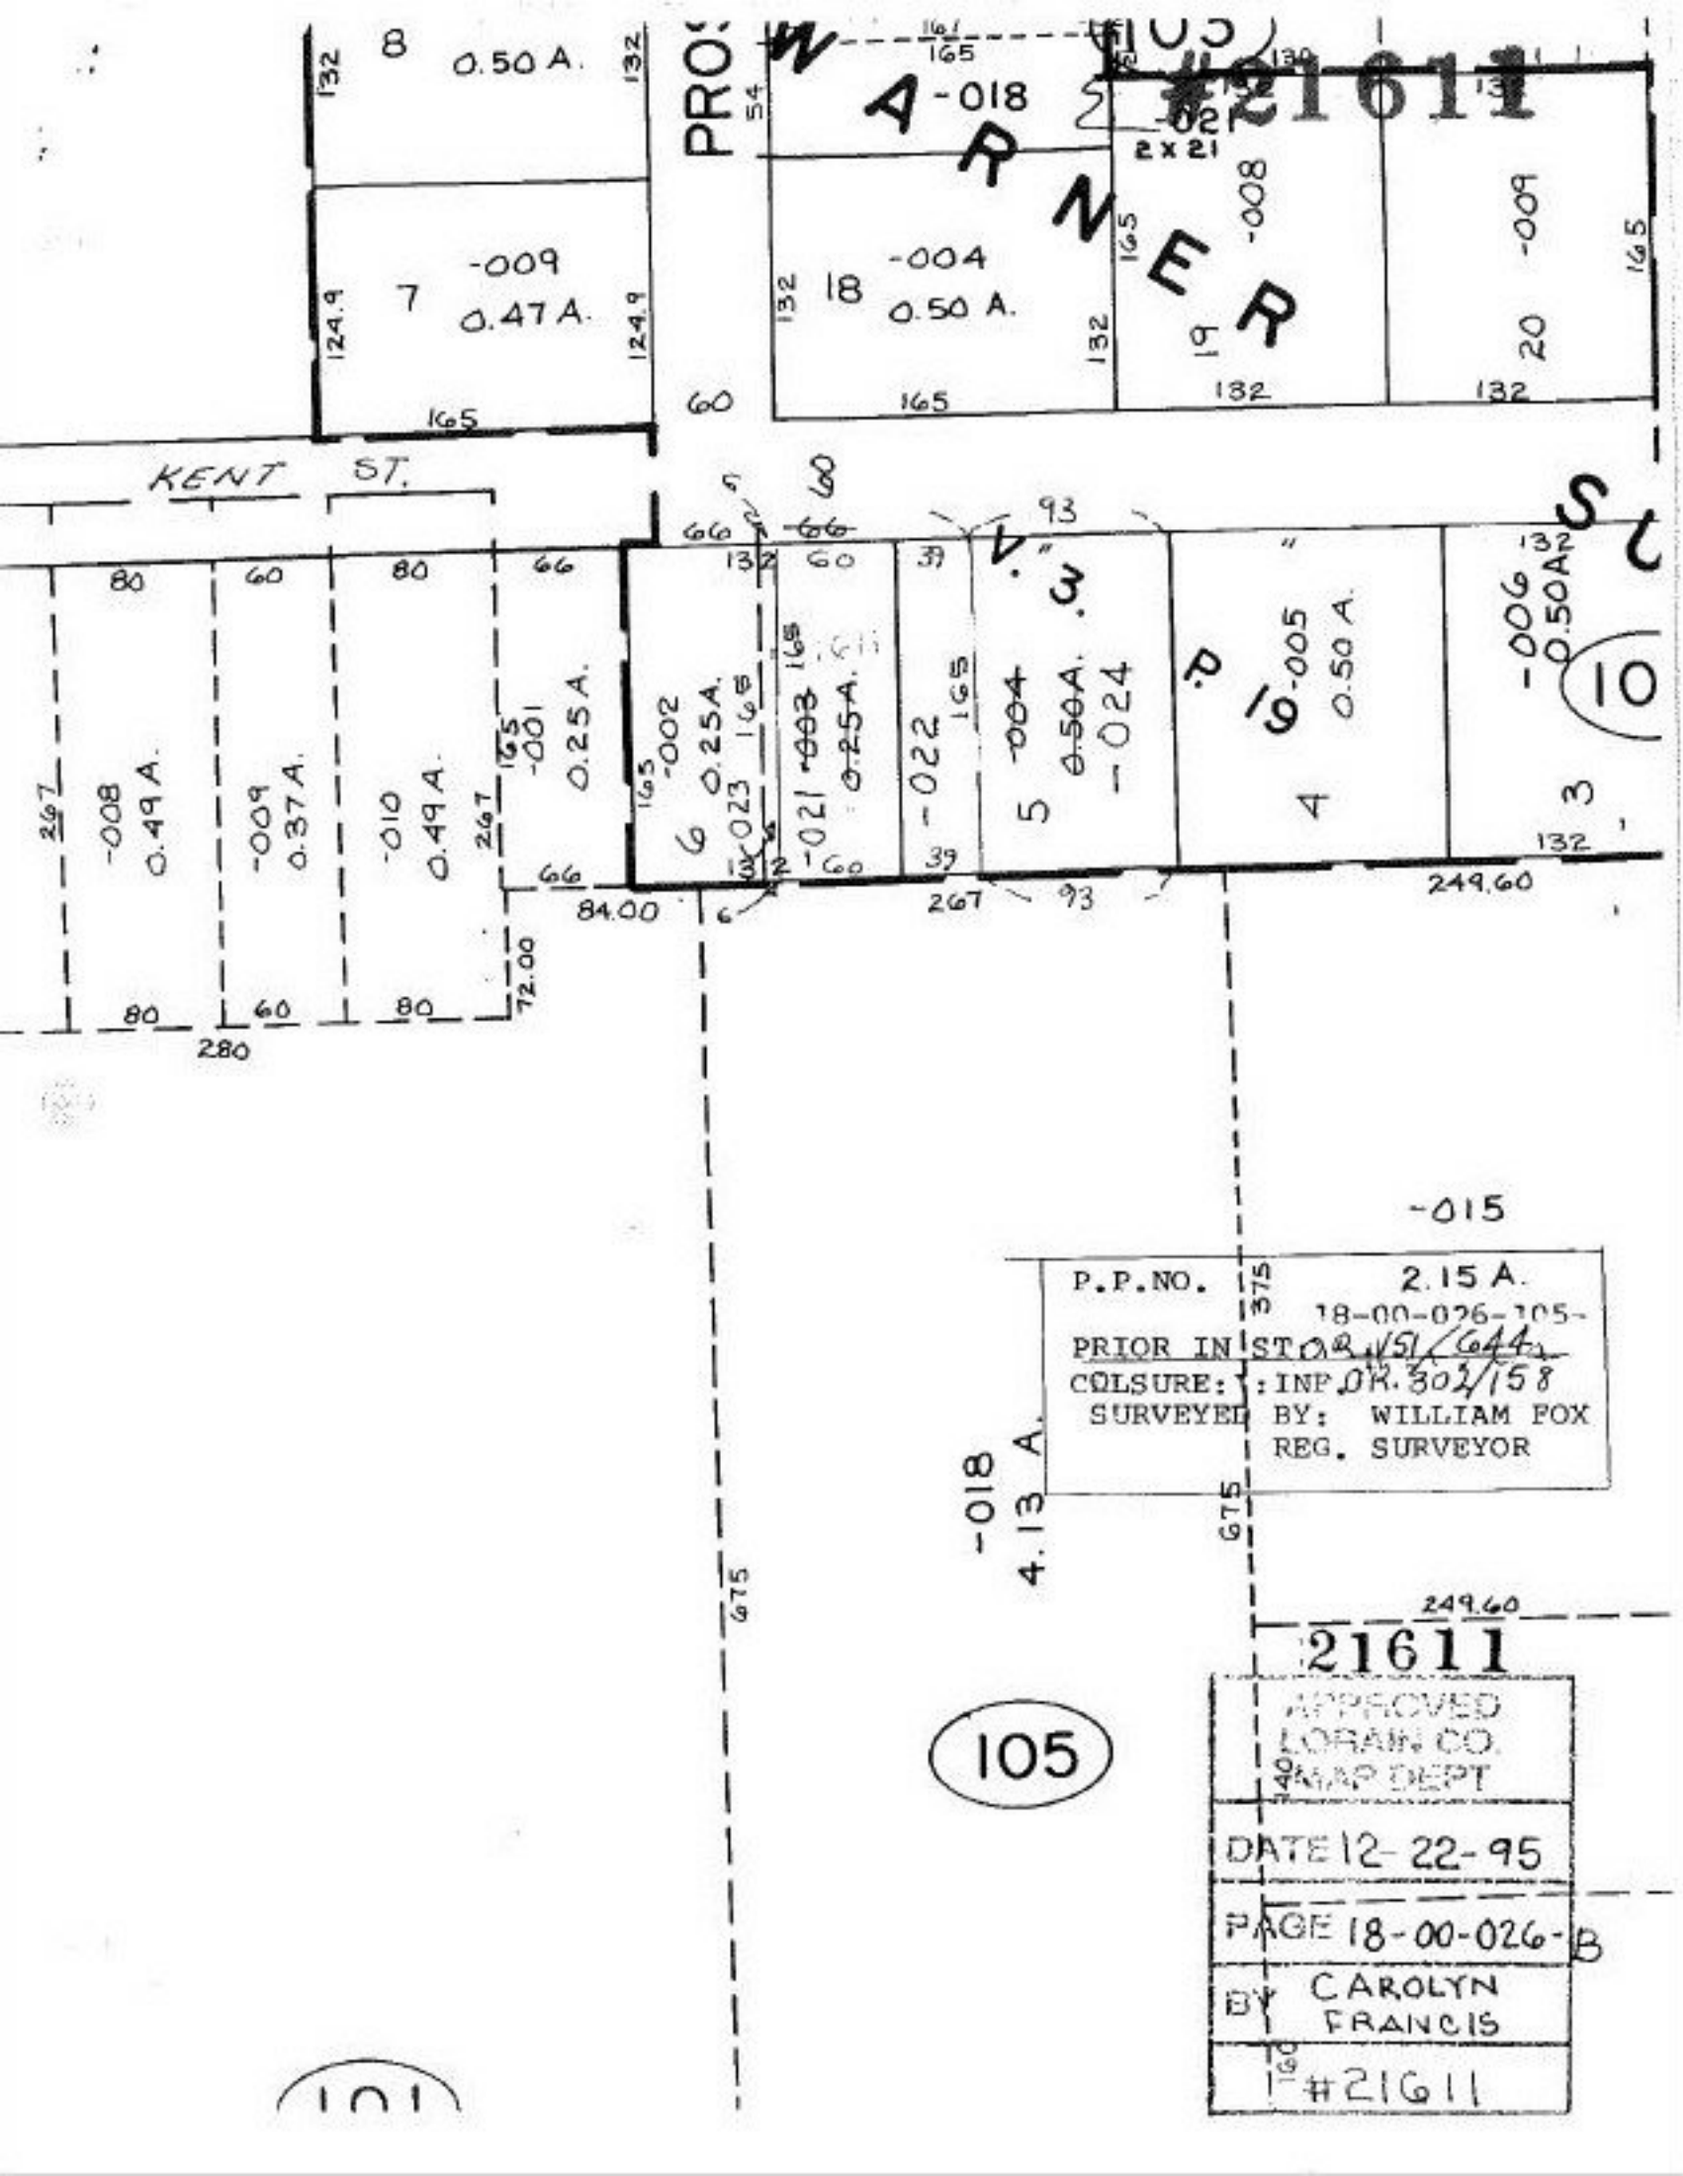
#21611
KENT ST.
8
0.50 A.
7
-009
0.47 A.
-018
-004
0.50 A.
18
-008
19
-009
20
-008
0.49 A.
-009
0.37 A.
-010
0.49 A.
-001
0.25 A.
-002
0.25 A.
-023
-021
0.25 A.
-022
-004
0.50 A.
-024
5
0.50 A.
4
-005
0.50 A.
-006
0.50 A.
3
-015
P.P.NO.
2.15 A.
18-00-026-105-
PRIOR IN STR. VOL. 151 PG. 644
CLOSURE: INP. OR. 302/158
SURVEYED BY: WILLIAM FOX
REG. SURVEYOR
-018
4.13 A.
105
101
APPROVED
LORAIN CO.
MAP DEPT
DATE 12-22-95
PAGE 18-00-026-B
BY CAROLYN FRANCIS
#21611