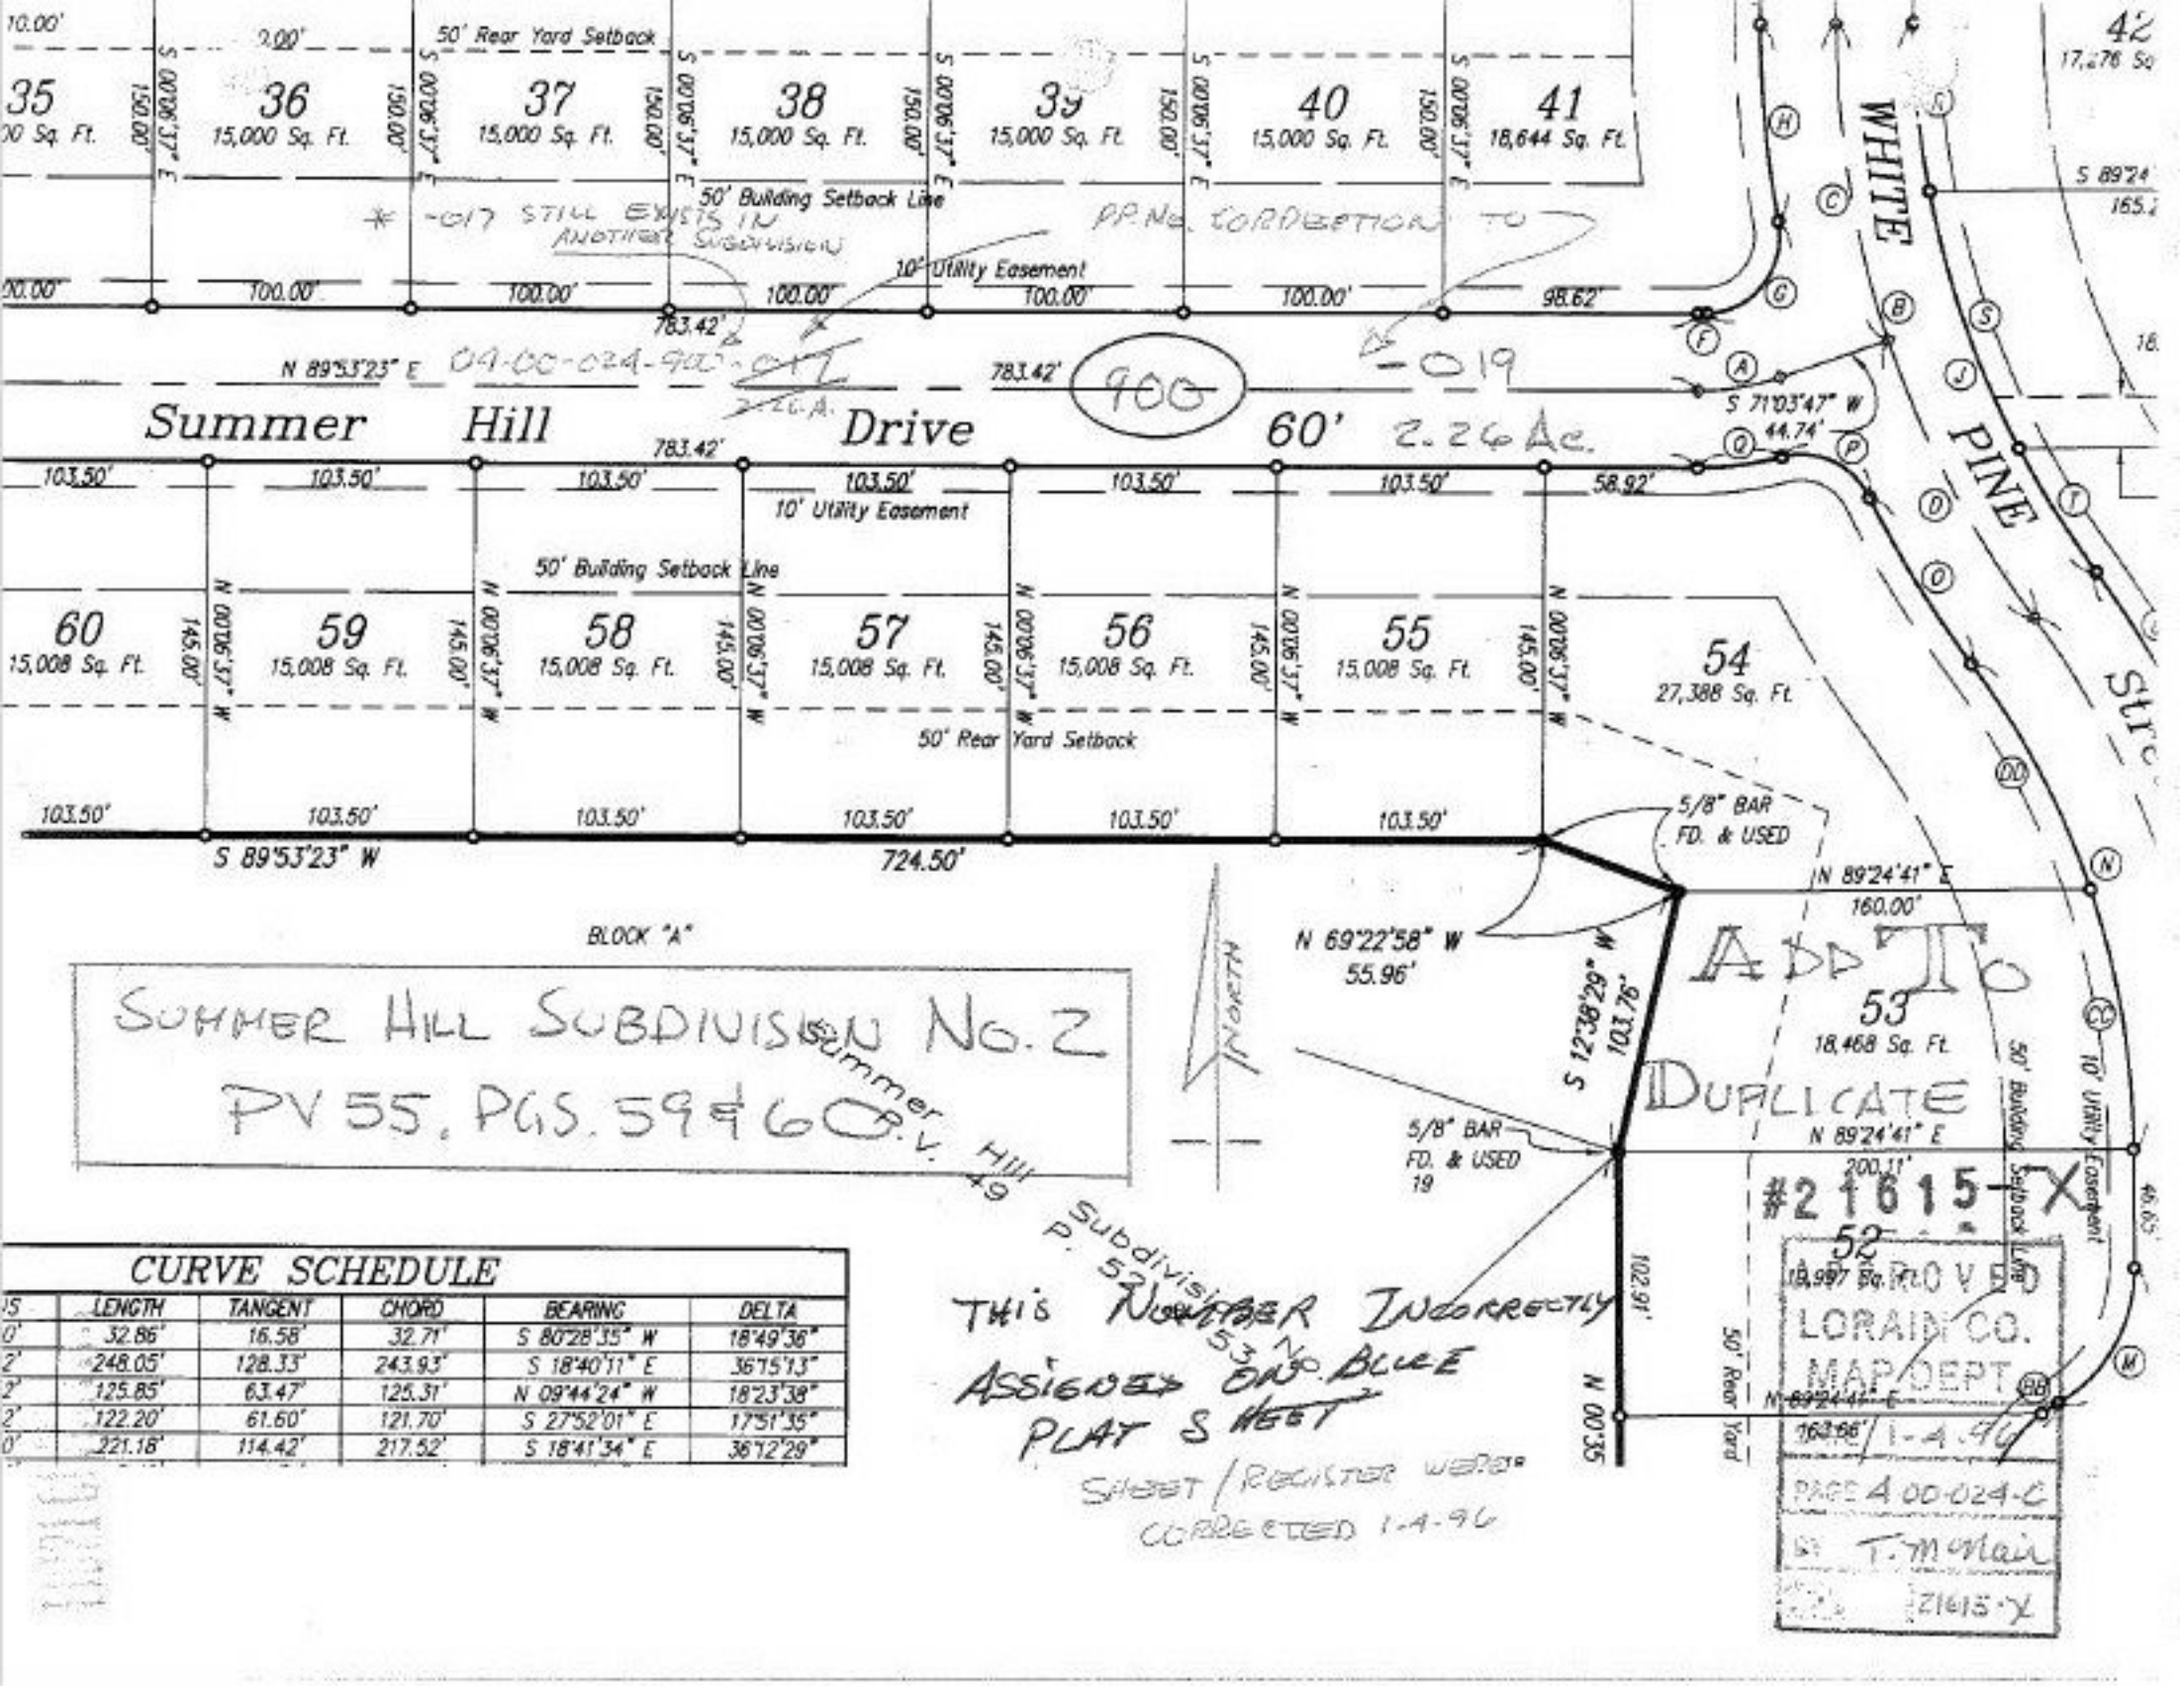

CURVE SCHEDULE					
S	LENGTH	TANGENT	CHORD	BEARING	DELTA
0'	32.86'	16.58'	32.71'	S 80°28'35" W	18°49'36"
2'	248.05'	128.33'	243.93'	S 18°40'11" E	36°15'13"
2'	125.85'	63.47'	125.31'	N 09°44'24" W	18°23'38"
2'	122.20'	61.60'	121.70'	S 27°52'01" E	17°51'35"
0'	221.18'	114.42'	217.52'	S 18°41'34" E	36°12'29"

THIS NUMBER INCORRECTLY ASSIGNED ON BLUE PLAT SHEET

SHEET / REGISTER WERE CORRECTED 1-4-96

APPROVED
LORAIN CO.
MAP DEPT.
DATE 1-4-96
PAGE 4 00-024-C
BY T. McNair
21615-X