#21616

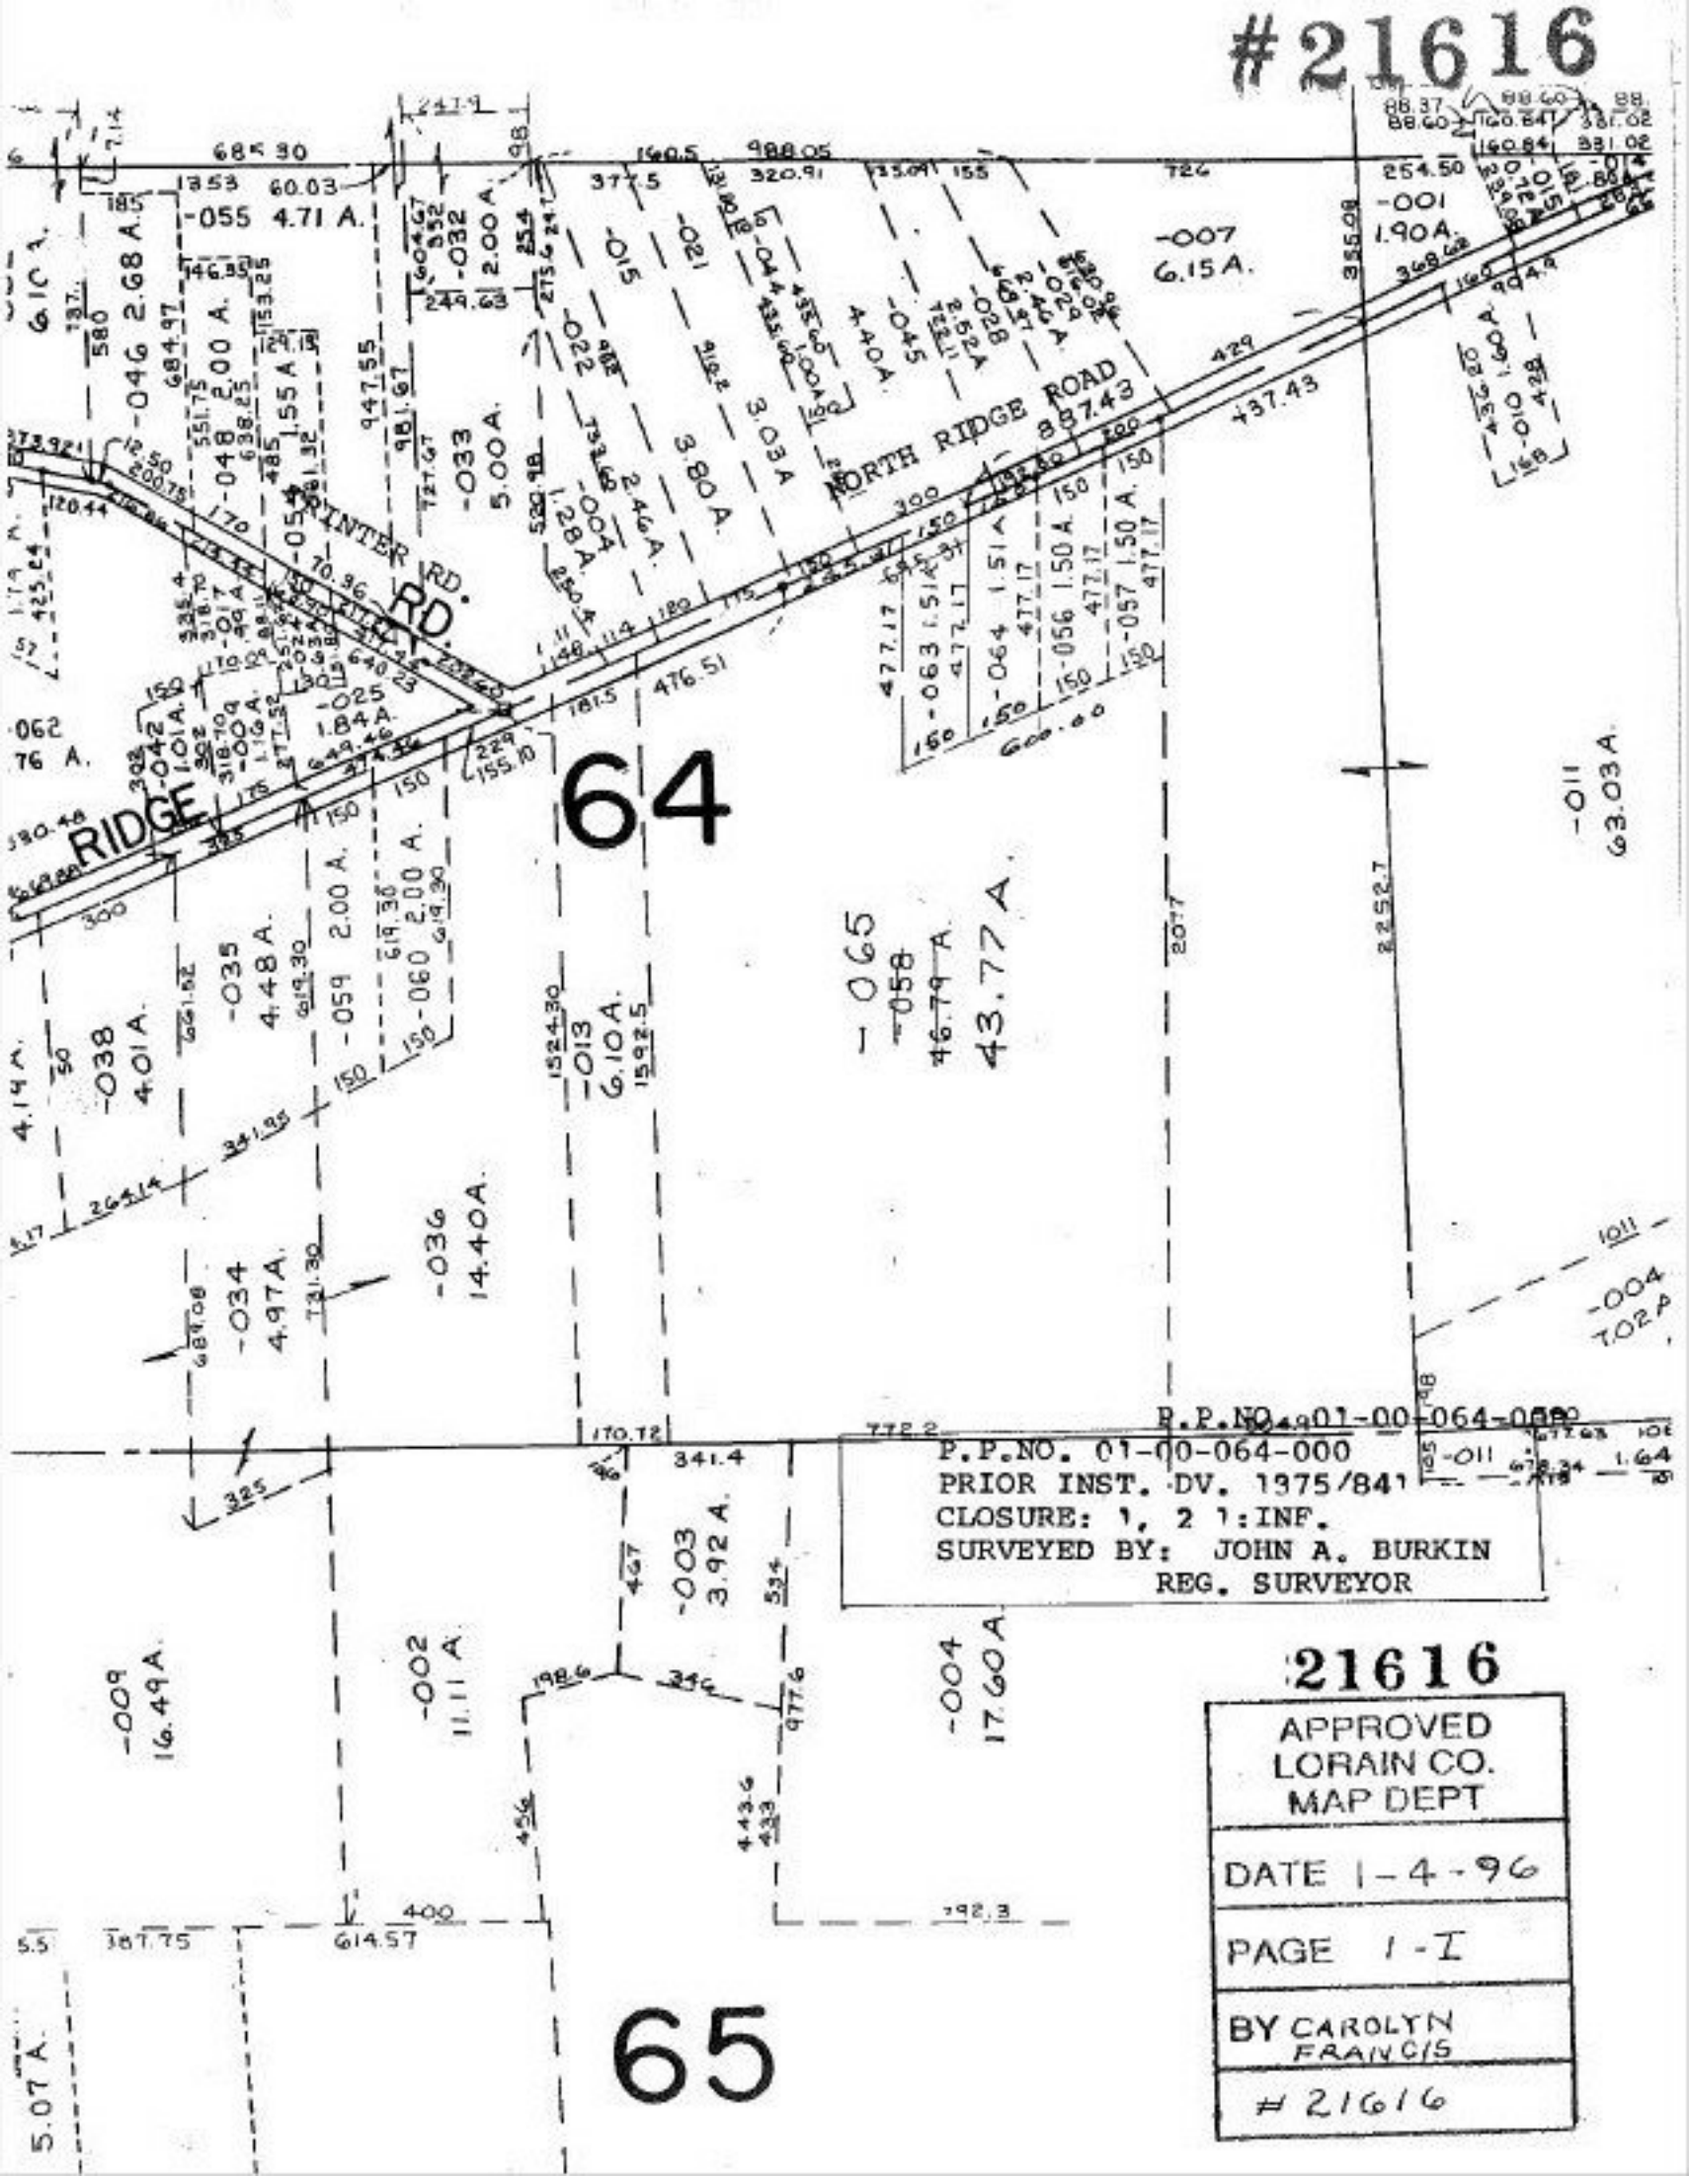

21616

APPROVED LORAIN CO. MAP DEPT
DATE 1-4-96
PAGE 1-I
BY CAROLYN FRANCIS
#21616