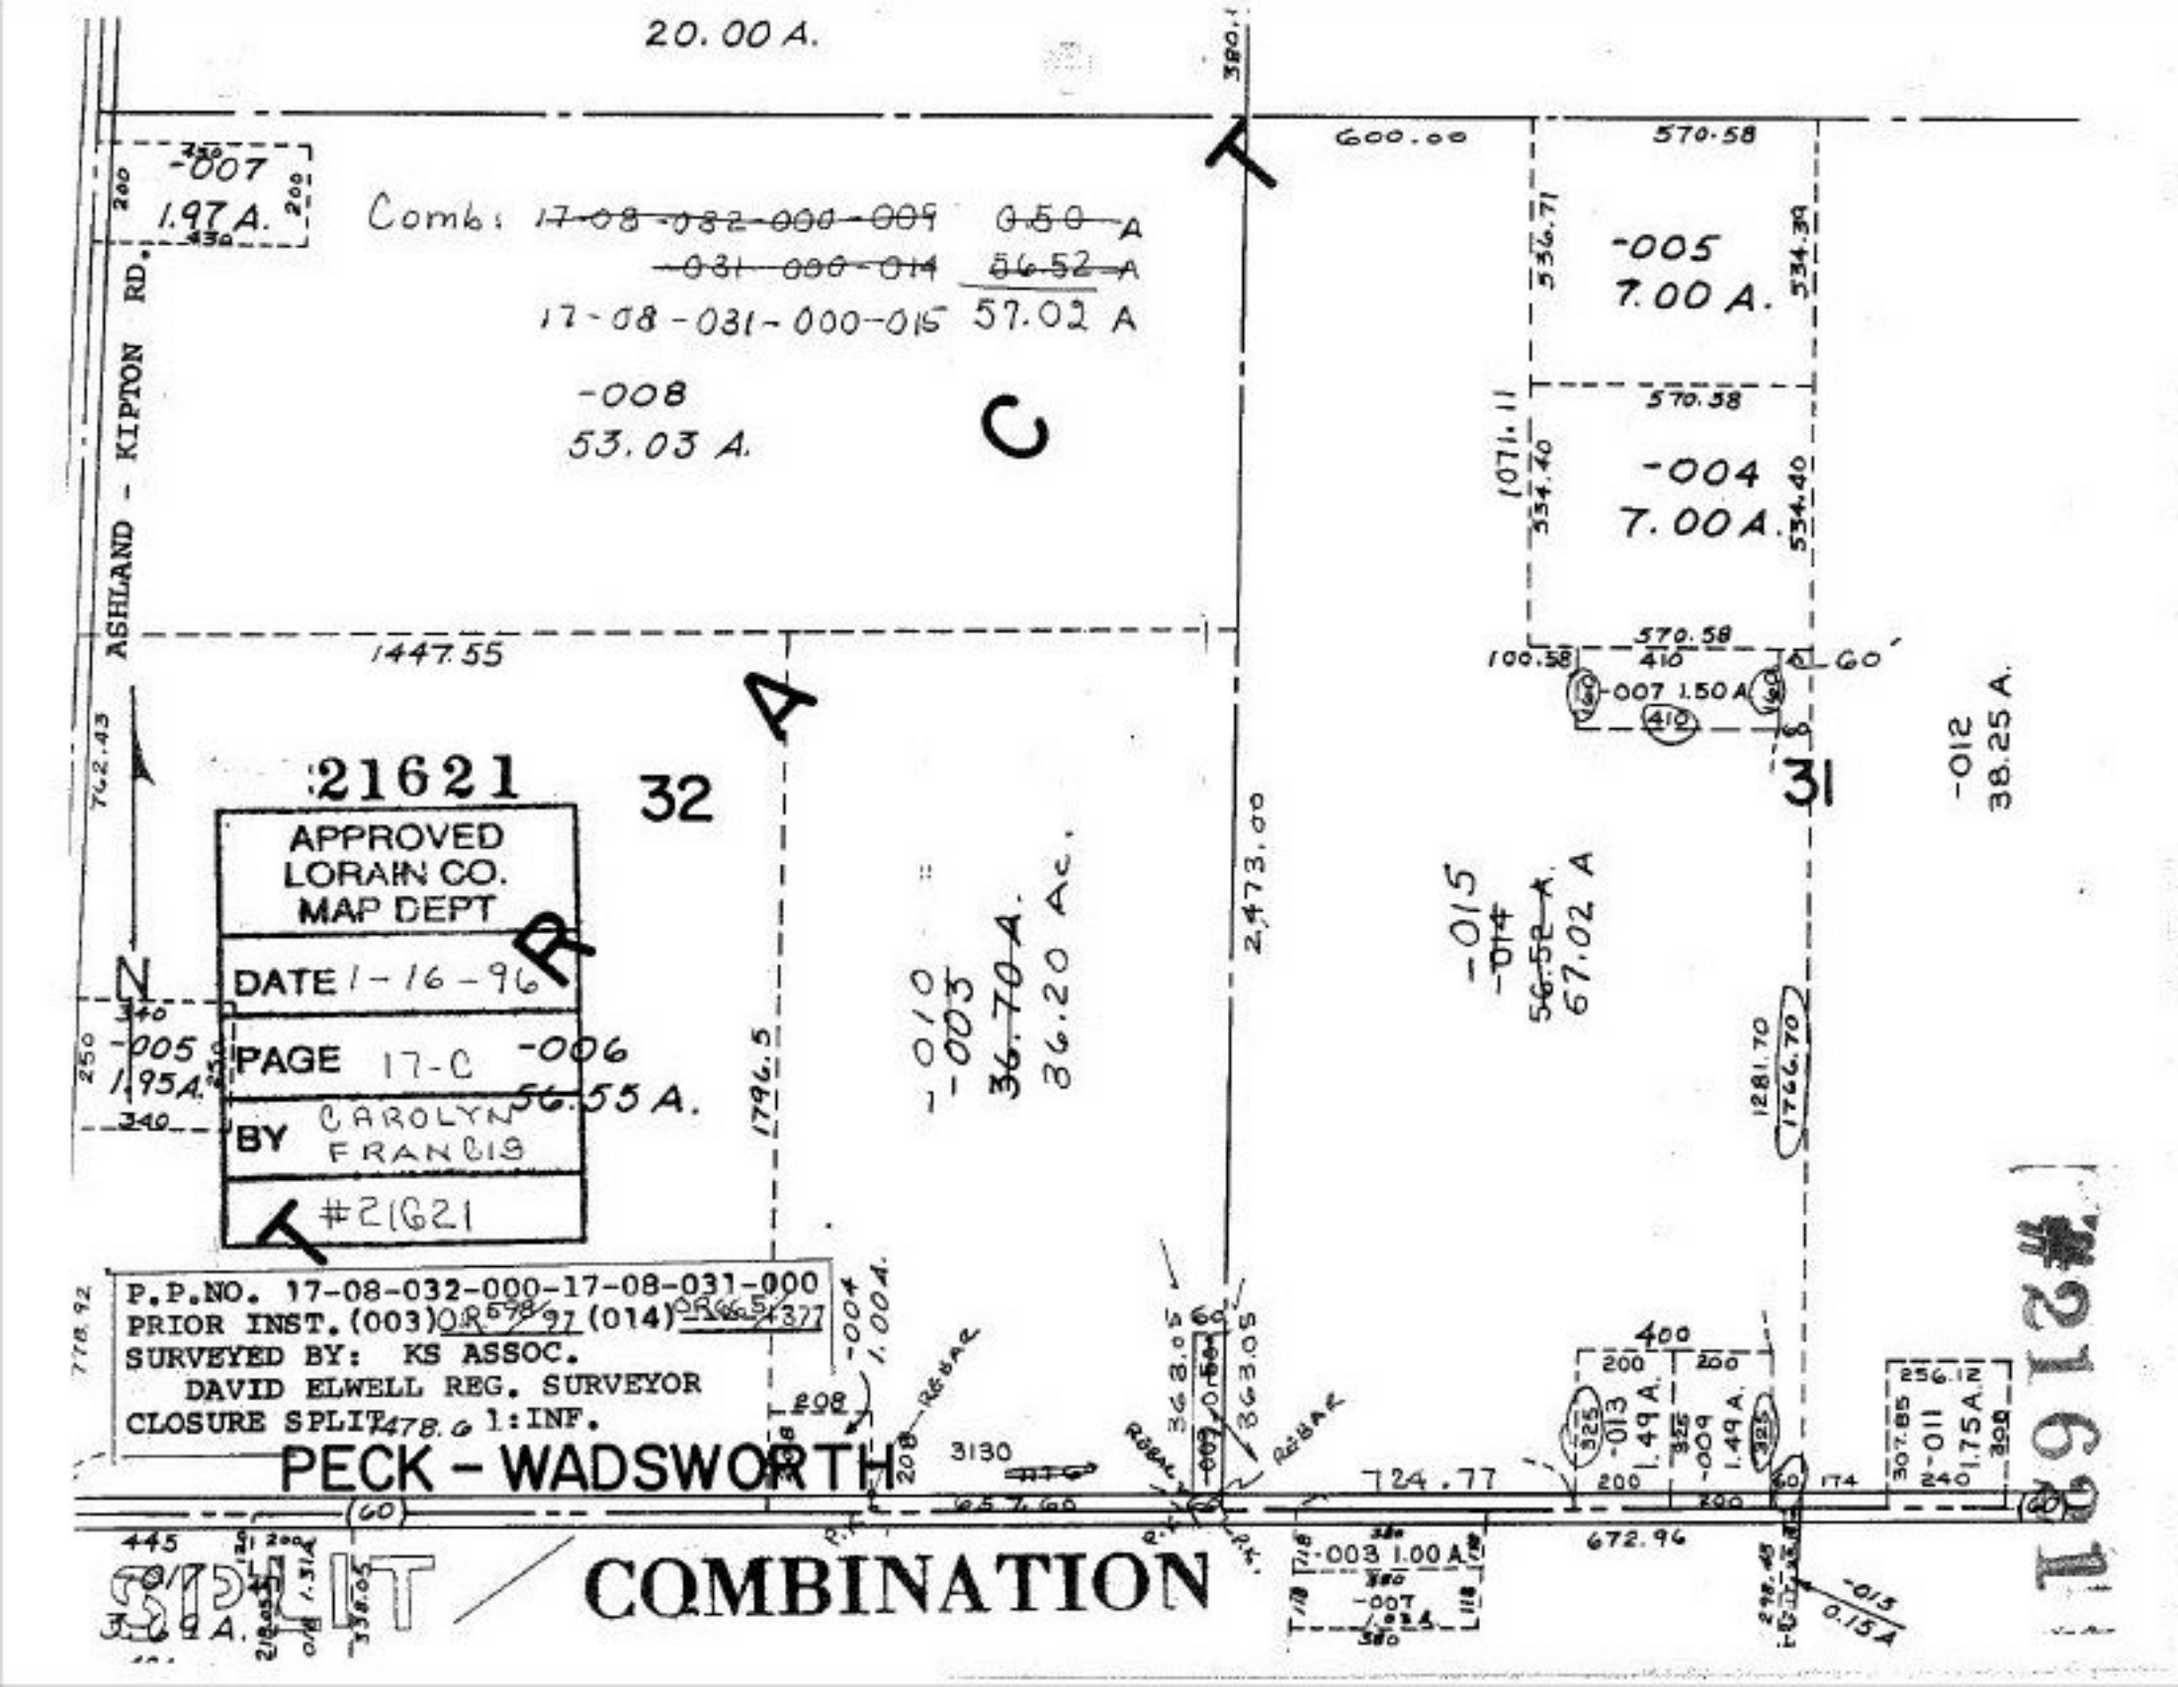
20.00 A.
-007
1.97 A.
Comb: ~~17-08-032-000-009~~ ~~0.50~~ A
~~-031-000-014~~ ~~56.52~~ A
17-08-031-000-015 57.02 A
-008
53.03 A.
C
ASHLAND - KIPTON RD.
600.00
570.58
-005
7.00 A.
-004
7.00 A.
1071.11
1447.55
A
21621
32
31
-012
38.25 A.
APPROVED
LORAIN CO.
MAP DEPT
DATE 1-16-96
PAGE 17-C
BY CAROLYN FRANCIS
#21621
-005
1.95 A.
-006
56.55 A.
-010
-003
~~36.70 A.~~
36.20 Ac.
2,473.00
-015
~~-014~~
~~56.52 A.~~
67.02 A
1796.5
1281.70
1766.70
P.P.NO. 17-08-032-000-17-08-031-000
PRIOR INST. (003) OR 598/97 (014) OR 665/377
SURVEYED BY: KS ASSOC.
DAVID ELWELL REG. SURVEYOR
CLOSURE SPLIT 478.6 1:INF.
PECK - WADSWORTH
3130
724.77
672.96
-003 1.00 A
-007
-015
0.15 A
-013
1.49 A.
-009
1.49 A.
-011
1.75 A.
-004
1.00 A.
SPLIT
COMBINATION
#21621