#21623

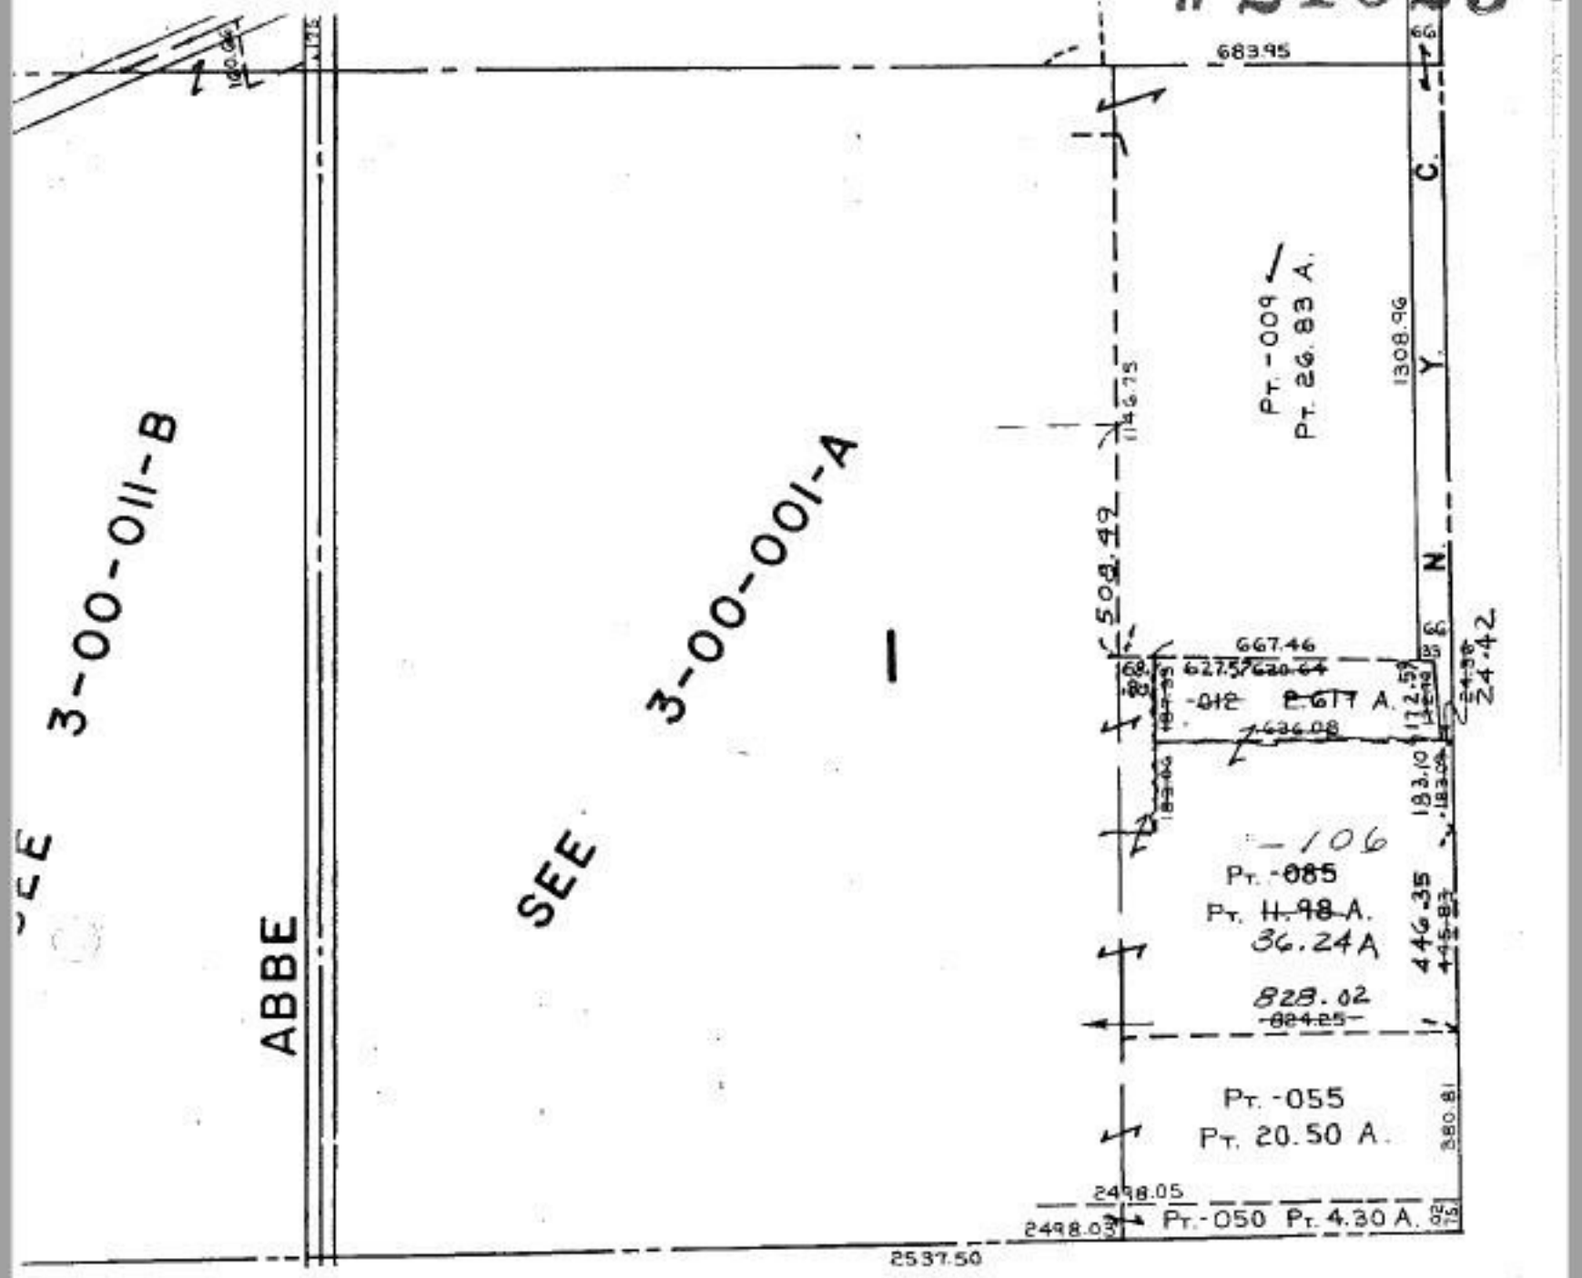

P.P.NO. 03-00-001-000
PRIOR INST: O.R. 293/865(099)
O.R.1204/279-282 (012,085,083
SURVEYED BY: DAVID ELWELL REG. S[illegible]

21623

APPROVED
LORAIN CO.
MAP DEPT

DATE 1-19-96

PAGE 3-L

BY CAROLYN FRANCIS

#21623

TWP.