#21628

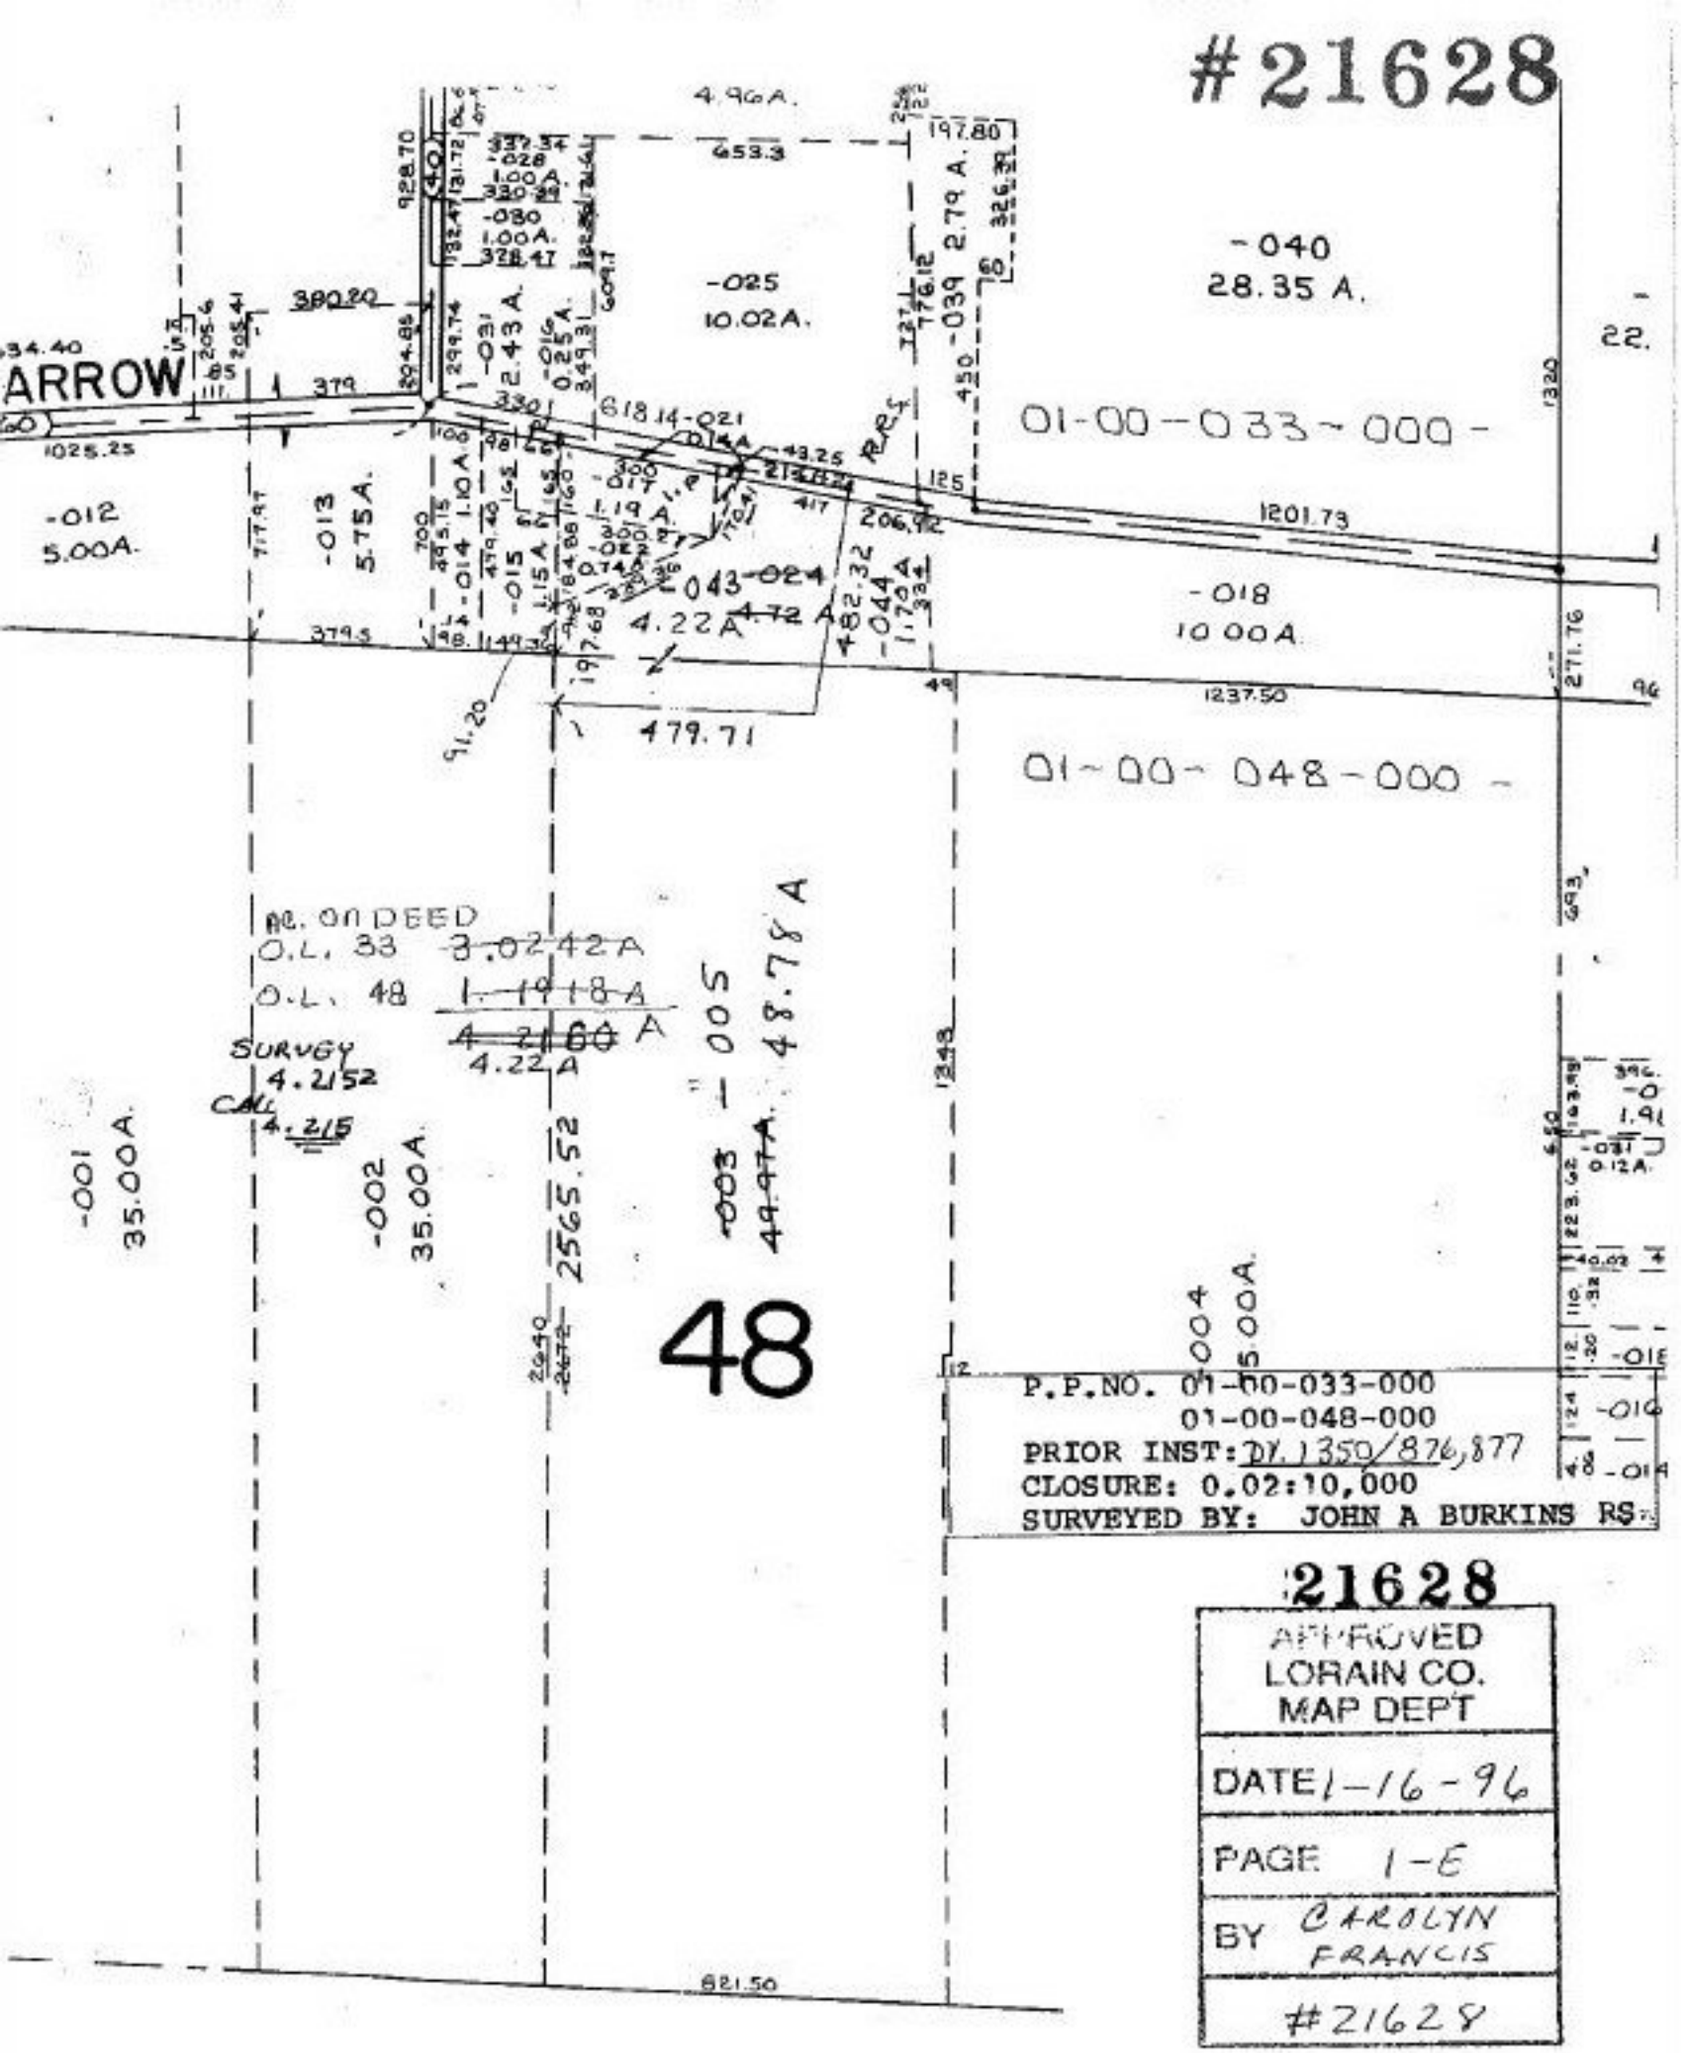

21628

APPROVED
LORAIN CO.
MAP DEPT

DATE 1-16-96

PAGE 1-E

BY CAROLYN FRANCIS

#21628