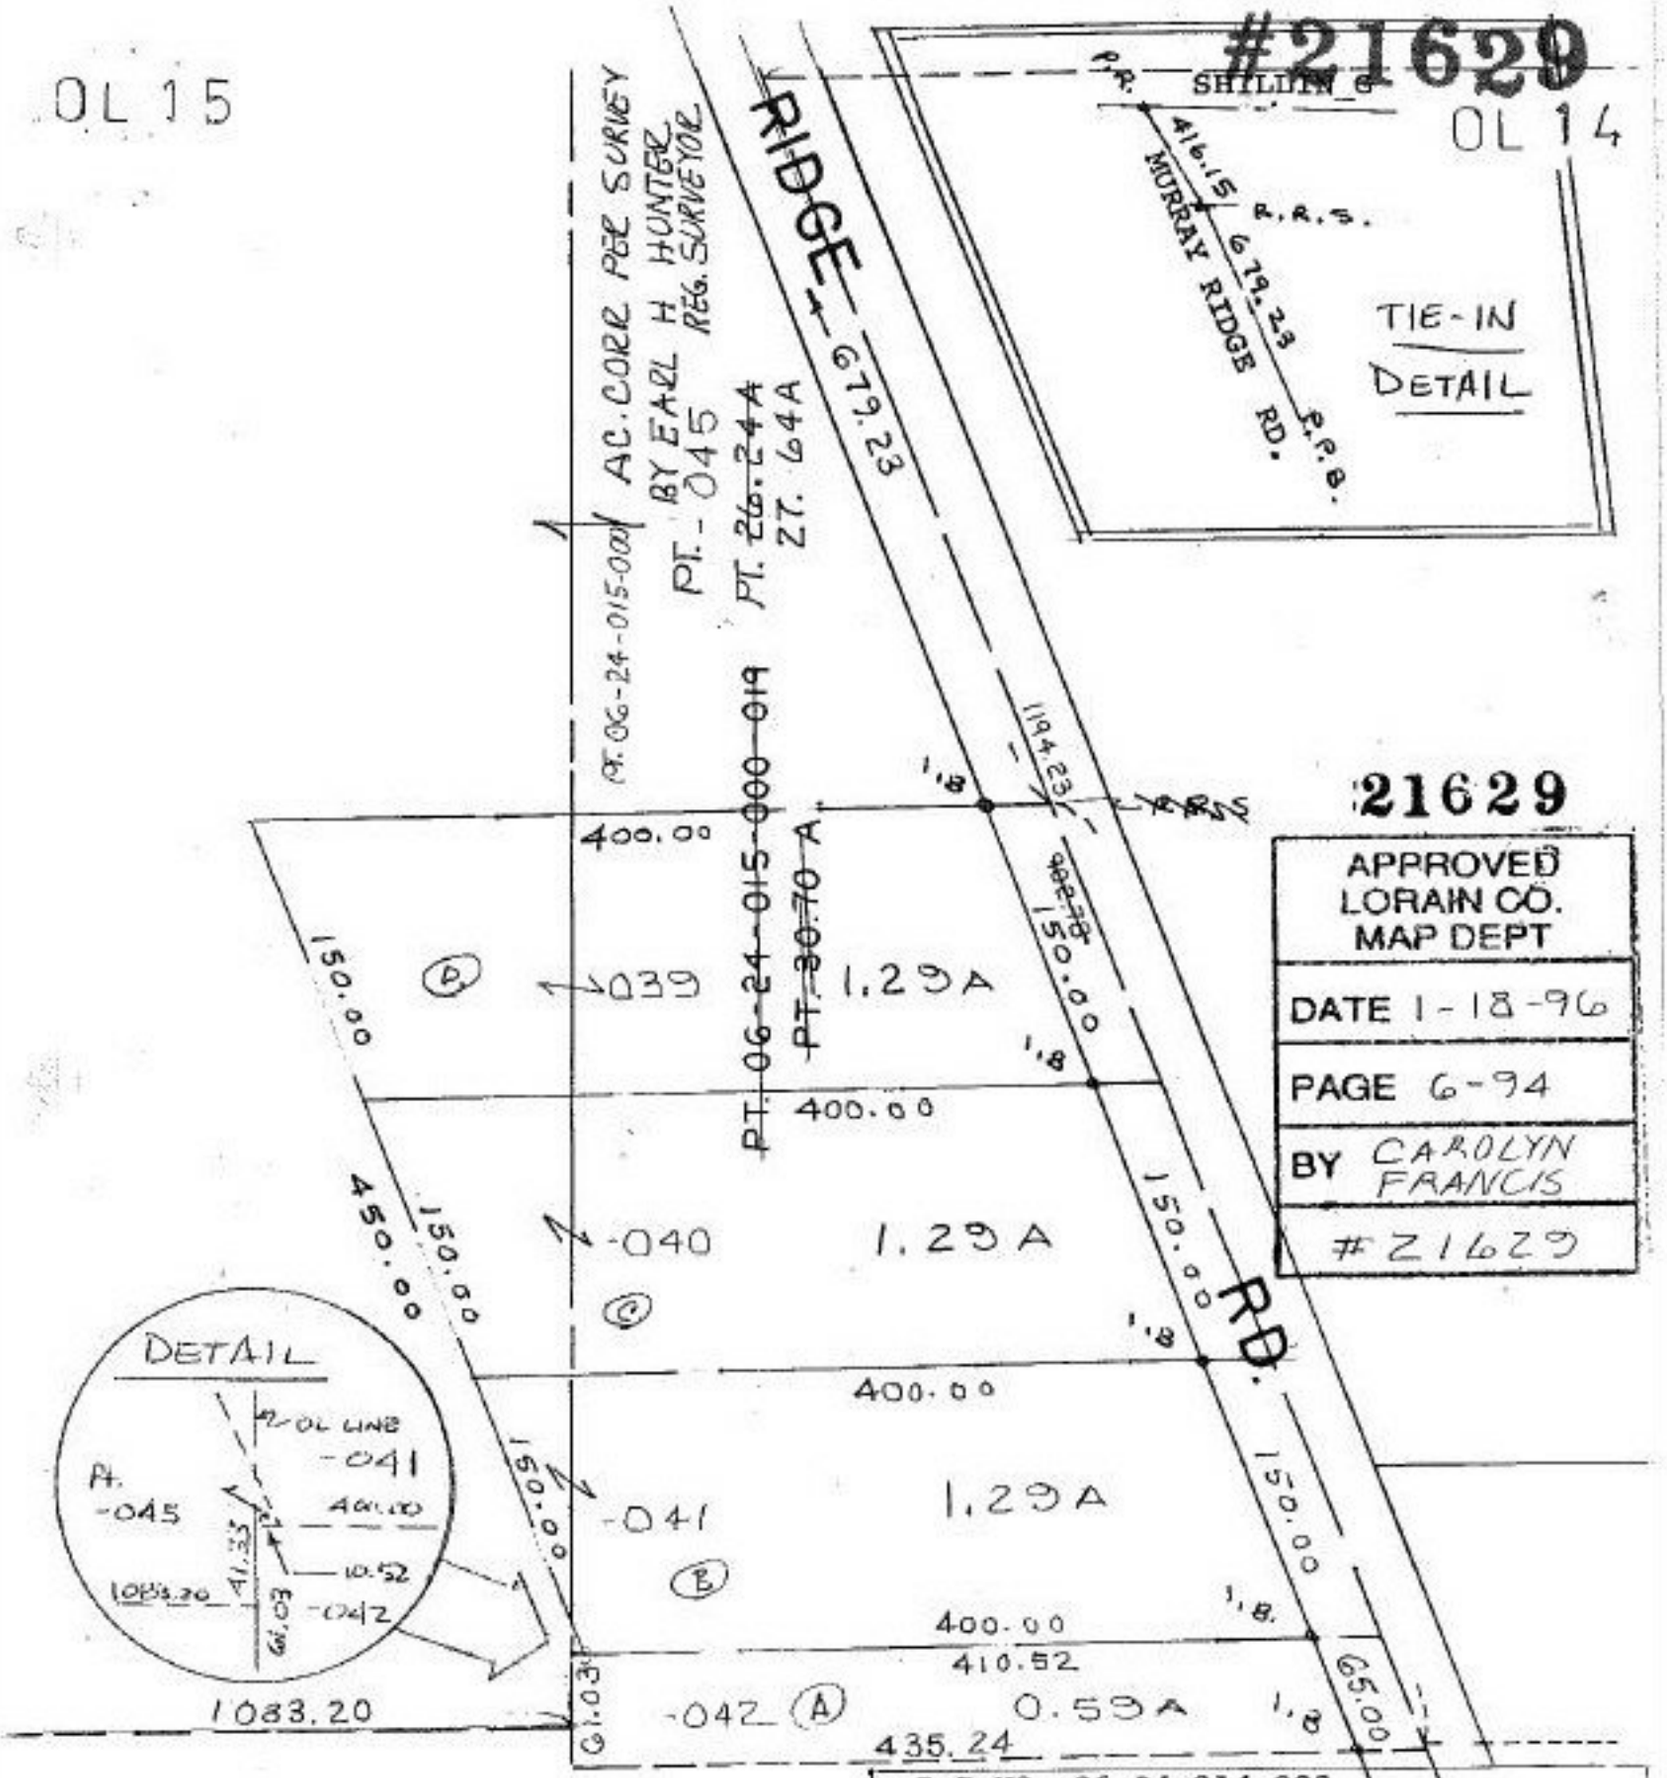

21629

APPROVED
LORAIN CO.
MAP DEPT

DATE 1-18-96

PAGE 6-94

BY CAROLYN FRANCIS

#21629

P.P.NO. 06-24-014-000
06-24-015-000
PRIOR INST: OR 1115/534
CLOSURE: 1,2,3, 1:INF(4)0.03:10,000
(5)0.10;10,000 REM.
SURVEYED BY: EARL HUNTER R.S.