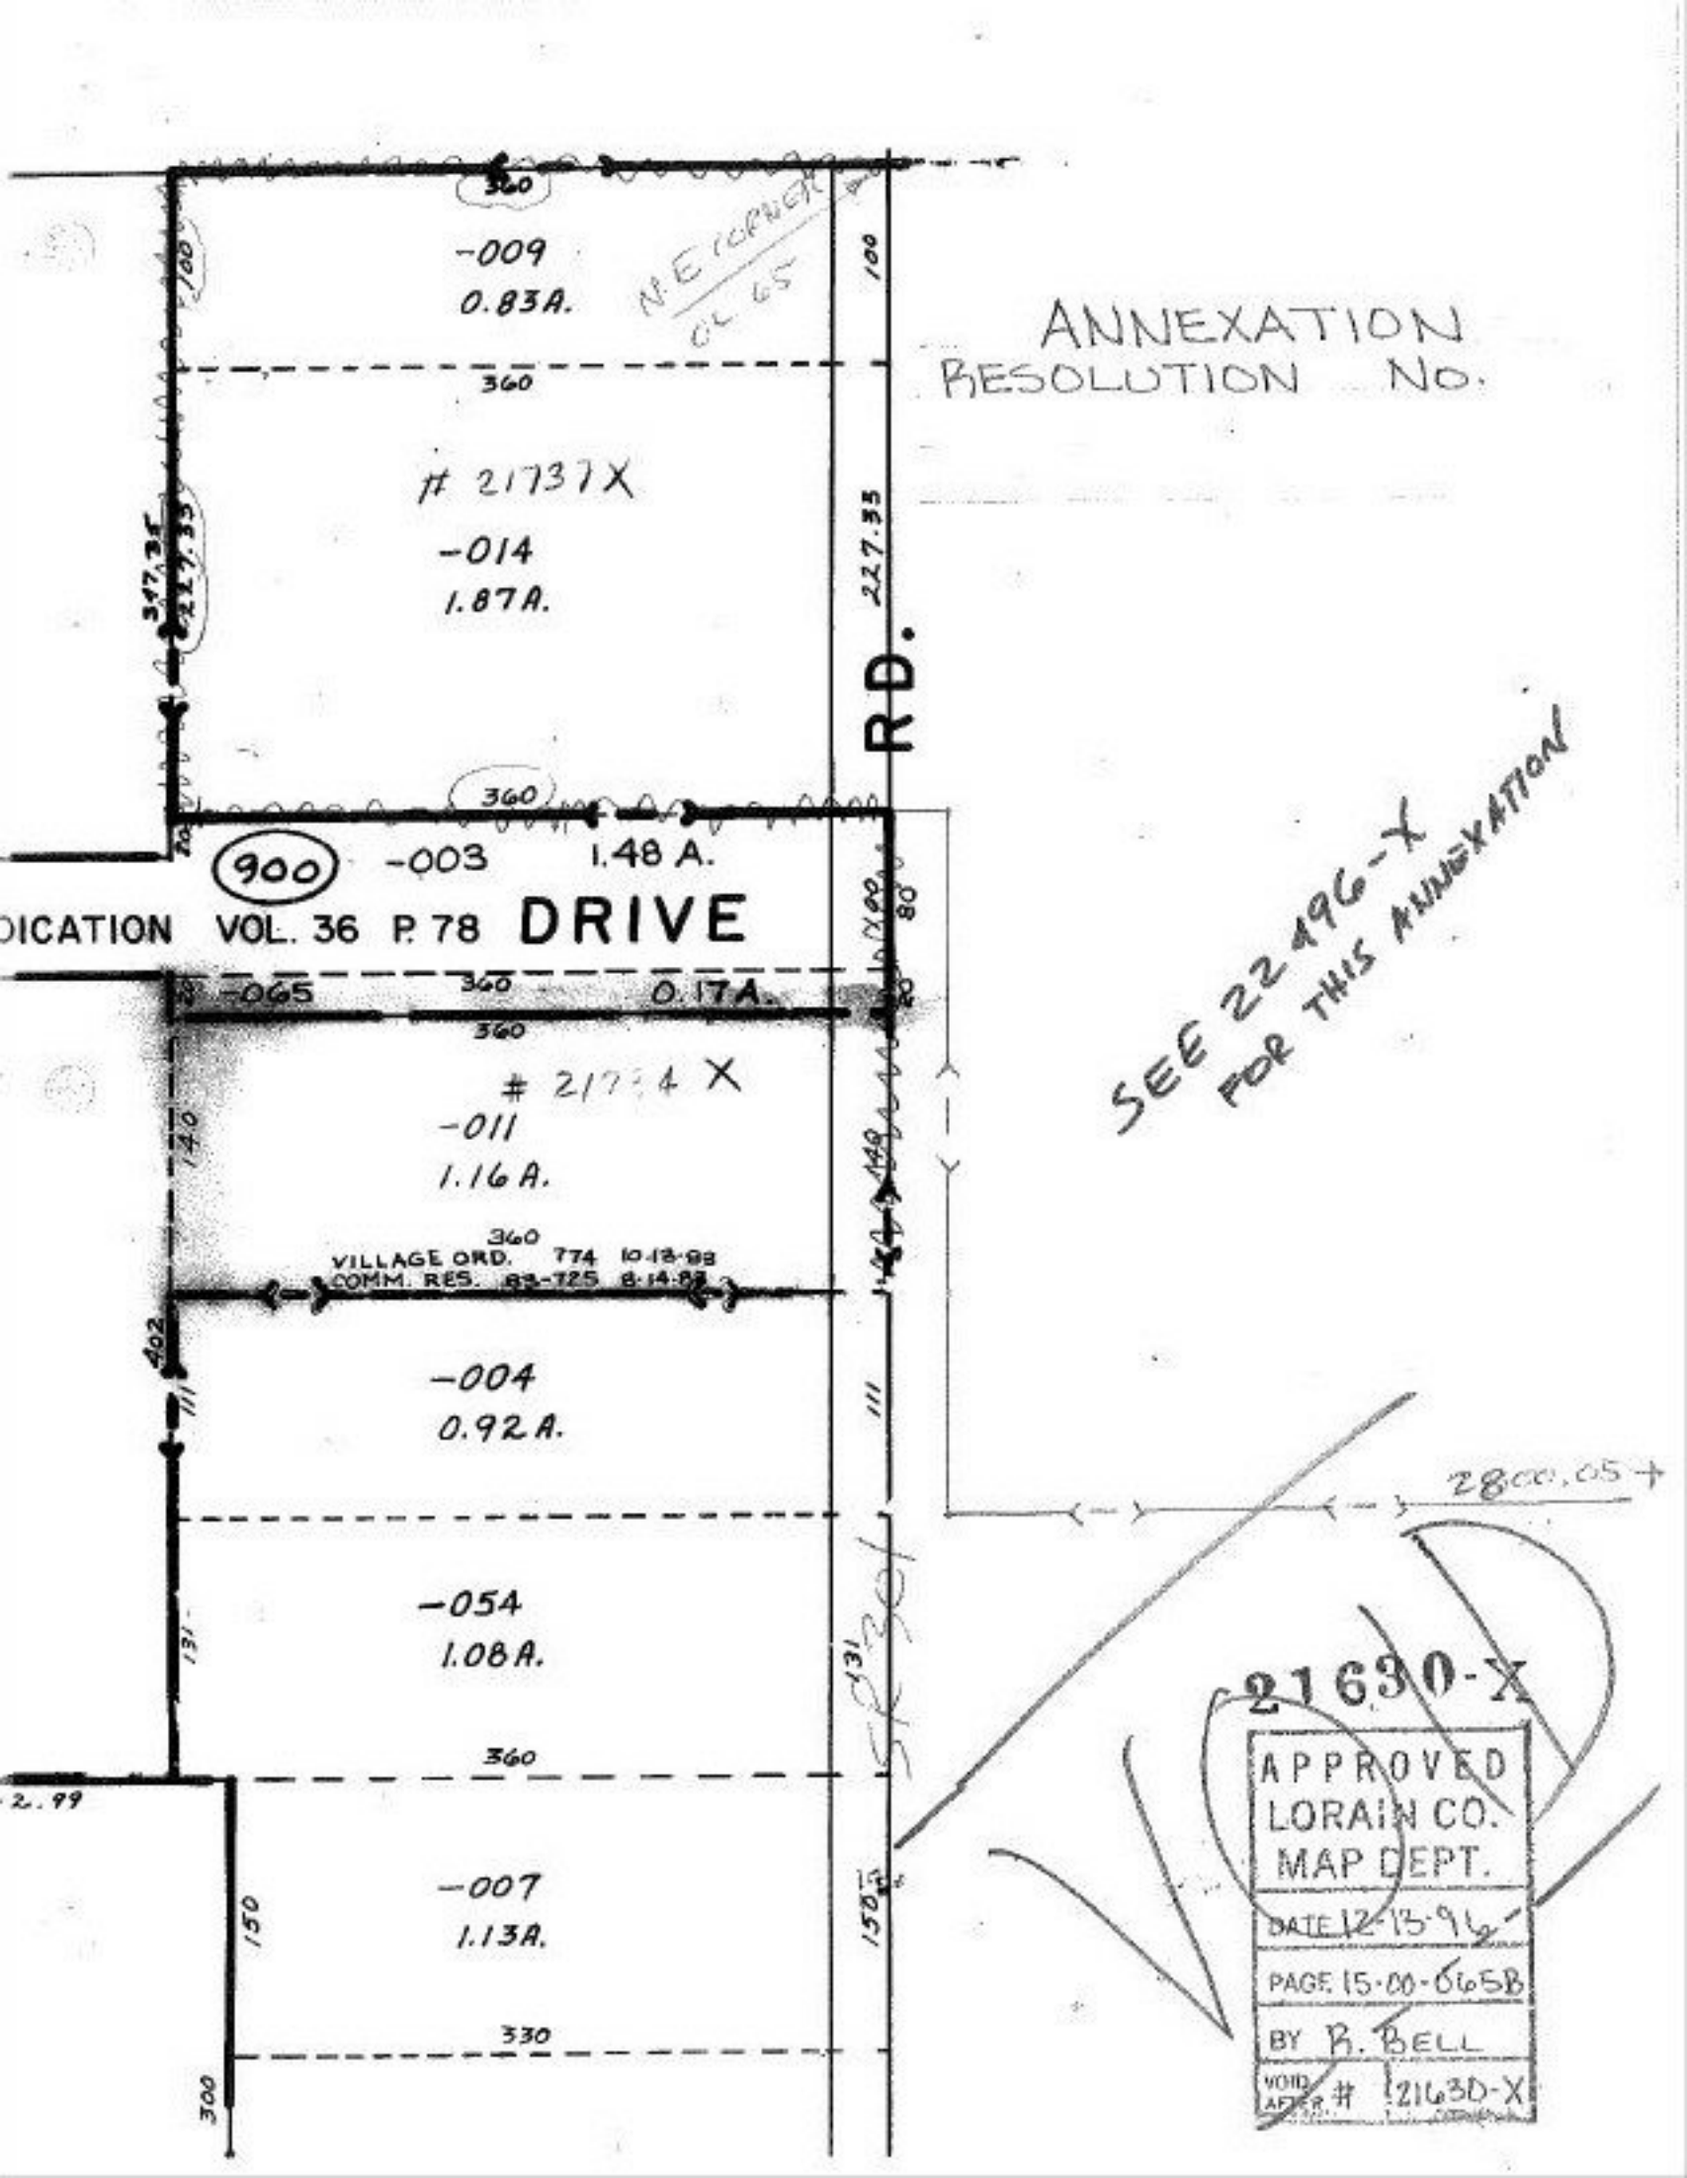
ANNEXATION
RESOLUTION No.
-009
0.83A.
21737X
-014
1.87A.
RD.
900
-003
1.48 A.
DRIVE
VOL. 36 P. 78
-065
0.17A.
21734 X
-011
1.16 A.
VILLAGE ORD. 774 10-13-98
COMM. RES. 83-725 8-14-98
-004
0.92A.
-054
1.08A.
-007
1.13A.
SEE 22496-X
FOR THIS ANNEXATION
2800.05+
21630-X
APPROVED
LORAIN CO.
MAP DEPT.
DATE 12-13-96
PAGE 15-00-665B
BY B. BELL
VOID AFTER # 21630-X