#21630

SEE

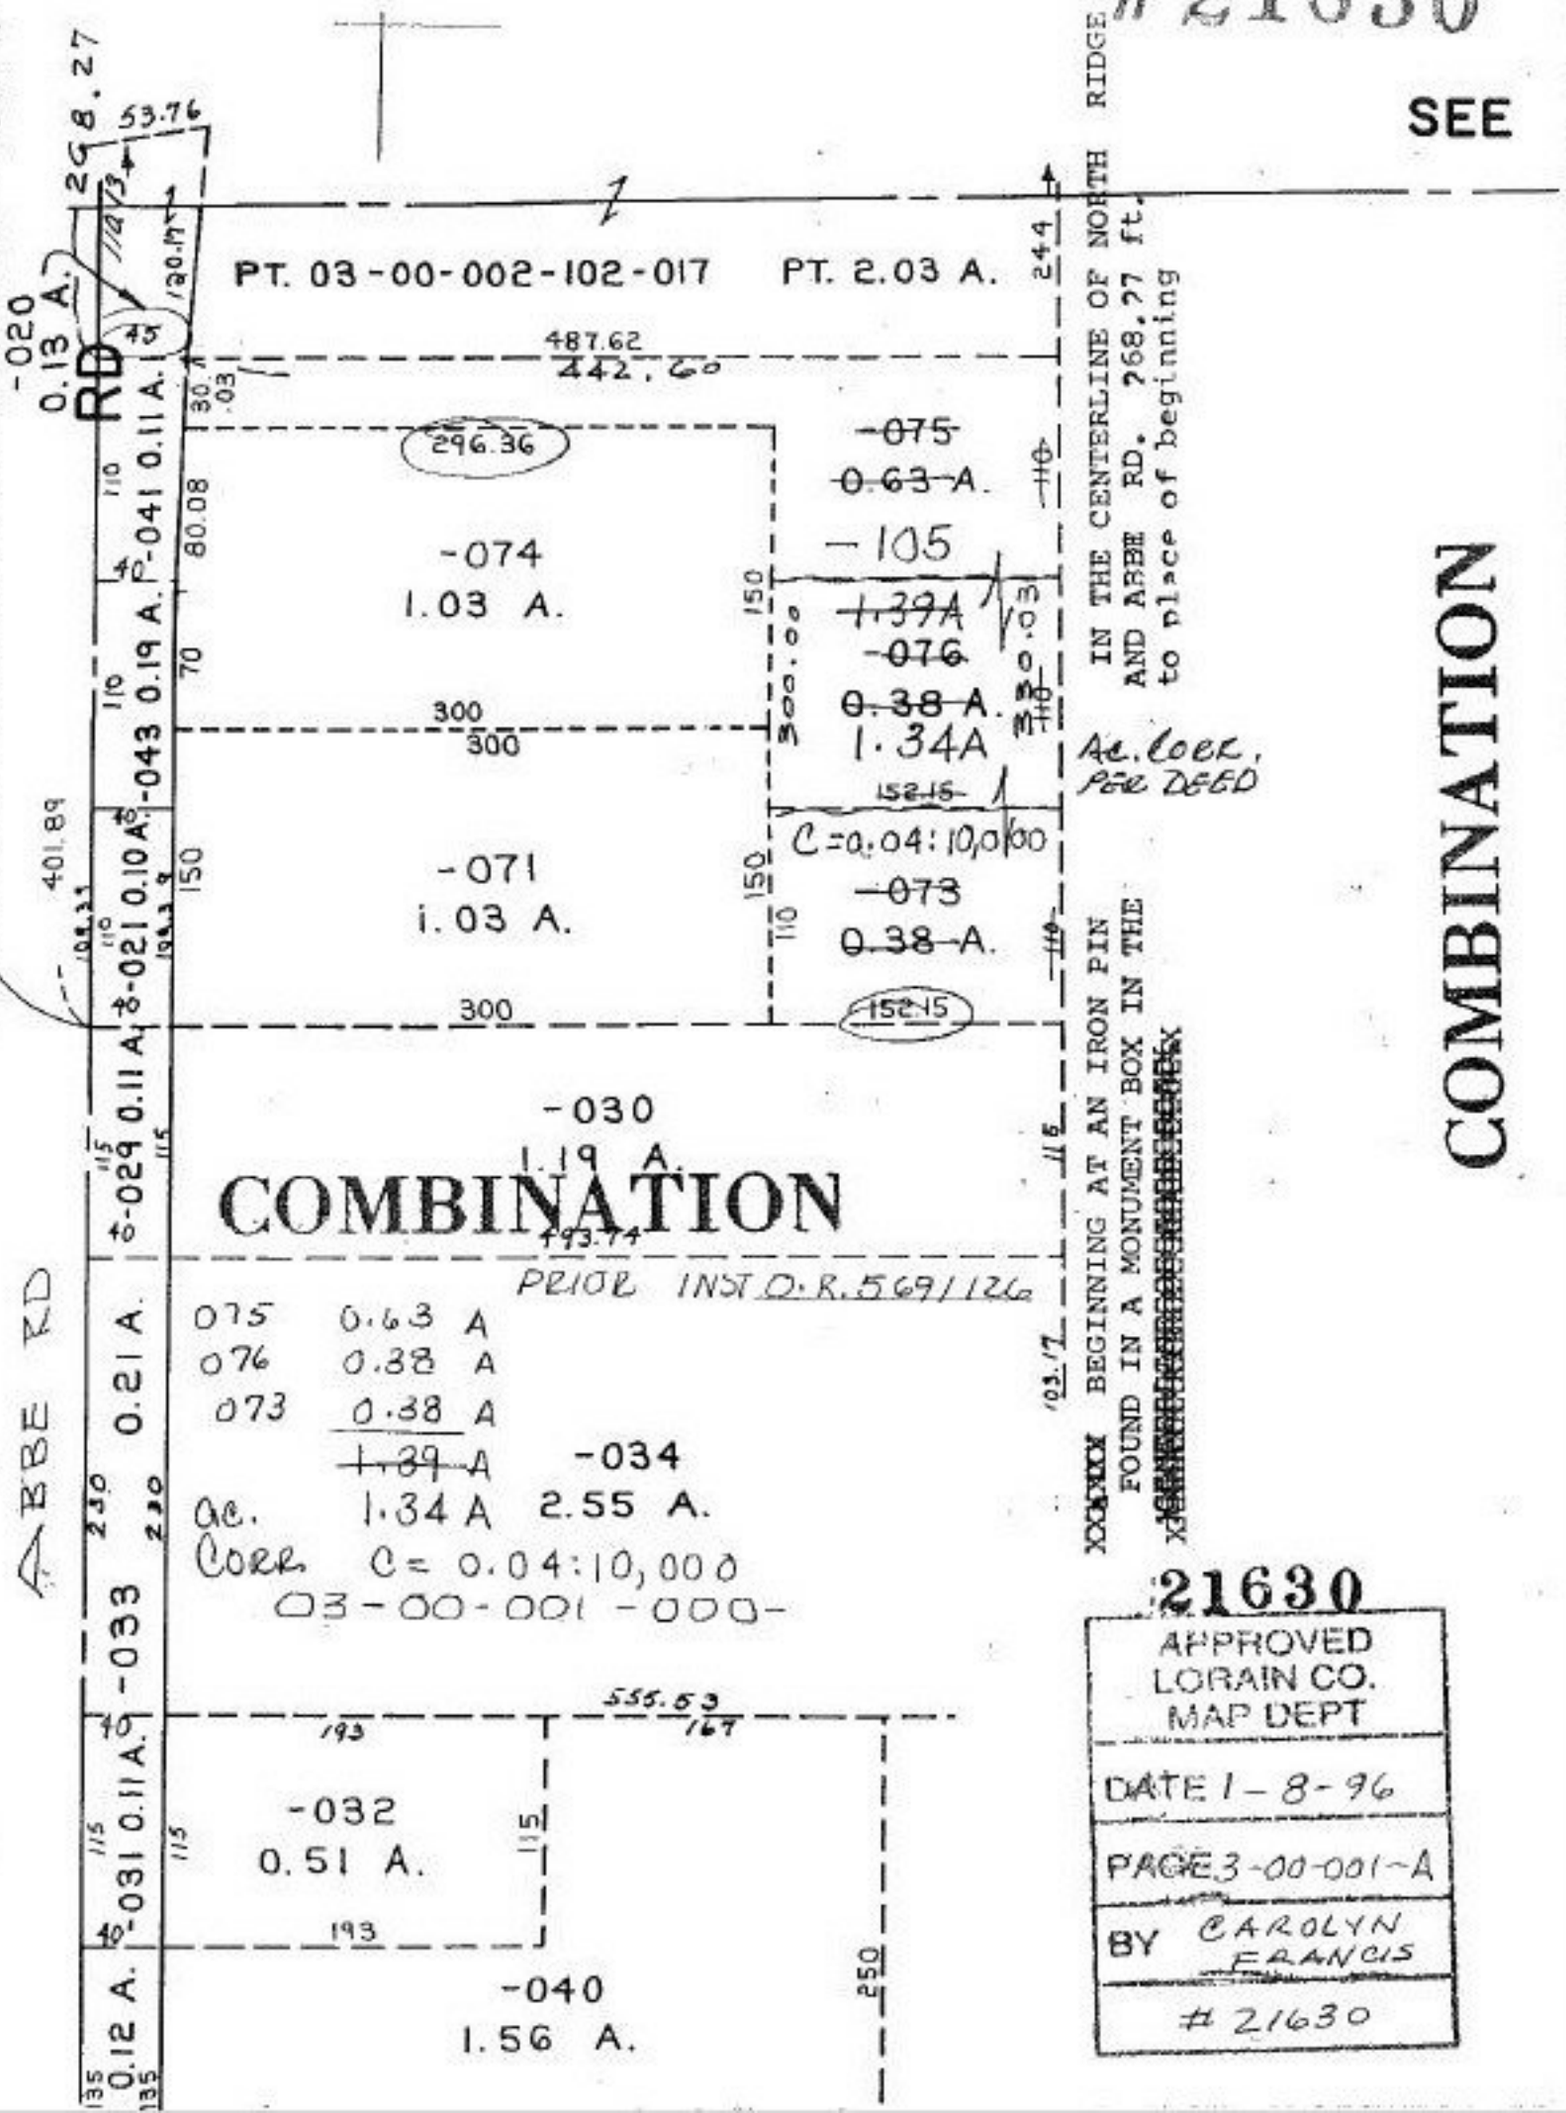

21630

APPROVED LORAIN CO. MAP DEPT
DATE 1-8-96
PAGE 3-00-001-A
BY CAROLYN FRANCIS
#21630