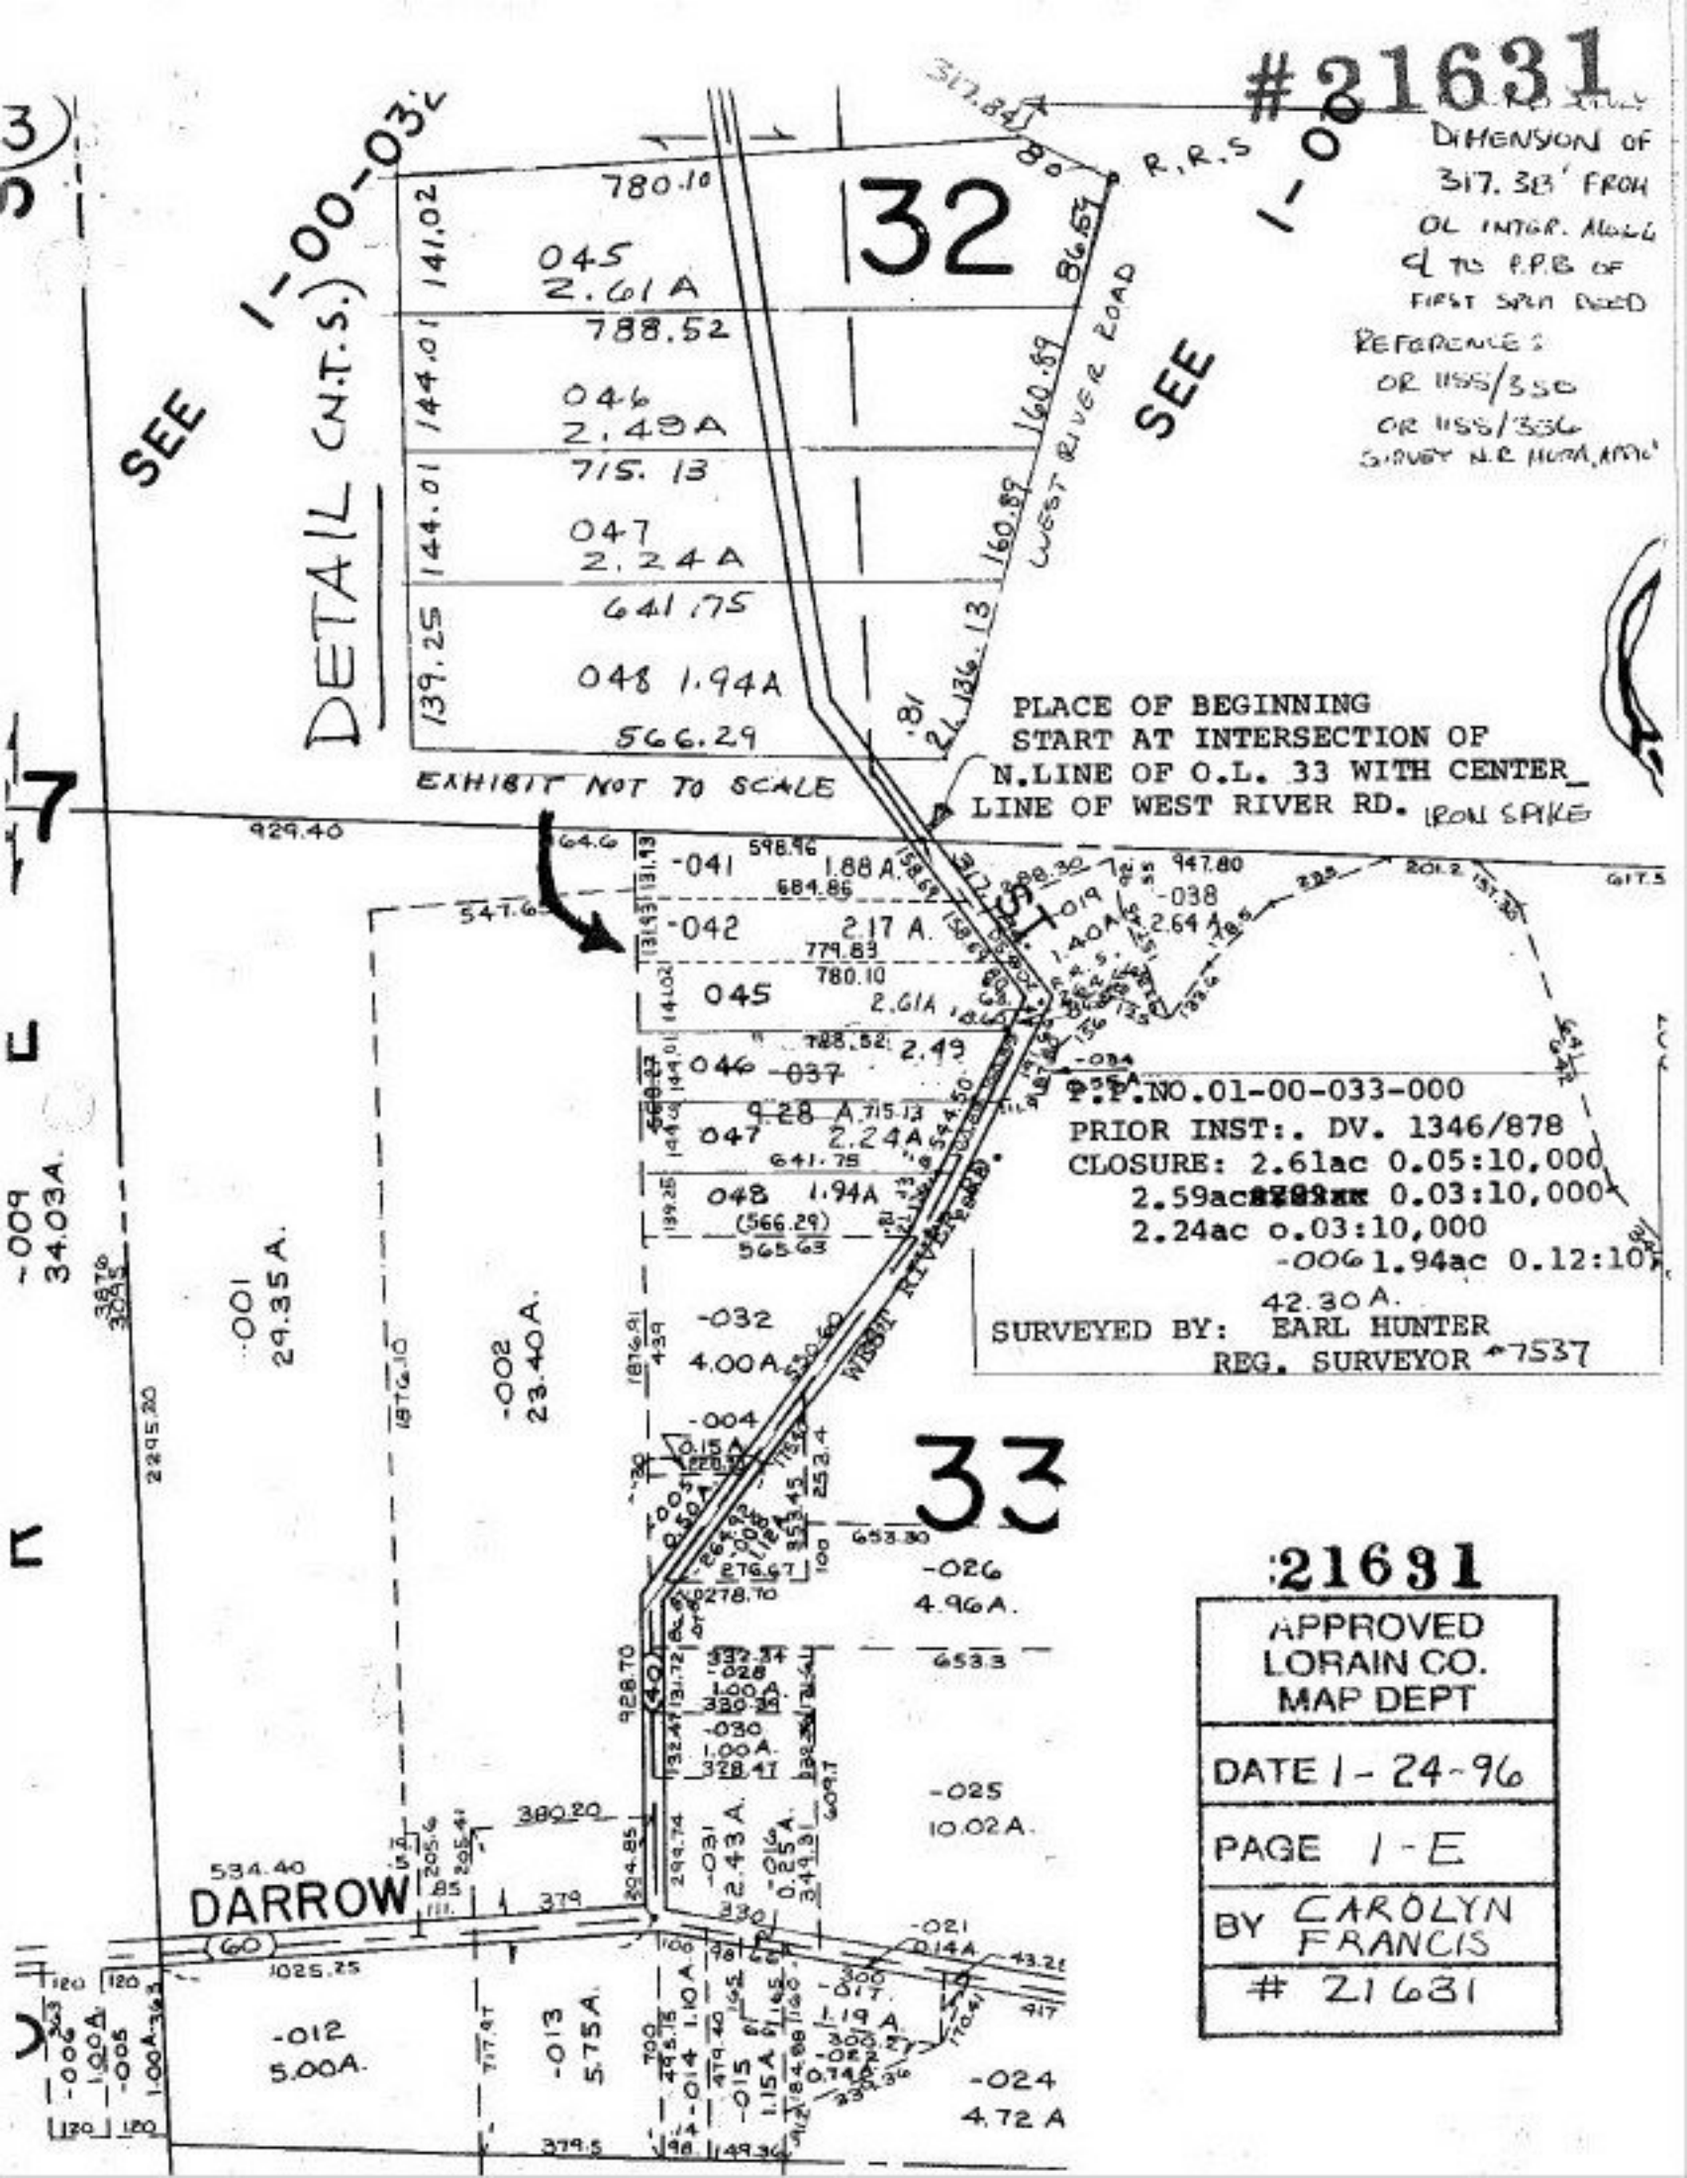
#21631
DIMENSION OF 317.33' FROM OL INTER. ALONG & TO P.P.B. OF FIRST SRVY DEED
REFERENCE: OR 1155/350 OR 1155/356 SURVEY N.E. HUNTER
DETAIL (N.T.S.)
SEE 1-00-03
SEE 1-00
PLACE OF BEGINNING START AT INTERSECTION OF N.LINE OF O.L. 33 WITH CENTER LINE OF WEST RIVER RD. IRON SPIKE
EXHIBIT NOT TO SCALE
P.P.NO.01-00-033-000
PRIOR INST:. DV. 1346/878
CLOSURE: 2.61ac 0.05:10,000
2.59ac 0.03:10,000
2.24ac 0.03:10,000
-006 1.94ac 0.12:10,000
42.30 A.
SURVEYED BY: EARL HUNTER
REG. SURVEYOR #7537
32
33
DARROW
WEST RIVER ROAD
:21631
APPROVED LORAIN CO. MAP DEPT
DATE 1-24-96
PAGE 1-E
BY CAROLYN FRANCIS
# 21631