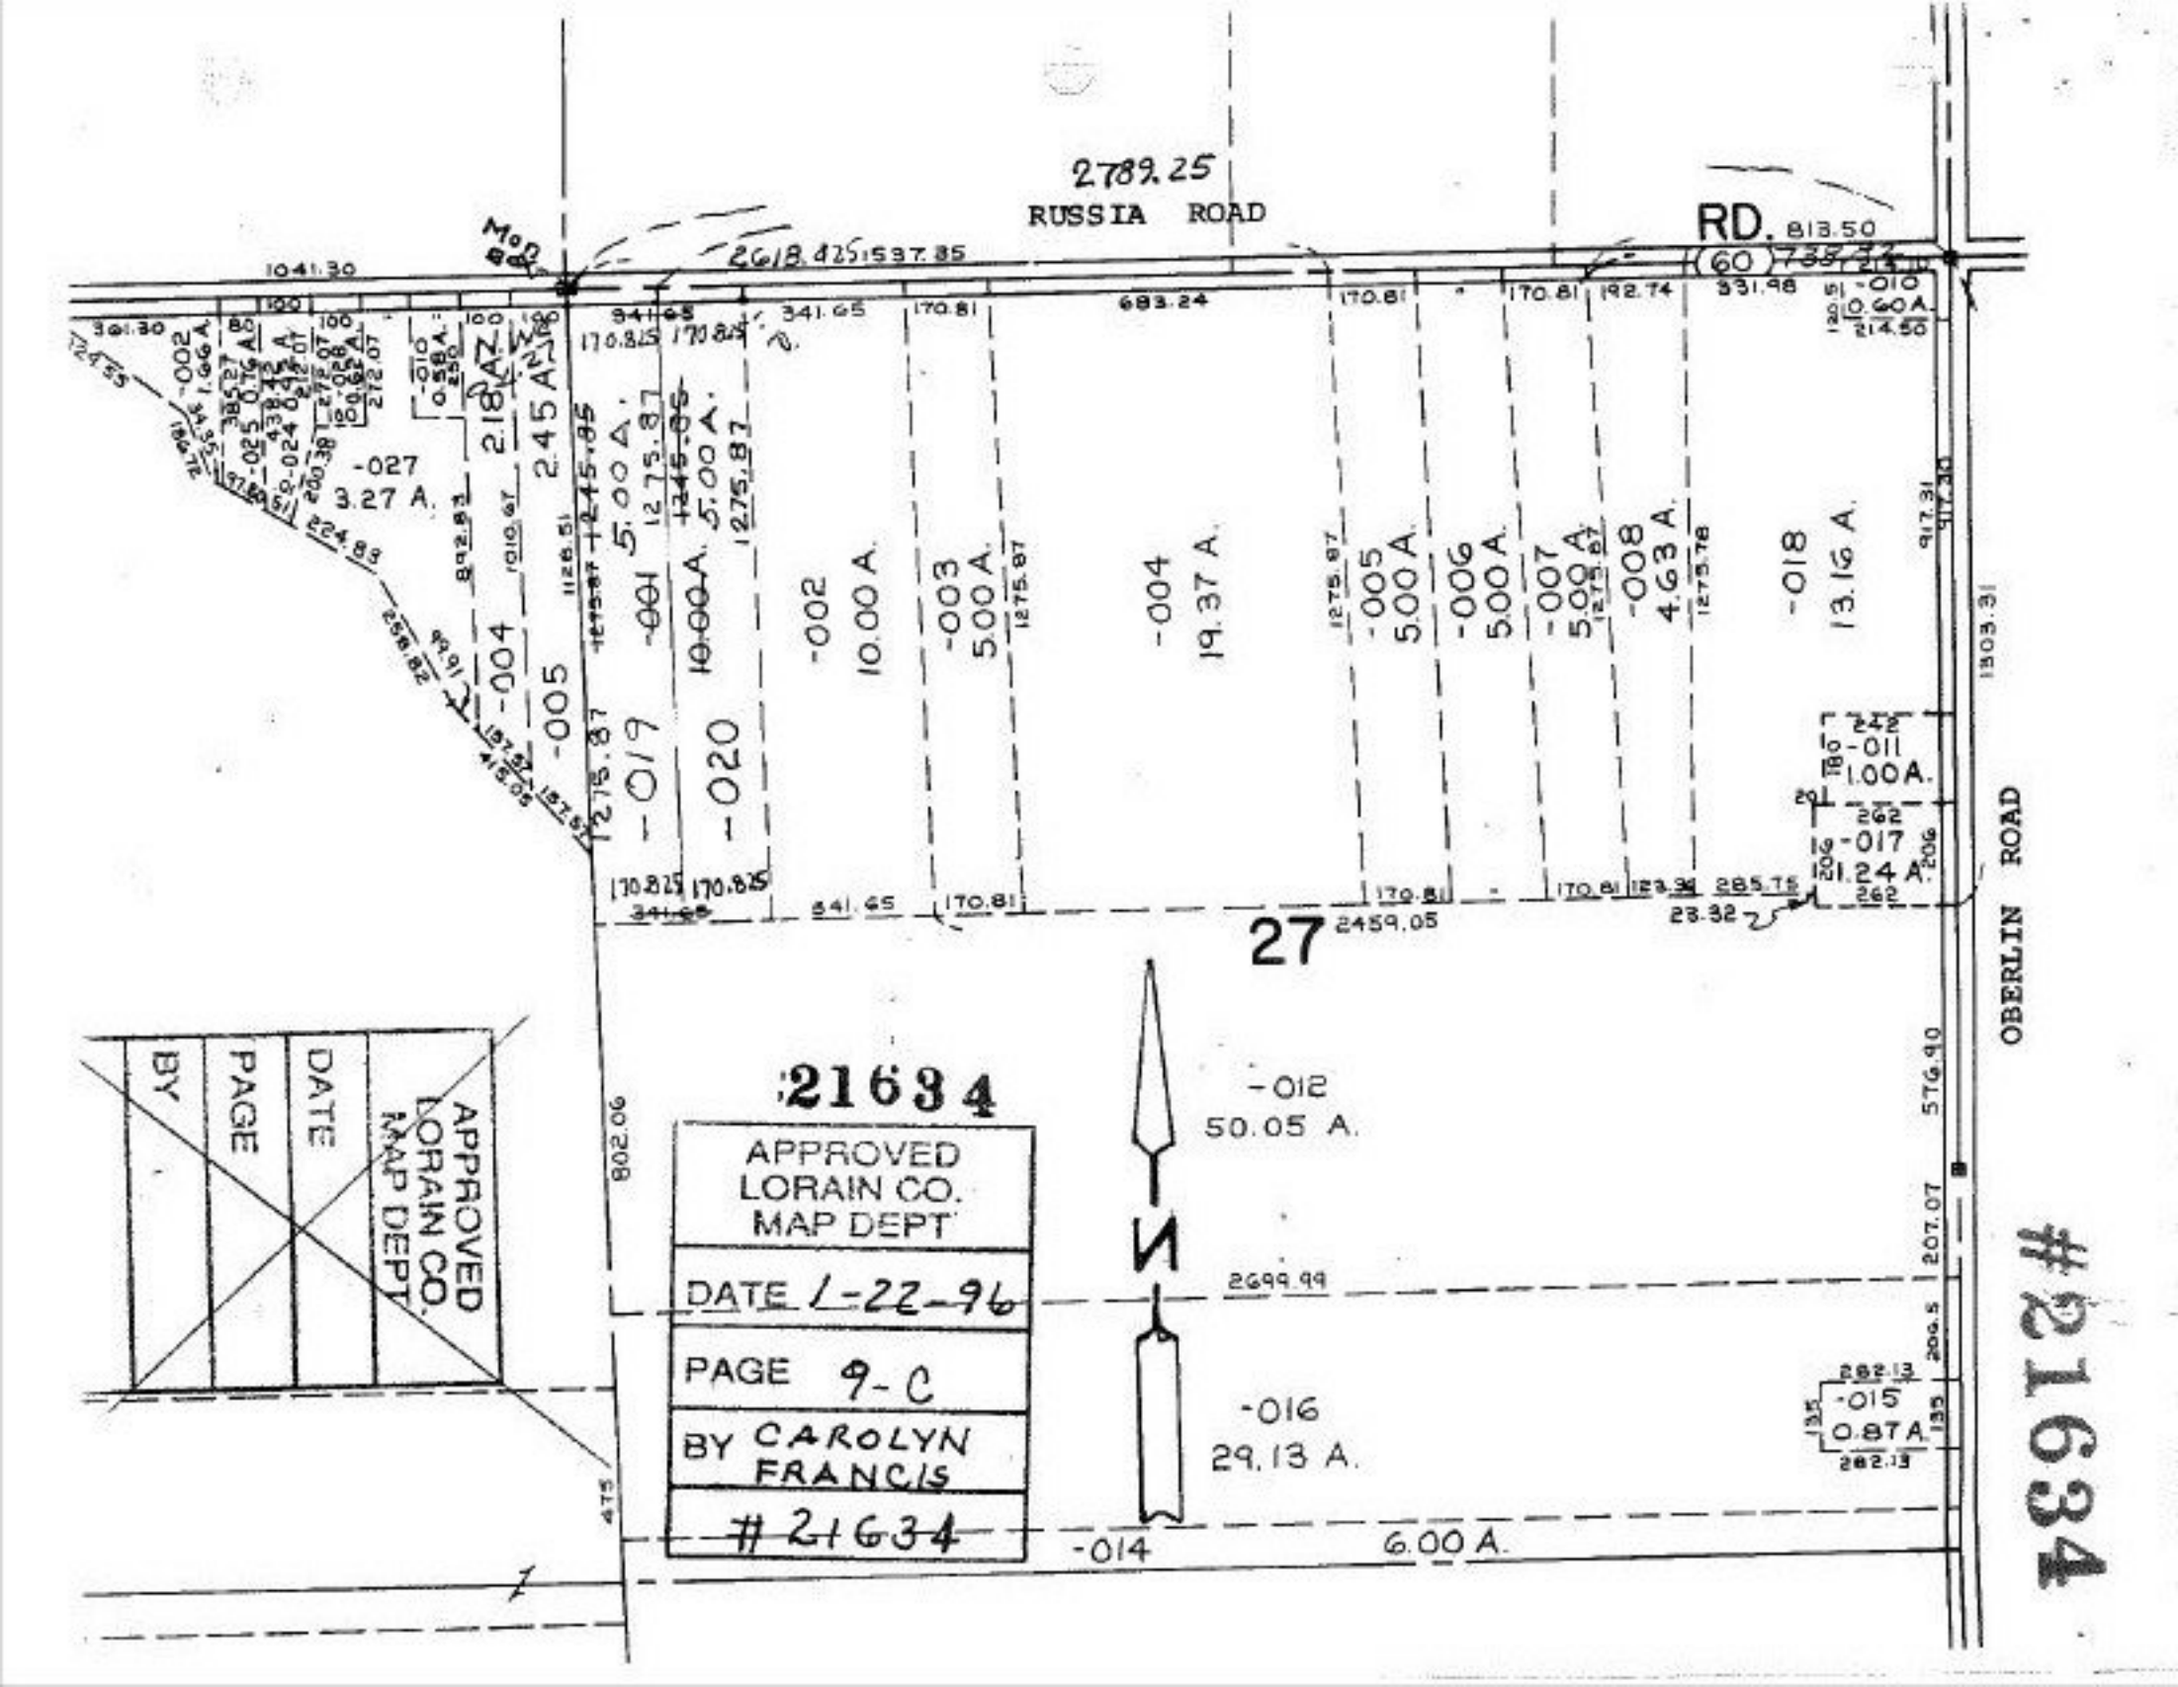
2789.25
RUSSIA ROAD
RD.
813.50
2618.42
5397.85
1041.30
-027
3.27 A.
-004
-005
-019
-020
-002
10.00 A.
-003
5.00 A.
-004
19.37 A.
-005
5.00 A.
-006
5.00 A.
-007
5.00 A.
-008
4.63 A.
-018
13.16 A.
-010
0.60 A.
-011
1.00 A.
-017
21.24 A.
-012
50.05 A.
-016
29.13 A.
-015
0.87 A.
-014
6.00 A.
OBERLIN ROAD
27
2459.05
2699.99
1503.31
917.31
576.90
207.07
802.06
475
APPROVED
LORAIN CO.
MAP DEPT
DATE 1-22-96
PAGE 9-C
BY CAROLYN
FRANCIS
#21634
21634
#21634
APPROVED
LORAIN CO.
MAP DEPT.
DATE
PAGE
BY