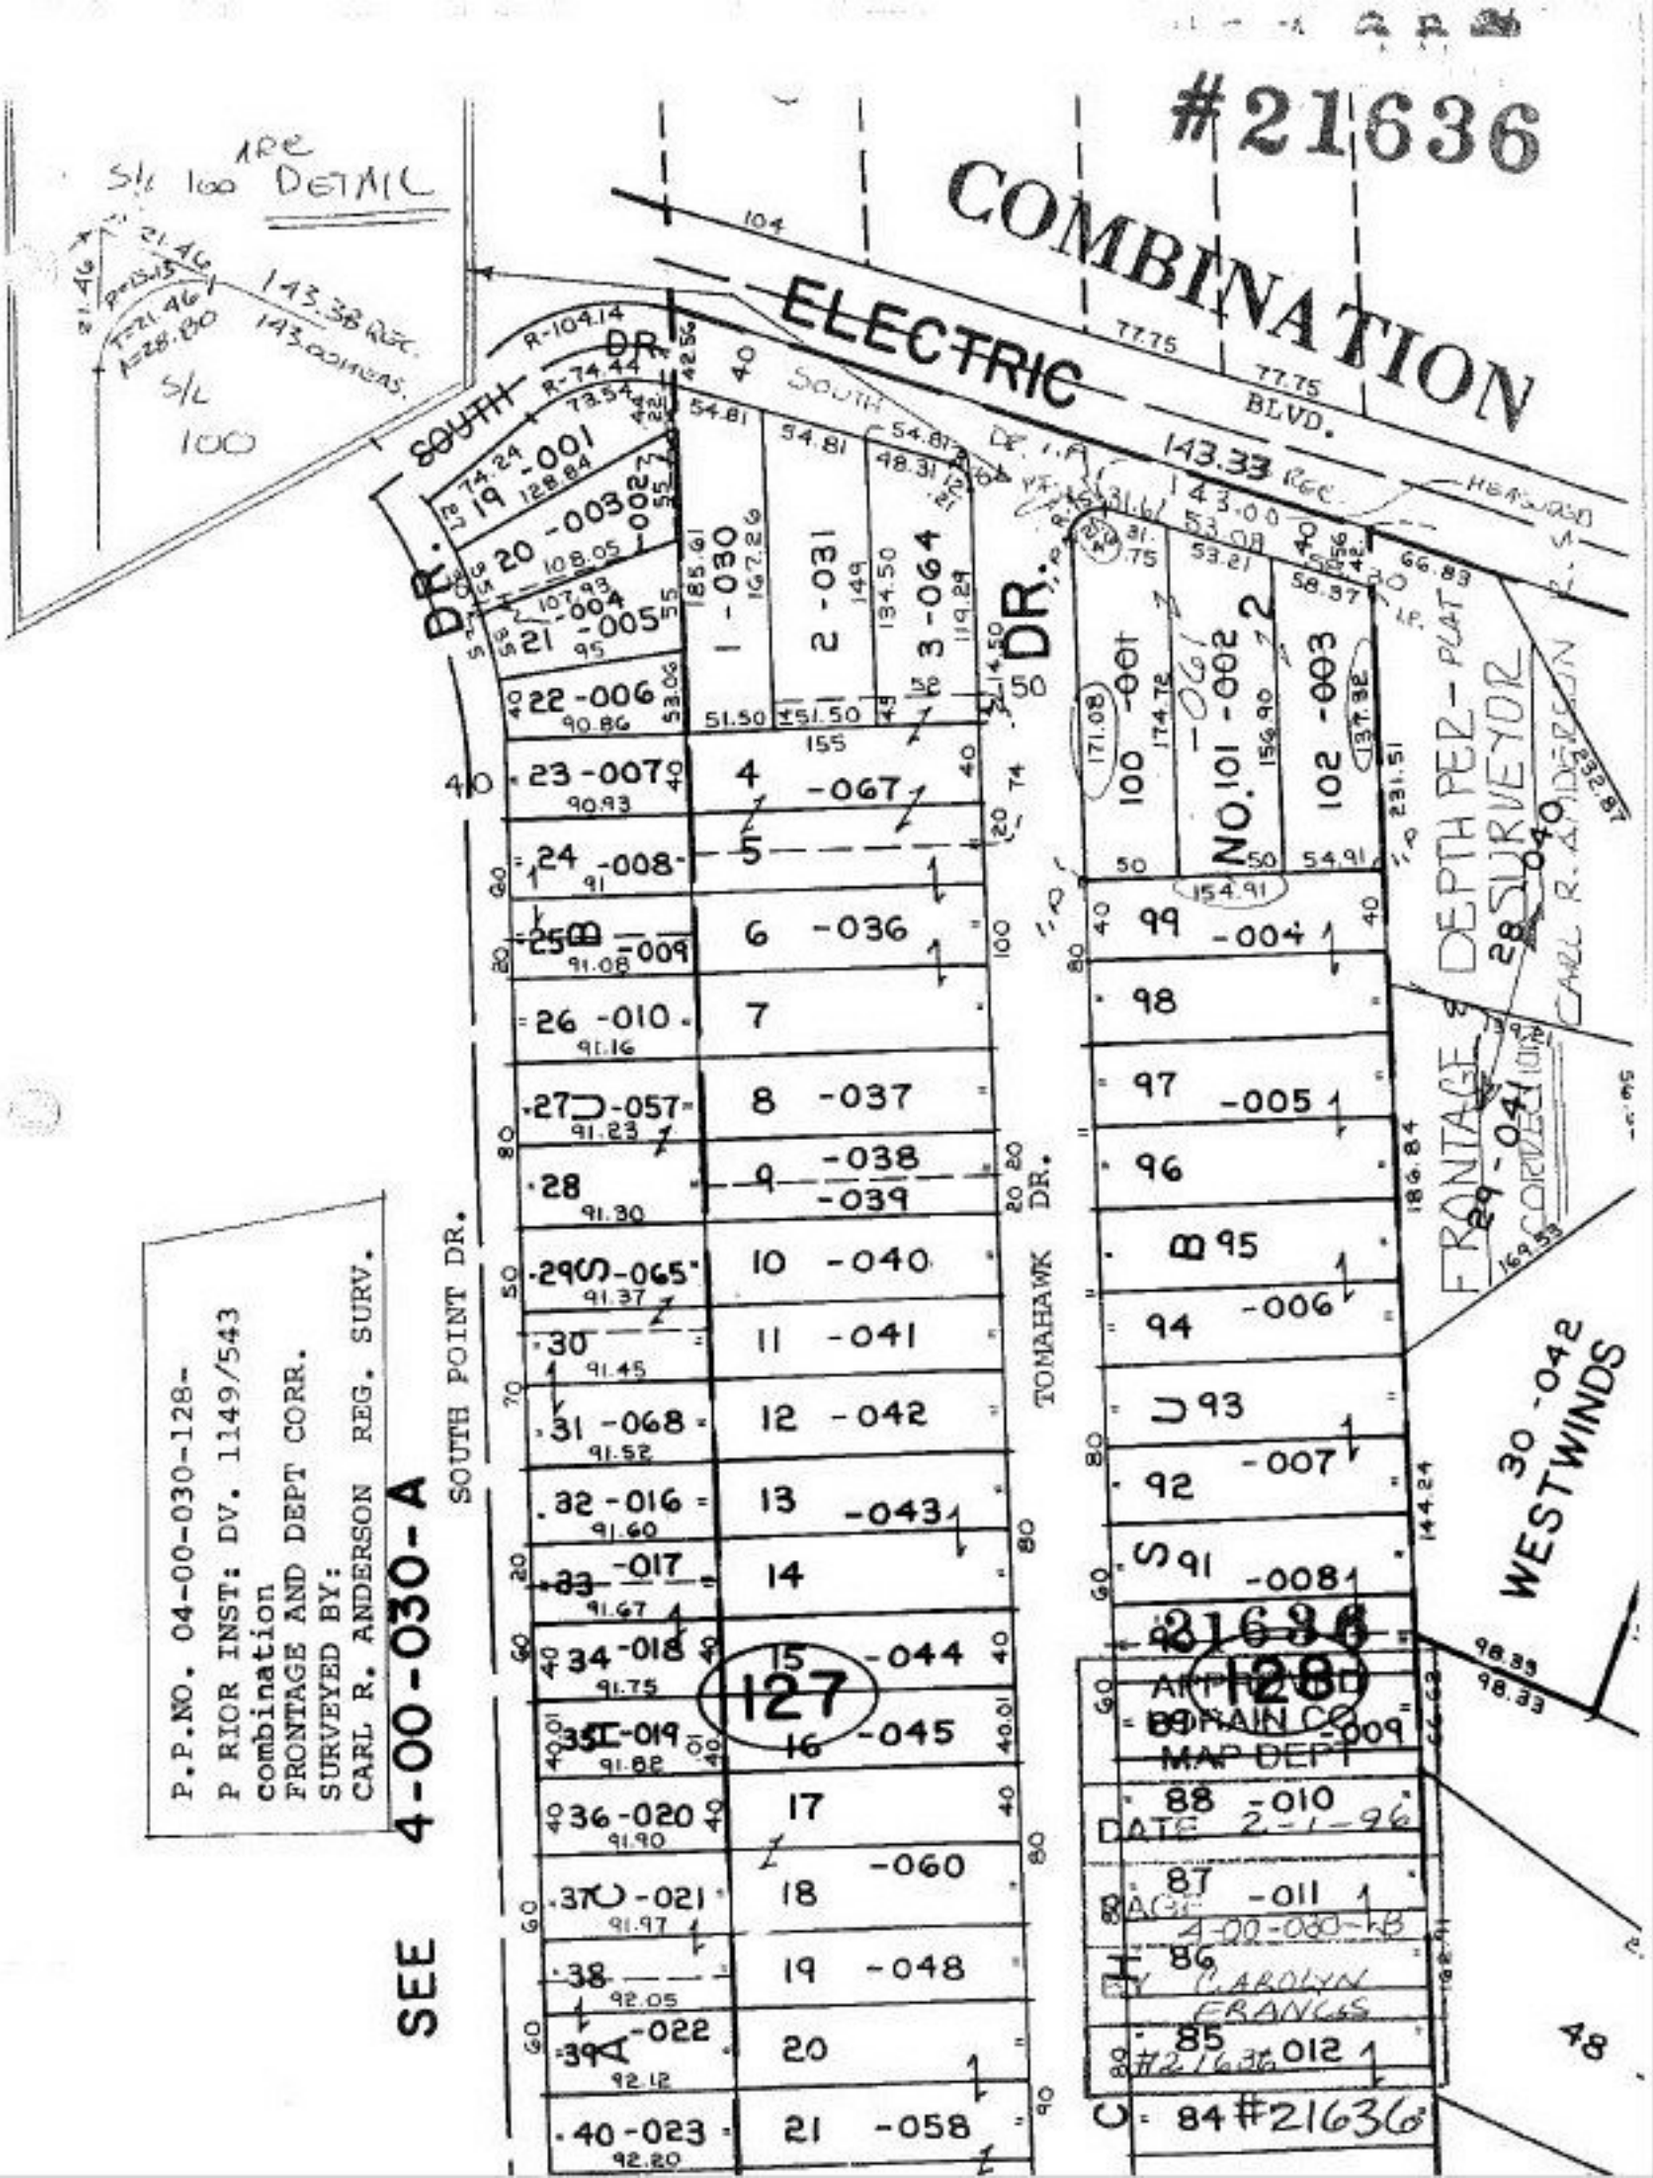
#21636
COMBINATION
ELECTRIC
BLVD.
143.33 REC.
SOUTH POINT DR.
TOMAHAWK DR.
DR.
SOUTH
S/L 100 DETAIL
143.38 REC.
143.00 MEAS.
R=104.14
R=74.44
T=21.46
A=28.80
P.P.NO. 04-00-030-128-
PRIOR INST: DV. 1149/543
combination
FRONTAGE AND DEPT CORR.
SURVEYED BY:
CARL R. ANDERSON REG. SURV.
4-00-030-A
SEE
FRONTAGE DEPTH PER PLAT
CARL R. ANDERSON
WESTWINDS
127
128
MAP DEPT
DATE 2-1-96
#21636
#21636012
#21636