#21637

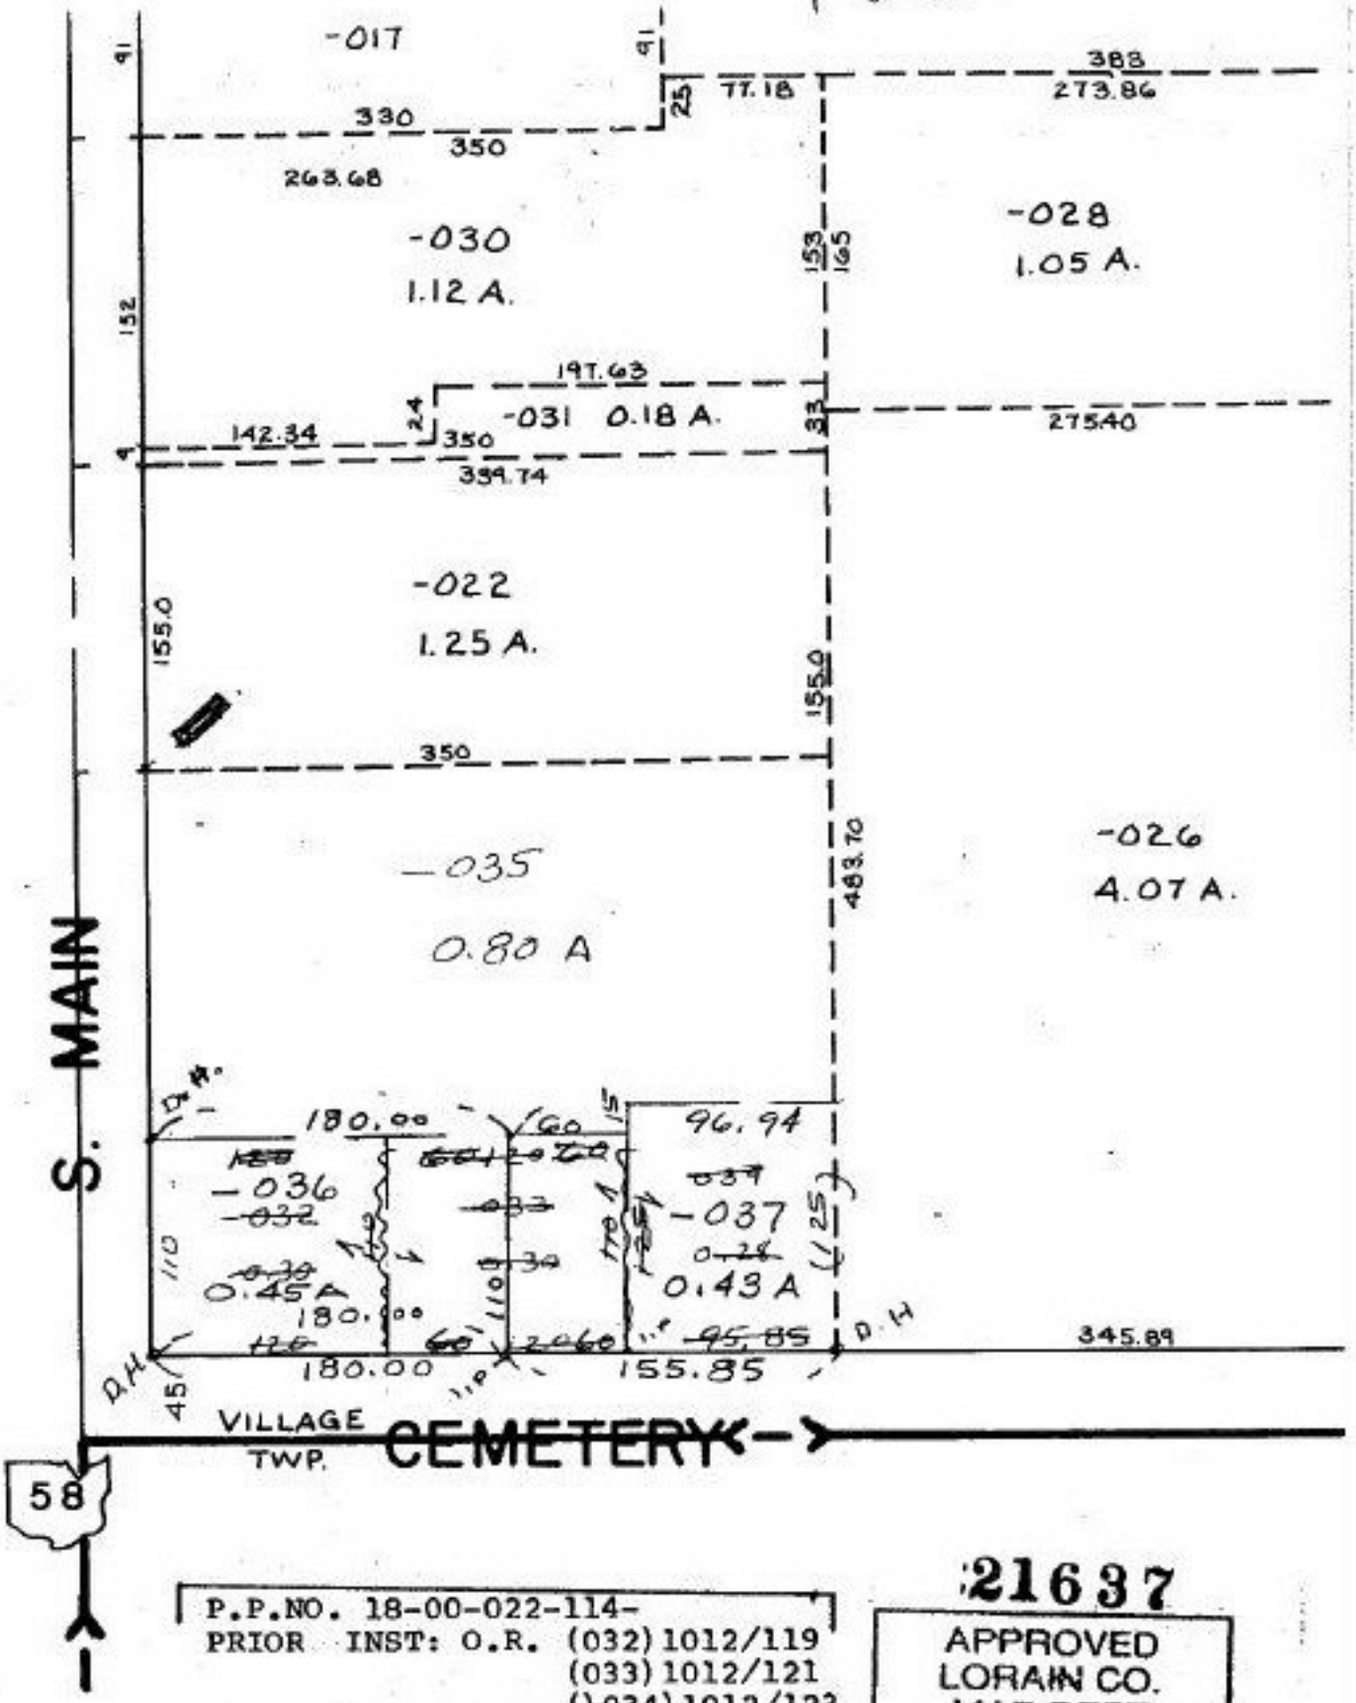

P.P.NO. 18-00-022-114-
PRIOR INST: O.R. (032) 1012/119
(033) 1012/121
(034) 1012/123
CLOSURE: 0.18:10,000
SURVEYED BY: CARL R. ANDERSON
P.S.

#21637

APPROVED
LORAIN CO.
MAP DEPT

DATE 1-23-96

PAGE 18-00-022

BY CAROLYN FRANCIS

#21637