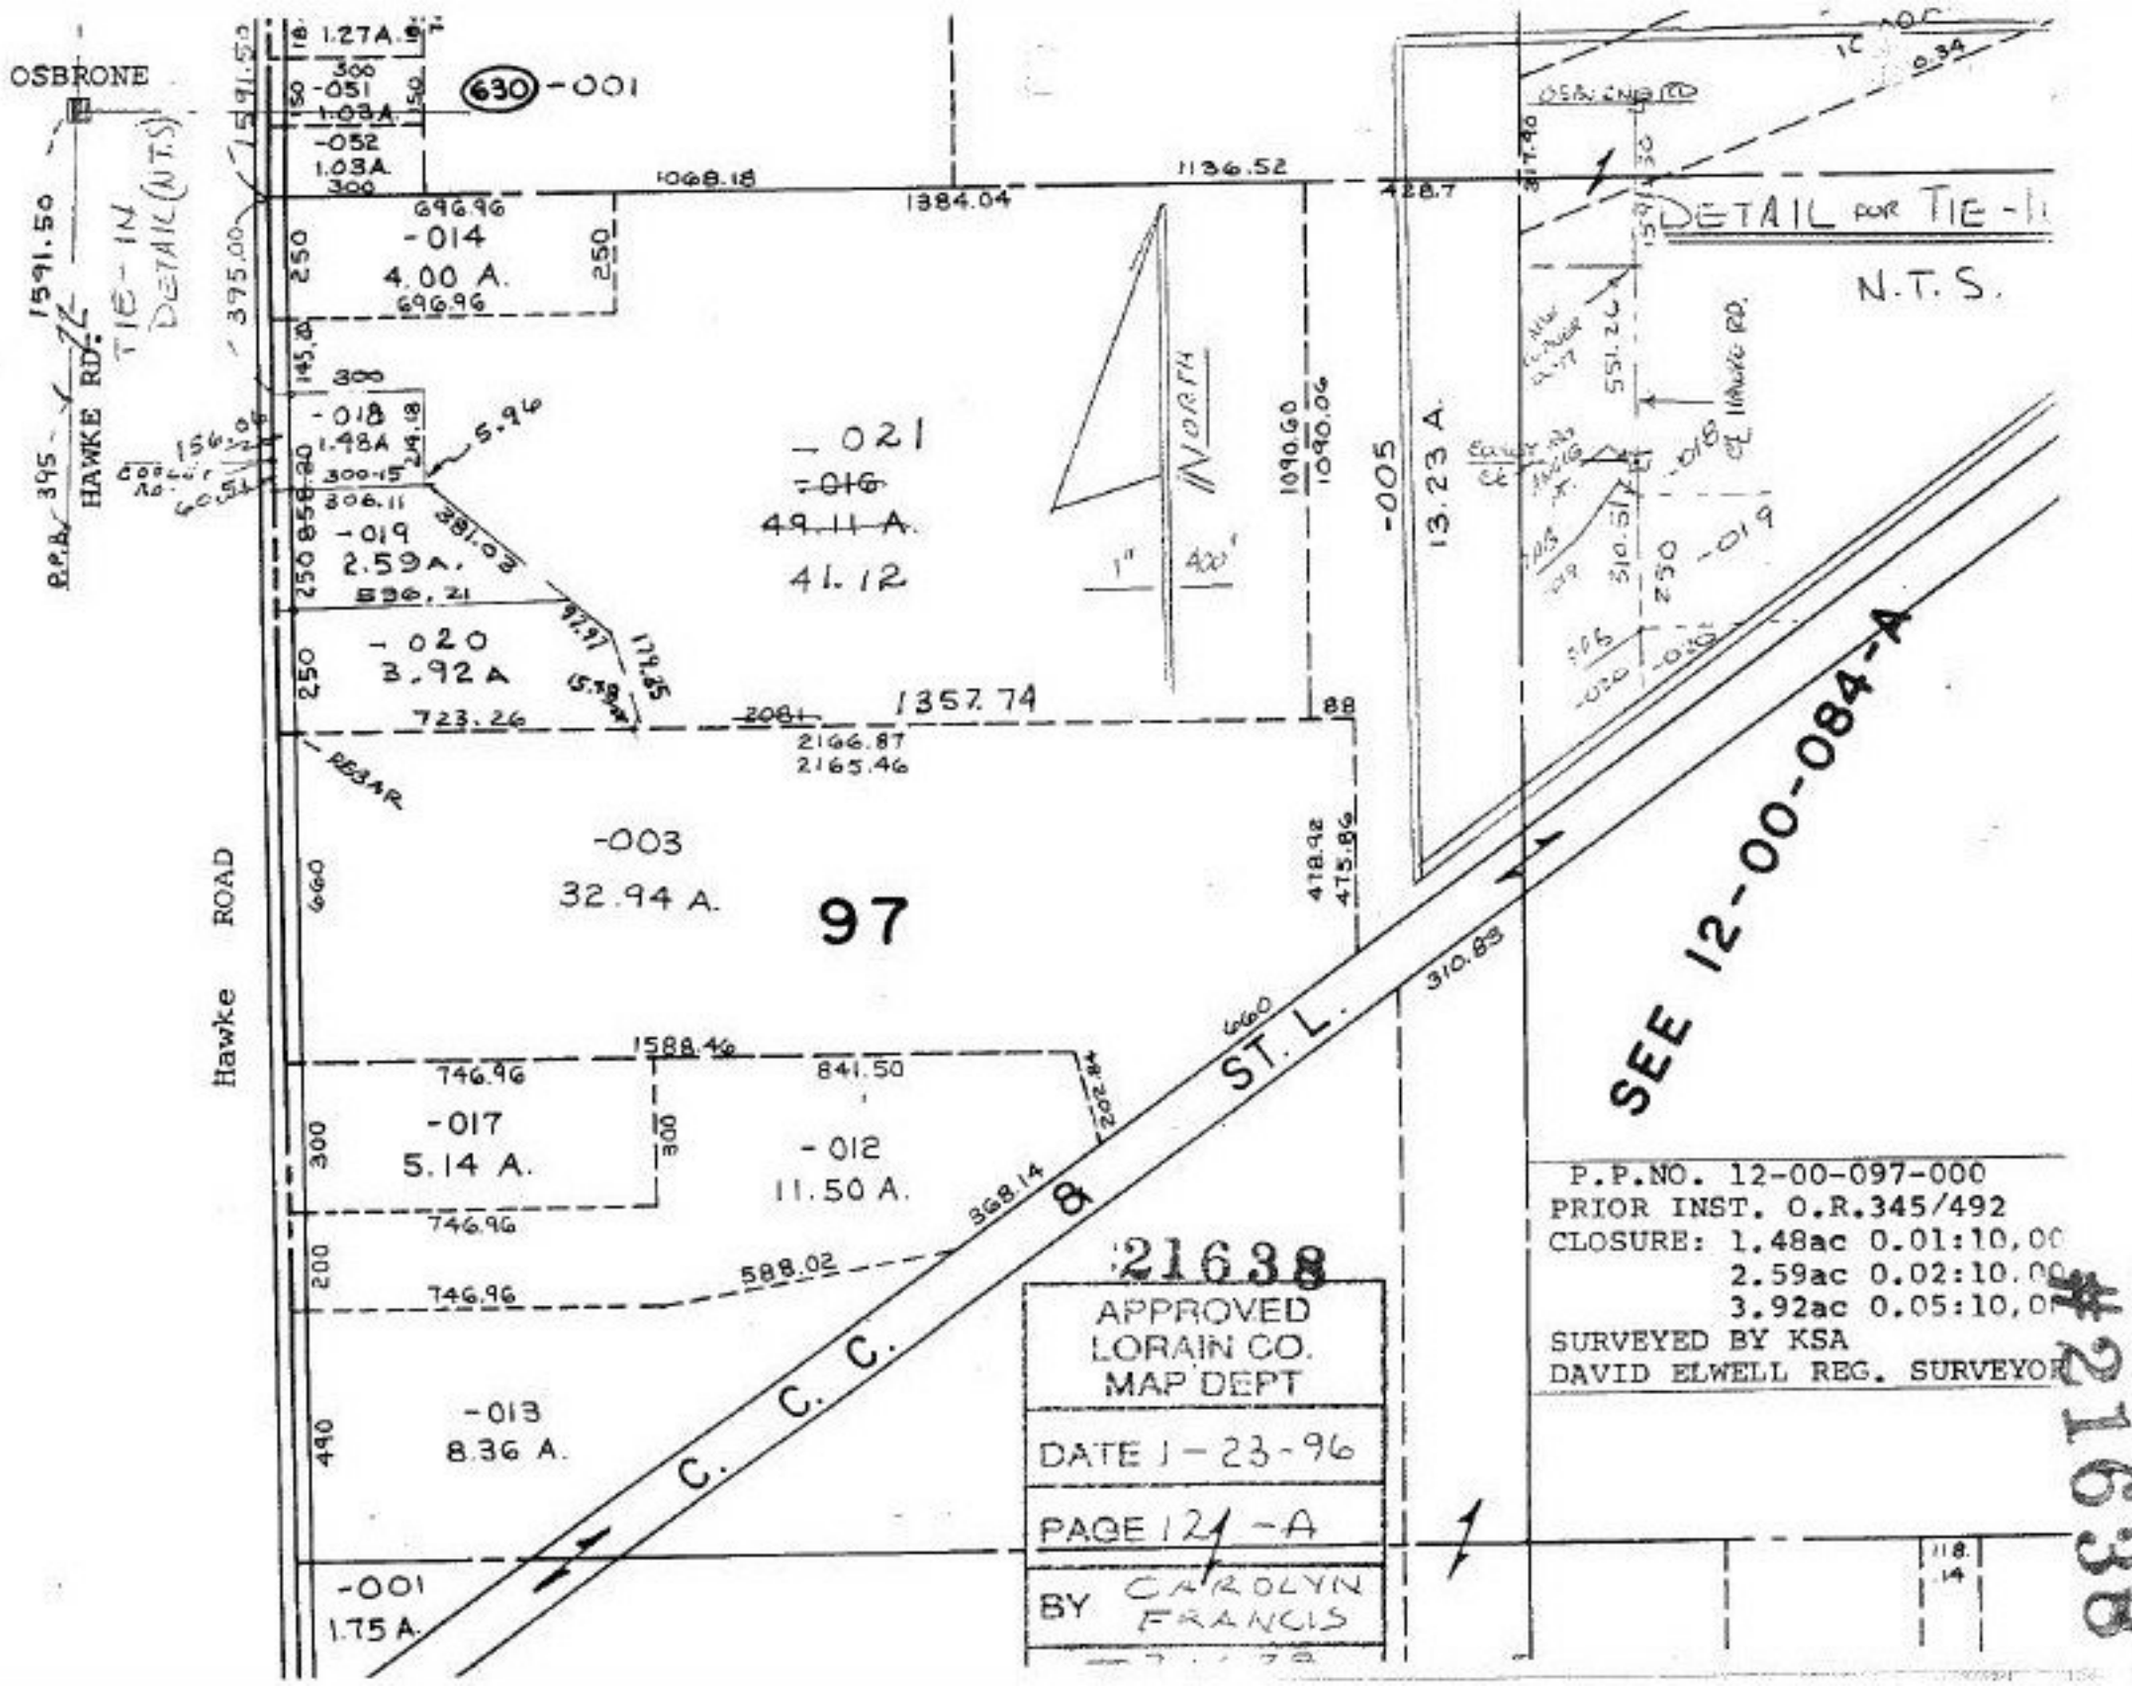
OSBRONE
1591.50
TIE-IN DETAIL (N.T.S.)
HAWKE RD.
630 -001
1.27A.
-051 1.03A.
-052 1.03A.
-014 4.00 A.
-018 1.48A.
-019 2.59A.
-020 3.92 A
-021
-016
49.11 A.
41.12
-003
32.94 A.
97
-017 5.14 A.
-012 11.50 A.
-013 8.36 A.
-001 1.75 A.
-005 13.23 A.
Hawke ROAD
C. C. C. & ST. L.
NORTH
1" 400'
DETAIL FOR TIE-IN
N.T.S.
SEE 12-00-084-A
P.P.NO. 12-00-097-000
PRIOR INST. O.R.345/492
CLOSURE: 1.48ac 0.01:10,00
2.59ac 0.02:10,00
3.92ac 0.05:10,0
SURVEYED BY KSA
DAVID ELWELL REG. SURVEYOR
21638
APPROVED
LORAIN CO.
MAP DEPT
DATE 1-23-96
PAGE 121-A
BY CAROLYN FRANCIS
21638 #12