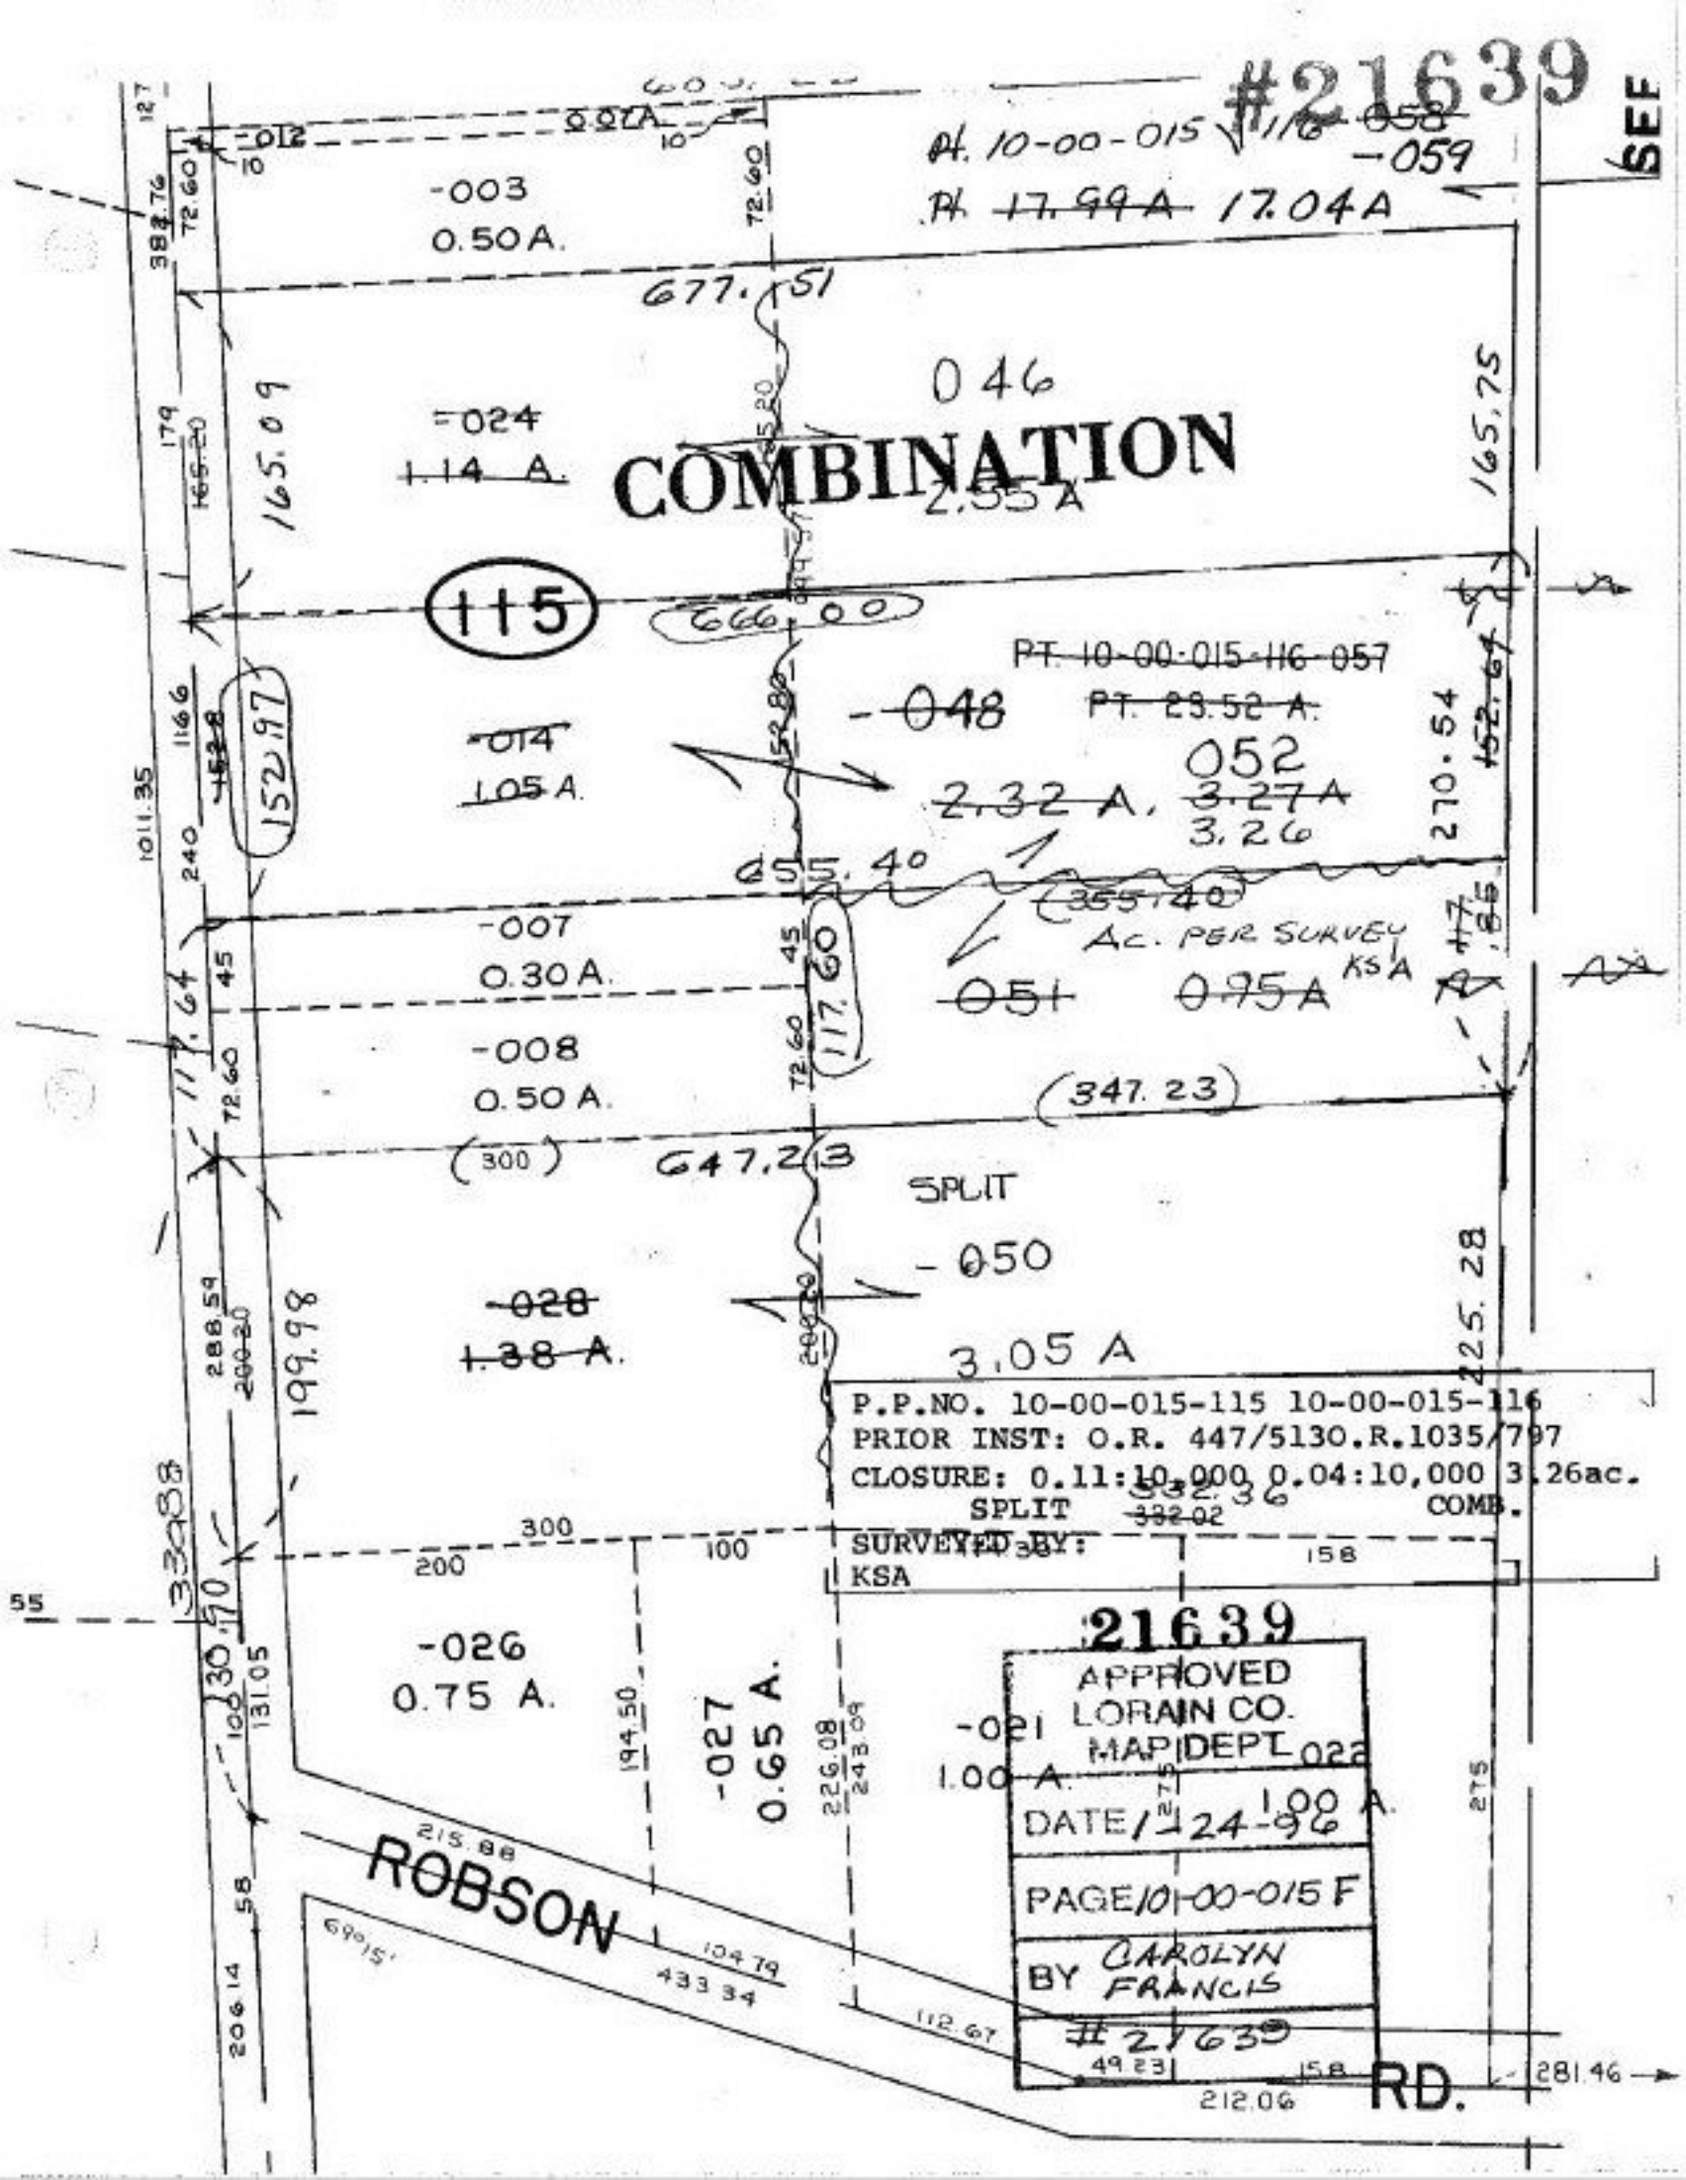
#21639
SEE
Pt. 10-00-015 116 058 -059
Pt. 17.99A 17.04A
-003
0.50A.
677.51
046
COMBINATION
2.55 A
-024
1.14 A.
115
666.00
PT. 10-00-015-116-057
PT. 23.52 A.
-048
052
2.32 A. 3.27A
3.26
-014
1.05 A.
355.40
AC. PER SURVEY KSA
-007
0.30 A.
051
0.75A
-008
0.50 A.
347.23
647.23
SPLIT
-050
3.05 A
-028
1.38 A.
P.P.NO. 10-00-015-115 10-00-015-116
PRIOR INST: O.R. 447/5130.R.1035/797
CLOSURE: 0.11:10,000 0.04:10,000 3.26ac.
SPLIT 332.36 332.02 COMB.
SURVEYED BY: KSA
-026
0.75 A.
-027
0.65 A.
-021
1.00 A.
21639
APPROVED
LORAIN CO.
MAP DEPT.
DATE 12-4-96
PAGE 10-00-015 F
BY CAROLYN FRANCIS
#21639
ROBSON
RD.