#21643

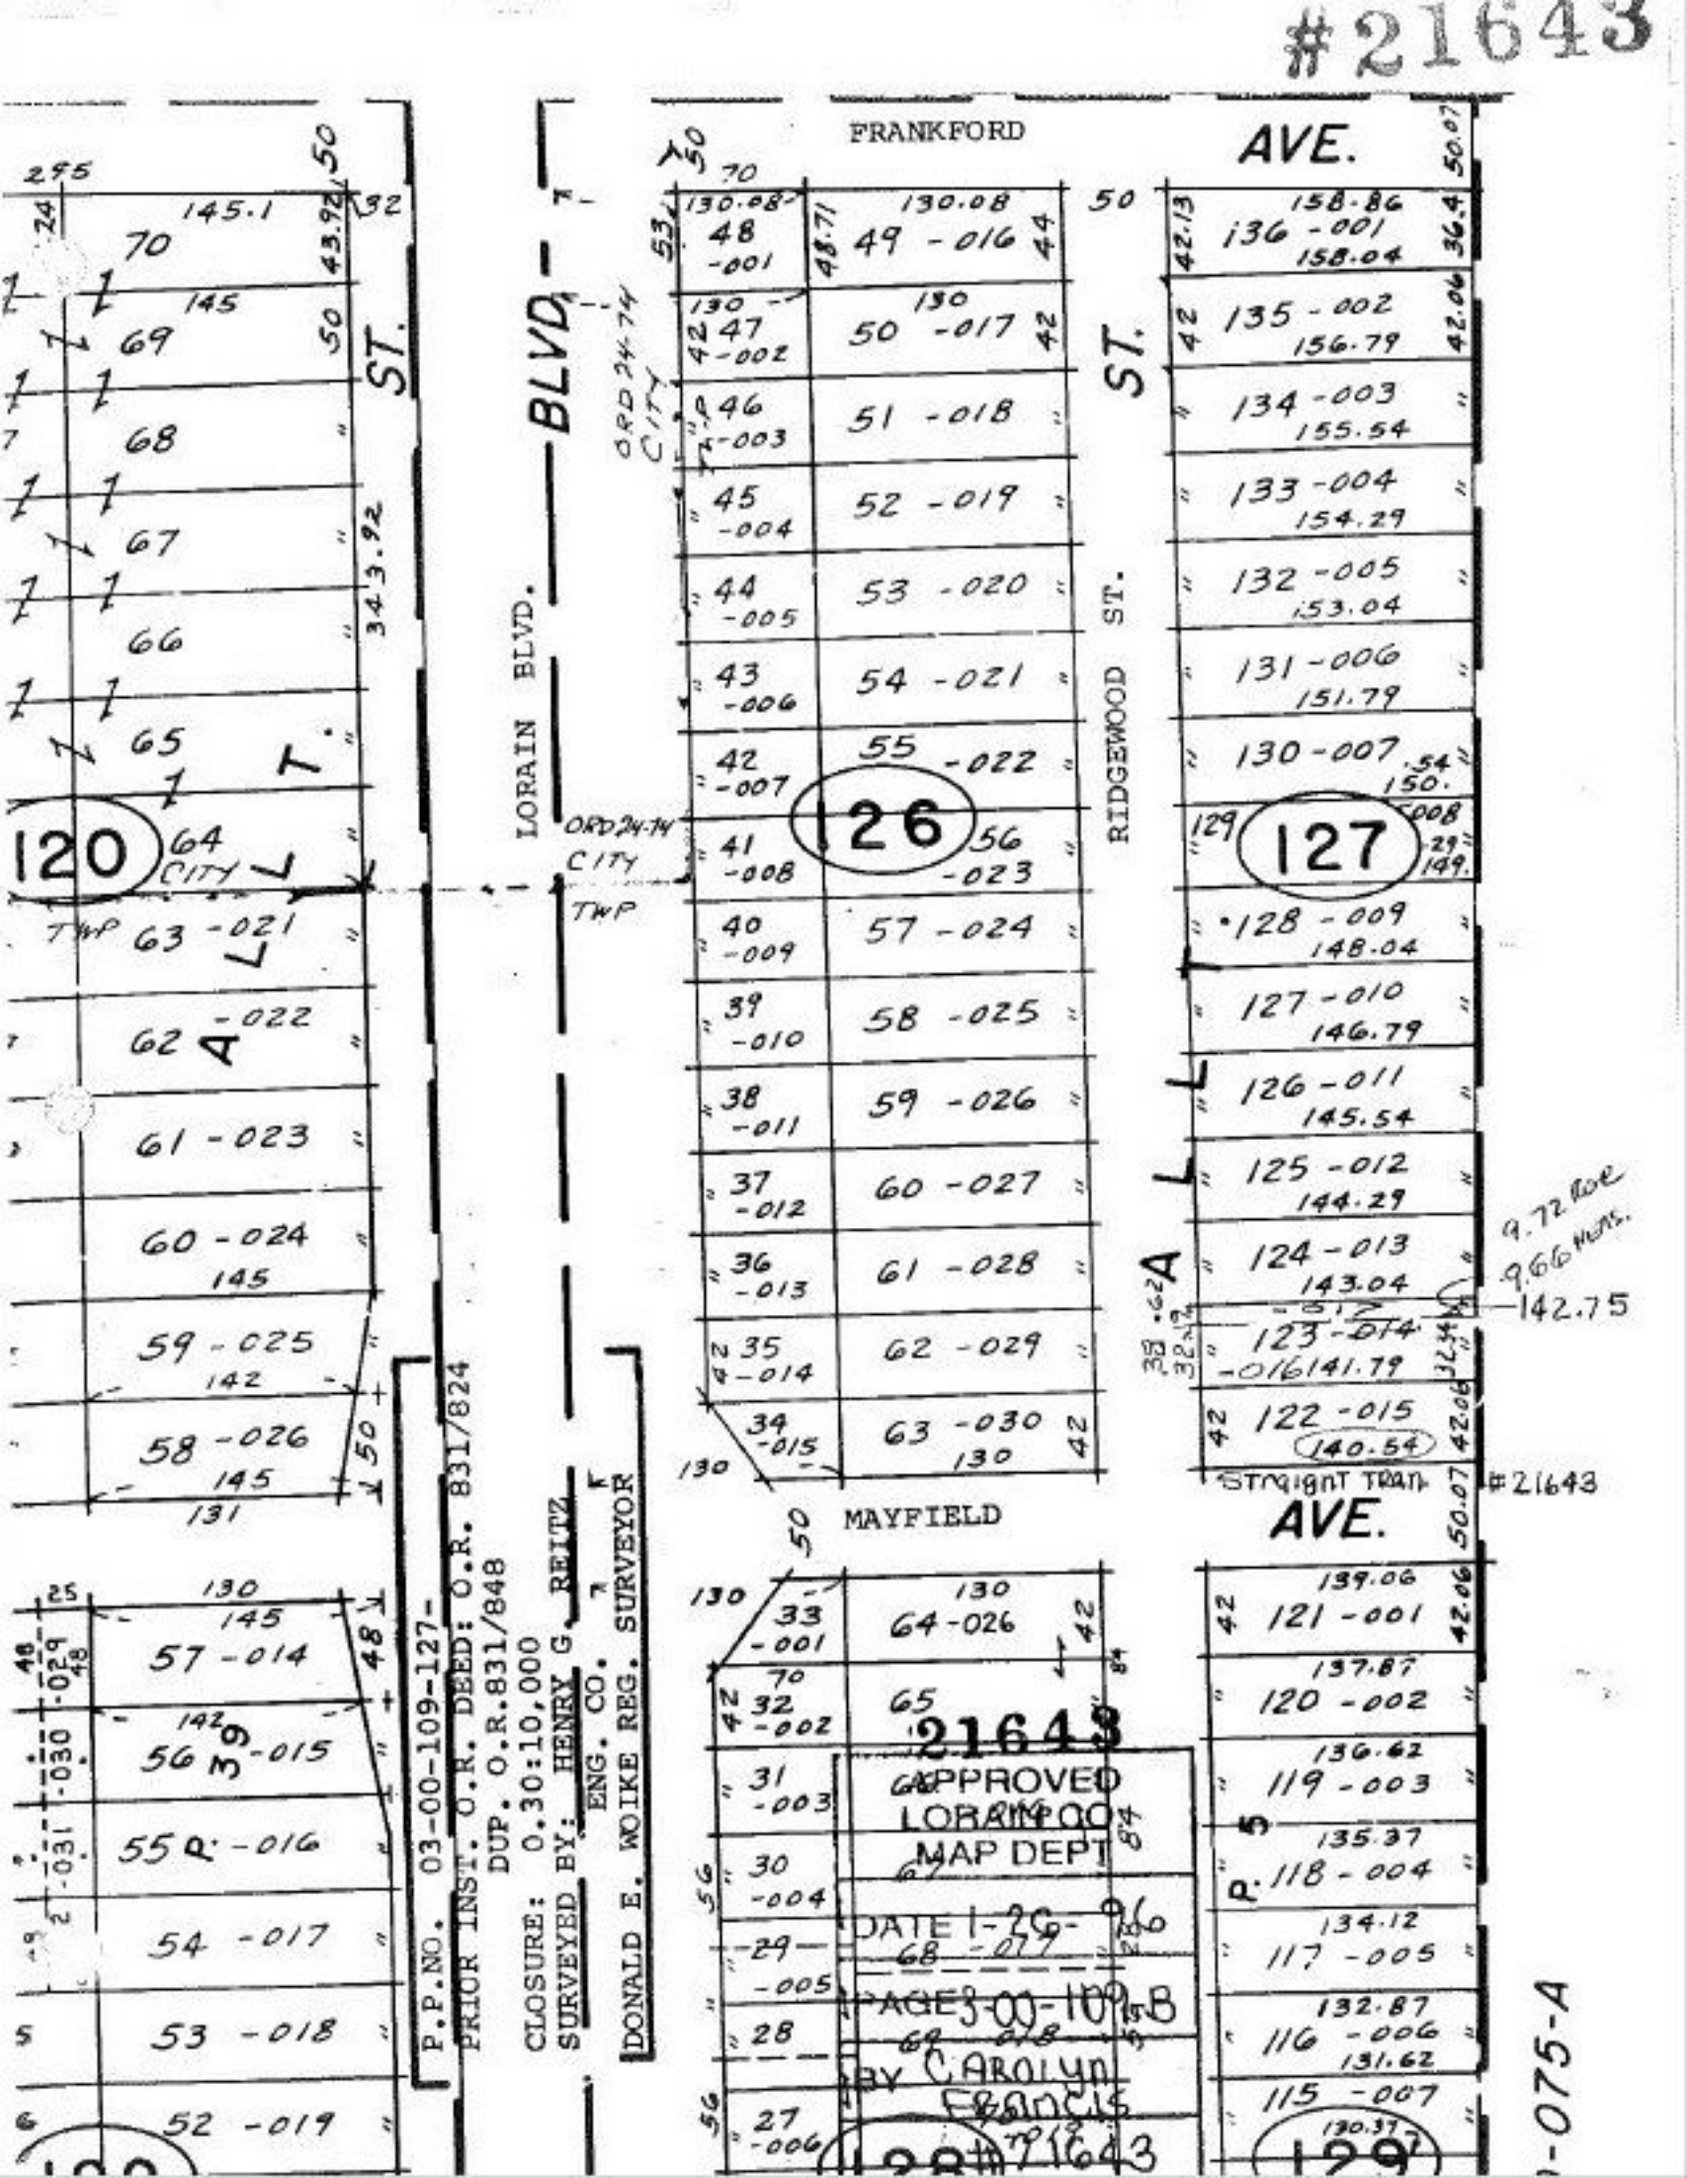

FRANKFORD
AVE.
MAYFIELD
AVE.
LORAIN BLVD.
BLVD.
RIDGEWOOD ST.
ST.
ALLT.
120
126
127
129
ORD 24-74 CITY
TWP
P.P.NO. 03-00-109-127-
PRIOR INST. O.R. DEED: O.R. 831/824
DUP. O.R.831/848
CLOSURE: 0.30:10,000
SURVEYED BY: HENRY G. REITZ
ENG. CO.
DONALD E. WOIKE REG. SURVEYOR
21643
APPROVED
LORAIN CO
MAP DEPT
DATE 1-26-96
PAGE 3-00-109-B
BY CAROLYN FRANCIS
#21643
Straight Tran
9.72 Roe
9.66 Meas.
142.75